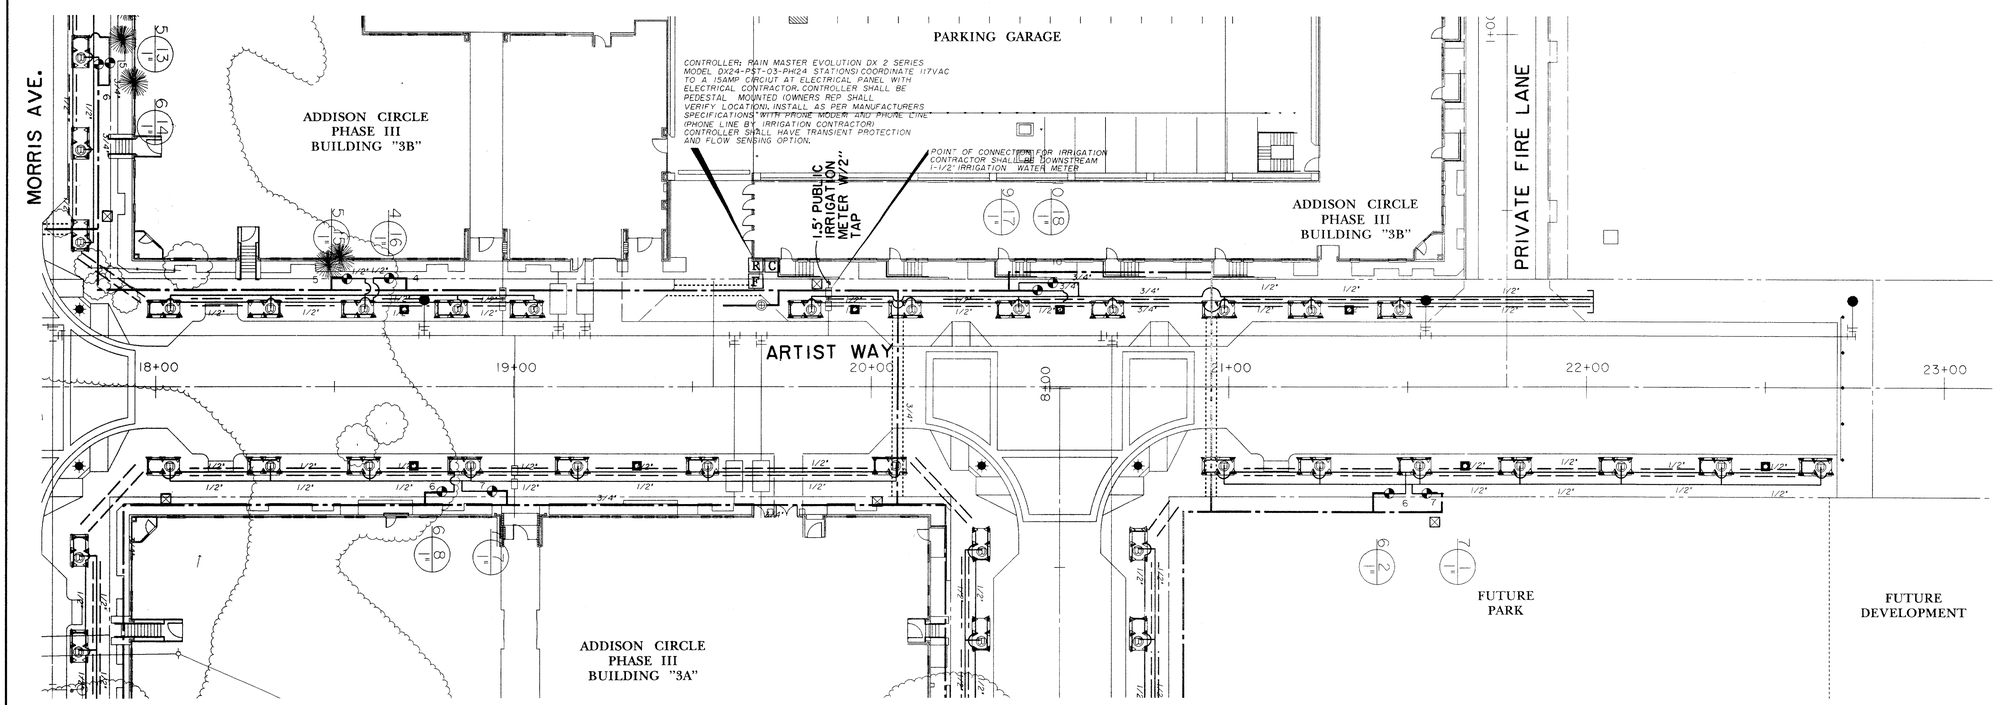

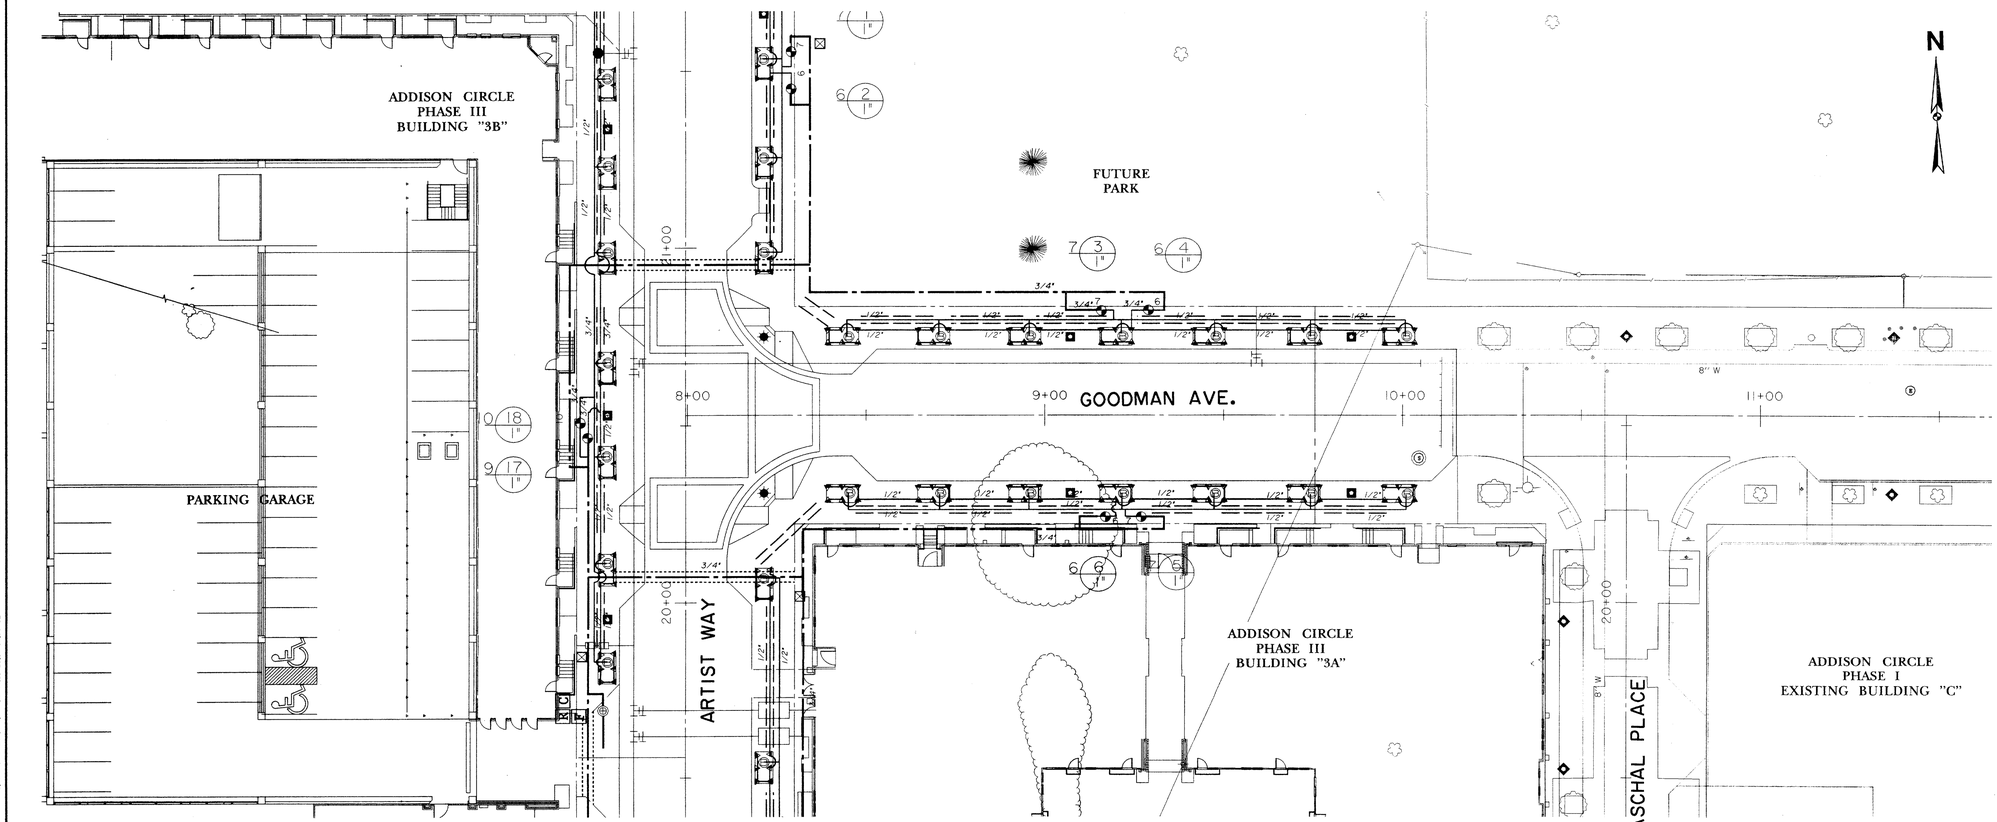

N

0 10 20 30 40
SCALE IN FEET

STATE OF TEXAS
STEPHEN C. BERKENBILE
LICENSED IRRIGATOR

STEPHEN C BERKENBILE & ASSOCIATES
IRRIGATION DESIGN CONSULTANTS
411 HYDE PARK PLACE
DUNCANVILLE, TX 75137
(972) 296-2724
FAX (972) 780-0048

RECORD DRAWING

BENCHMARKS:

BM#5
"□" CUT ON 8' INLET ON NORTH CURB LINE OF GOODMAN AVE. ±75' EAST OF PASCHAL PLACE.
ELEV. 629.98

BM#6
"□" CUT AT ℄ OF 8' INLET AT THE SOUTHWEST CORNER OF MORRIS AVE. AND WITT PLACE.
ELEV. 627.29

BM#7
"□" CUT AT WEST CORNER OF ADDISON THEATRE CENTRE PARKING LOT, SECOND ENTRANCE NORTH OF ADDISON RD.
ELEV. 637.66

DATE	DESCRIPTION	REF NO.
6/23/99	ISSUED FOR CONSTRUCTION	N/A
5/17/99	ISSUED FOR BID	N/A

IRRIGATION PLAN
ARTIST WAY & GOODMAN AVE.

ADDISON CIRCLE
PHASE II-B PUBLIC INFRASTRUCTURE

TOWN OF ADDISON, TEXAS

Huitt - Zollars, Inc.
3131 Mckinney Ave., Suite 600, Dallas, TX 75204
Phone (214) 871-3311/Fax (214) 871-0757

DESIGN	DRAWN	APPR.	SCALE	DATE	PROJECT NO.	NO.
HZI	HZI	SCB	1"=20'	MAR. 99	01-1822-50	IR2

h:\proj\01182250\dgn\AUC3IR02.DGN

B: AUC3BD.DGN; 2-3,8,13,15,20,22-29,32-39,41-52,55-61
PL: AUC3BASE.DGN; 1-3,5,7,10-14,17,18,20,22-24,28,44,49
US: AUC3UTIL.DGN; 1-3,5-10,14-18,20-29,31-34,36-62
UL: AUC3UTIL.DGN; 1,22
TZ: AUC3CONT.DGN; 1-3,5-10,14-18,20-29,31-34,36-62
T3: AUC3TOPO.DGN; 1-3,5-10,14-18,20-29,31-34,36-62
T4: AUC3CONT.DGN; 1-3,5-10,14-18,20-29,31-34,36-62
US: AUC3UTIL.DGN; 1-3,5-10,14-18,20-29,31-34,36-62
PL: AUC3BASE.DGN; 1-3,5,8,10-14,17,18,20,22-24,44,49
IRRI: IRRIBASE.DGN; 3-63
PRF INSTALLISDN-3800000
FI: NONE=BASE file
Ph:\proj\01182250\dgn\AUC3IR02.DGN
Fri Dec 8 14:50:58 2000
Version 8.05.03 [3800]
Huitt-Zollars, Inc.