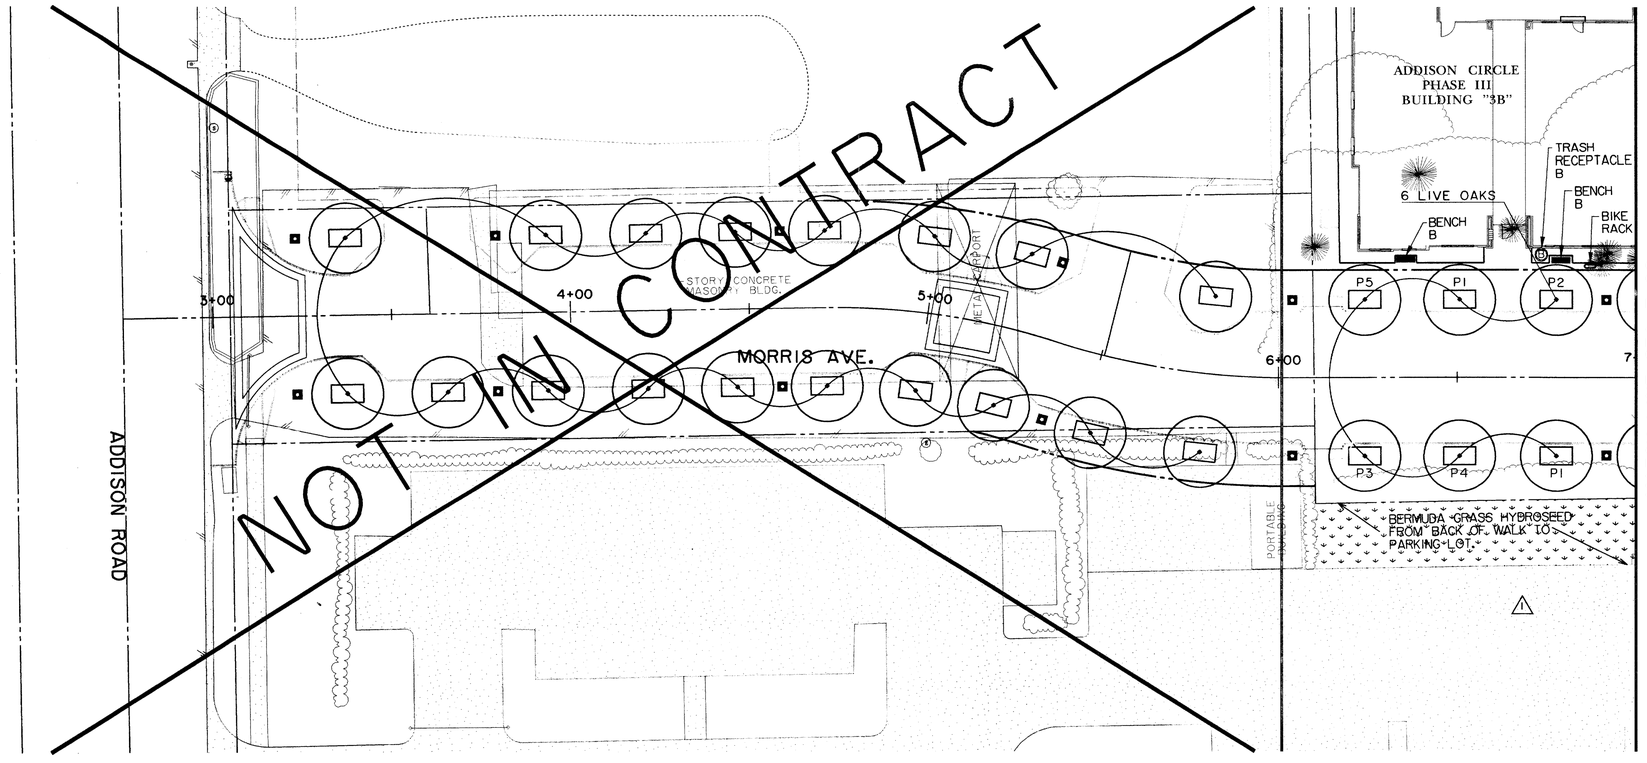

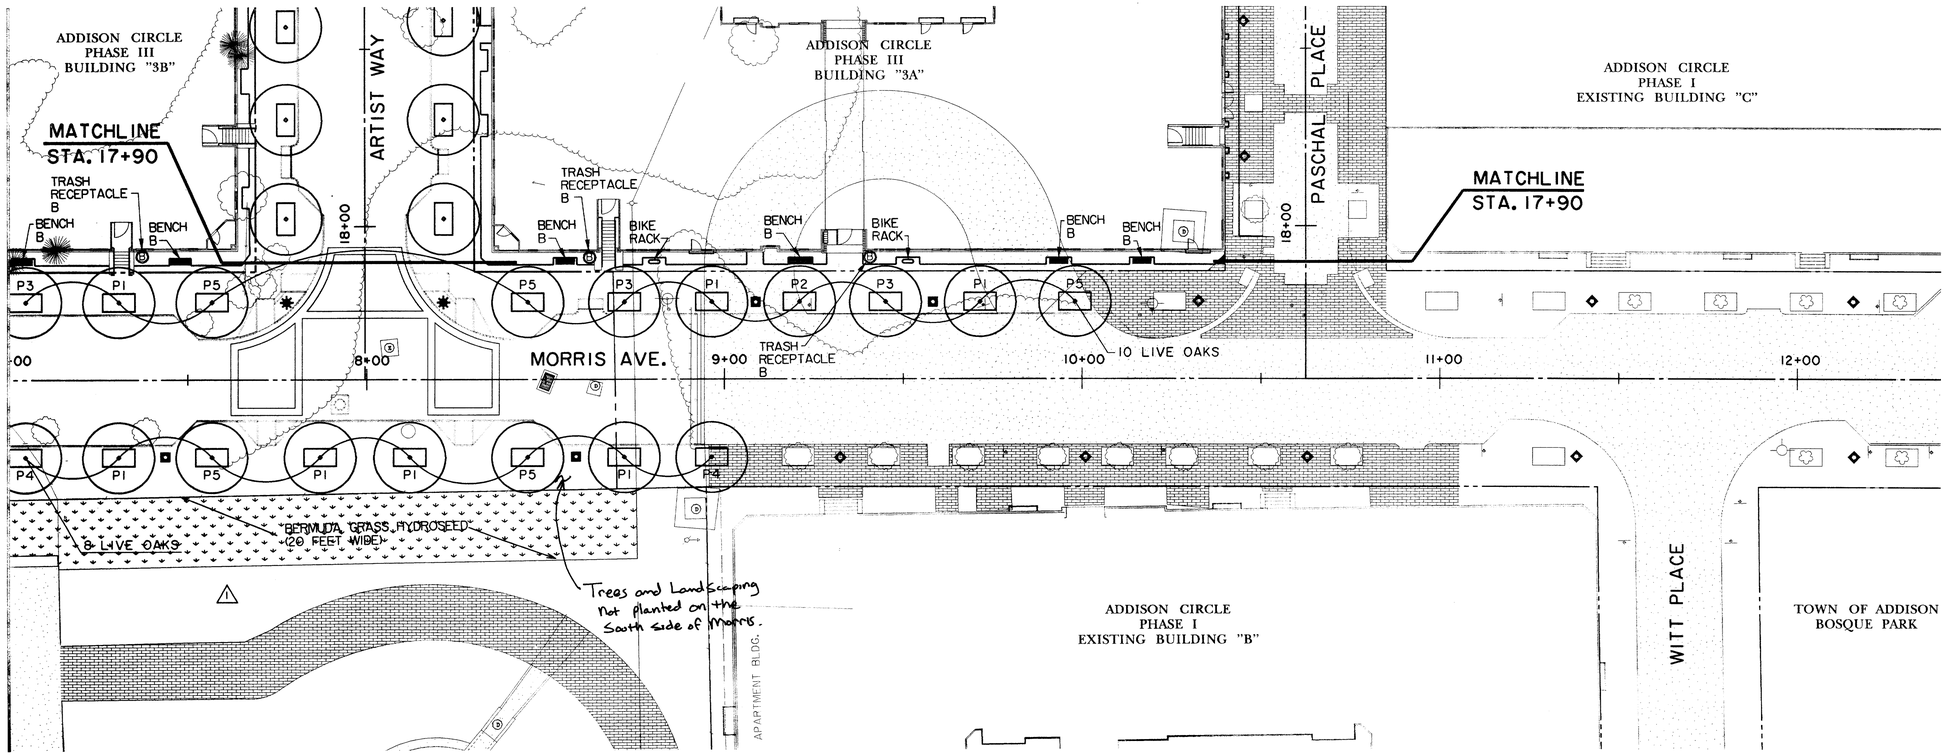

N

0 10 20 30 40
SCALE IN FEET

RECORD DRAWING

THE SEAL APPEARING ON THIS DOCUMENT WAS AUTHORIZED BY KAREN W. KOERTH, L.A. 1594

STATE OF TEXAS · KAREN W. KOERTH · 1594 · REGISTERED LANDSCAPE ARCHITECT

DATE	DESCRIPTION	REF NO.
6/23/99	ISSUED FOR CONSTRUCTION	N/A
6/2/99	ADDENDUM #1	1
5/17/99	ISSUED FOR BID	N/A

PLANTING & FURNITURE PLAN
MORRIS AVENUE

ADDISON CIRCLE
PHASE II-B PUBLIC INFRASTRUCTURE

TOWN OF ADDISON, TEXAS

Huitt - Zollars, Inc.
3131 Mckinney Ave., Suite 600, Dallas, TX 75204
Phone (214) 871-3311/Fax (214) 871-0757

DESIGN	DRAWN	APPR.	SCALE	DATE	PROJECT NO.	NO.
HZI	HZI	DEM	H: 1"=20' V: 1"=6'	MAR. 99	01-1822-50	PFI

h:\proj\01182250\dgn\AUC3LS11.DGN

R: AUC3D3.DGN, 3-3A,13,16,8,23-29,32-34,37-39,43-53,55-61
F1: AUC3TOPO.DGN, 1-12,14-29,31-34,36-42
T1: AUC3TOPO.DGN, 1-12,14-29,31-34,36-42
U2: AUC3UTIL.DGN
T4: AUC3UTIL.DGN, 1-10,14-29,31-34,36-40,43-57,59-62
PS: HORIZ=1"=20', 1-3,5,6,10-11,13,25,43-49
P3: AUC3TOPO.DGN, 1-12,14-29,31-34,36-42
U2: AUC3UTIL.DGN
T4: AUC3UTIL.DGN, 1-10,14-29,31-34,36-40,43-57,59-62
PRF ROTATION=90.3250000
F1:\ISR\MILLER.TBL
P1: \\DALLAS2\DISK01\PROJECTS\01182250\dgn\AUC3LS11.DGN
F1: \\DALLAS2\DISK01\PROJECTS\01182250\dgn\AUC3TOPO.DGN
T1: \\DALLAS2\DISK01\PROJECTS\01182250\dgn\AUC3TOPO.DGN
U2: \\DALLAS2\DISK01\PROJECTS\01182250\dgn\AUC3UTIL.DGN
T4: \\DALLAS2\DISK01\PROJECTS\01182250\dgn\AUC3UTIL.DGN
Huitt-Zollars, Inc.