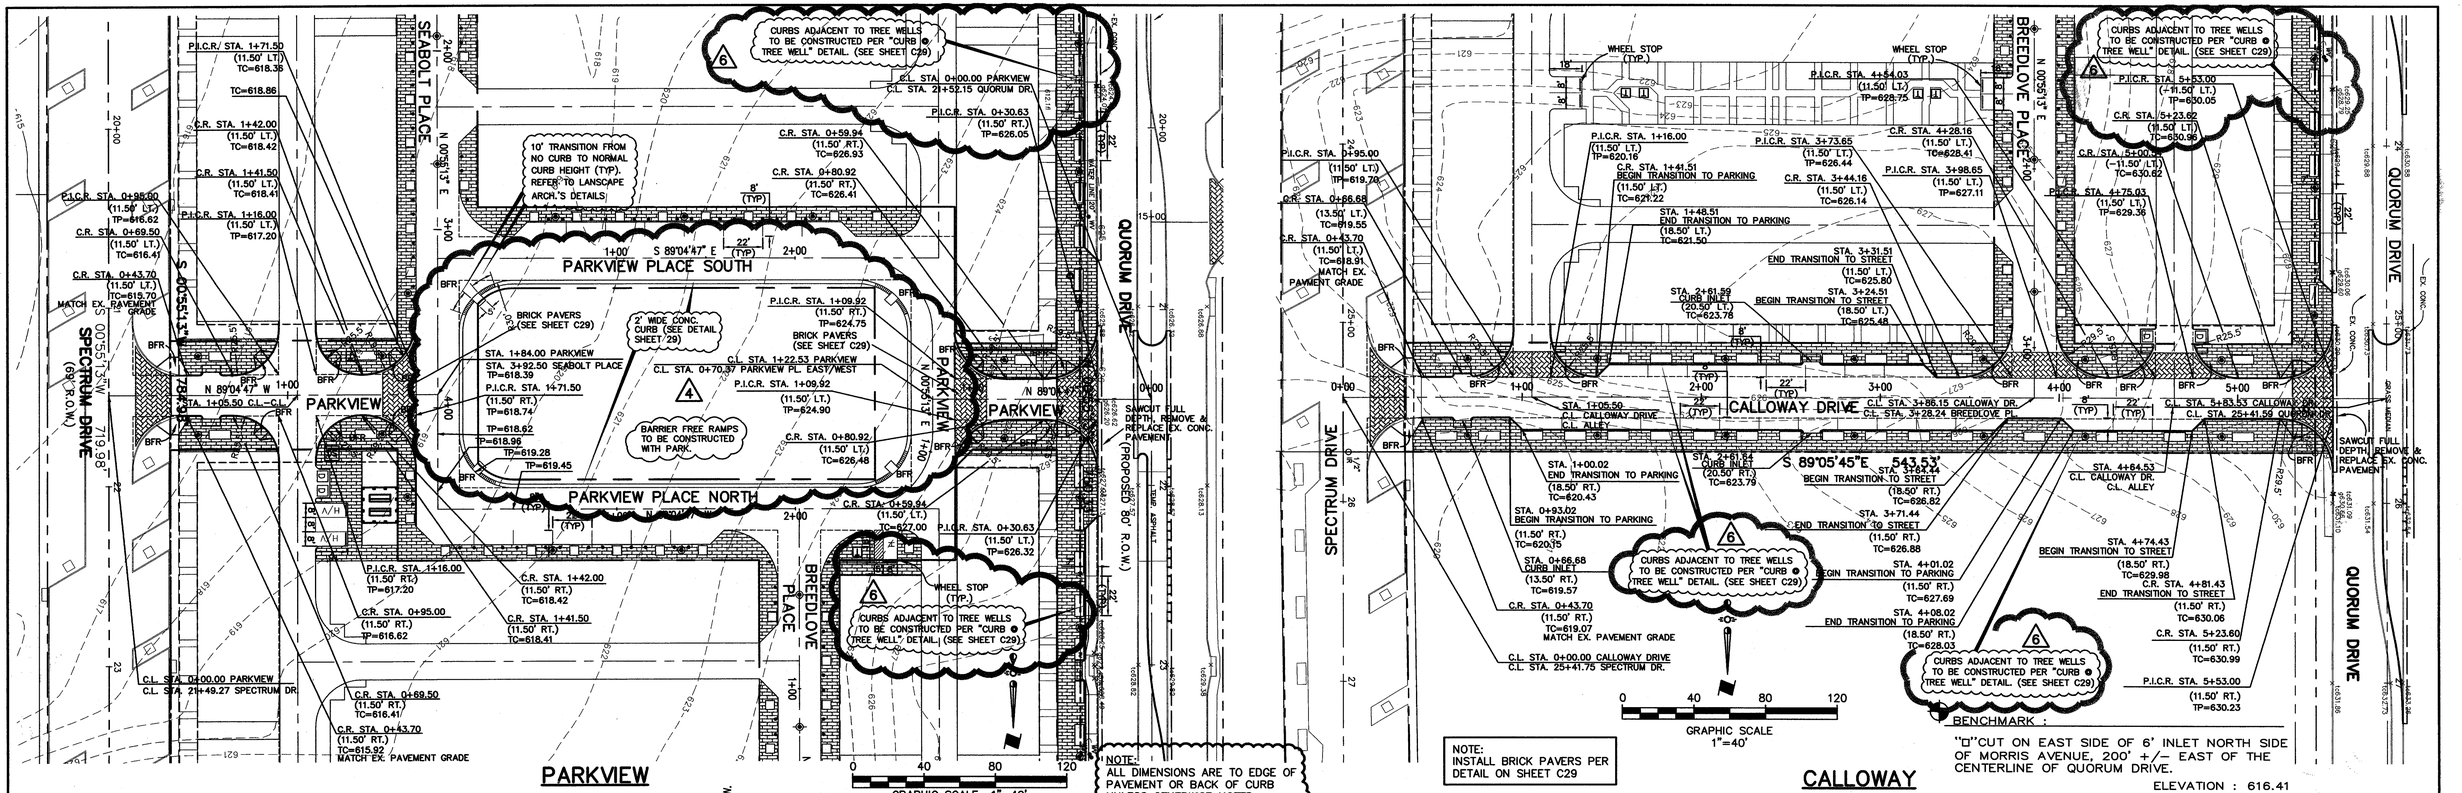

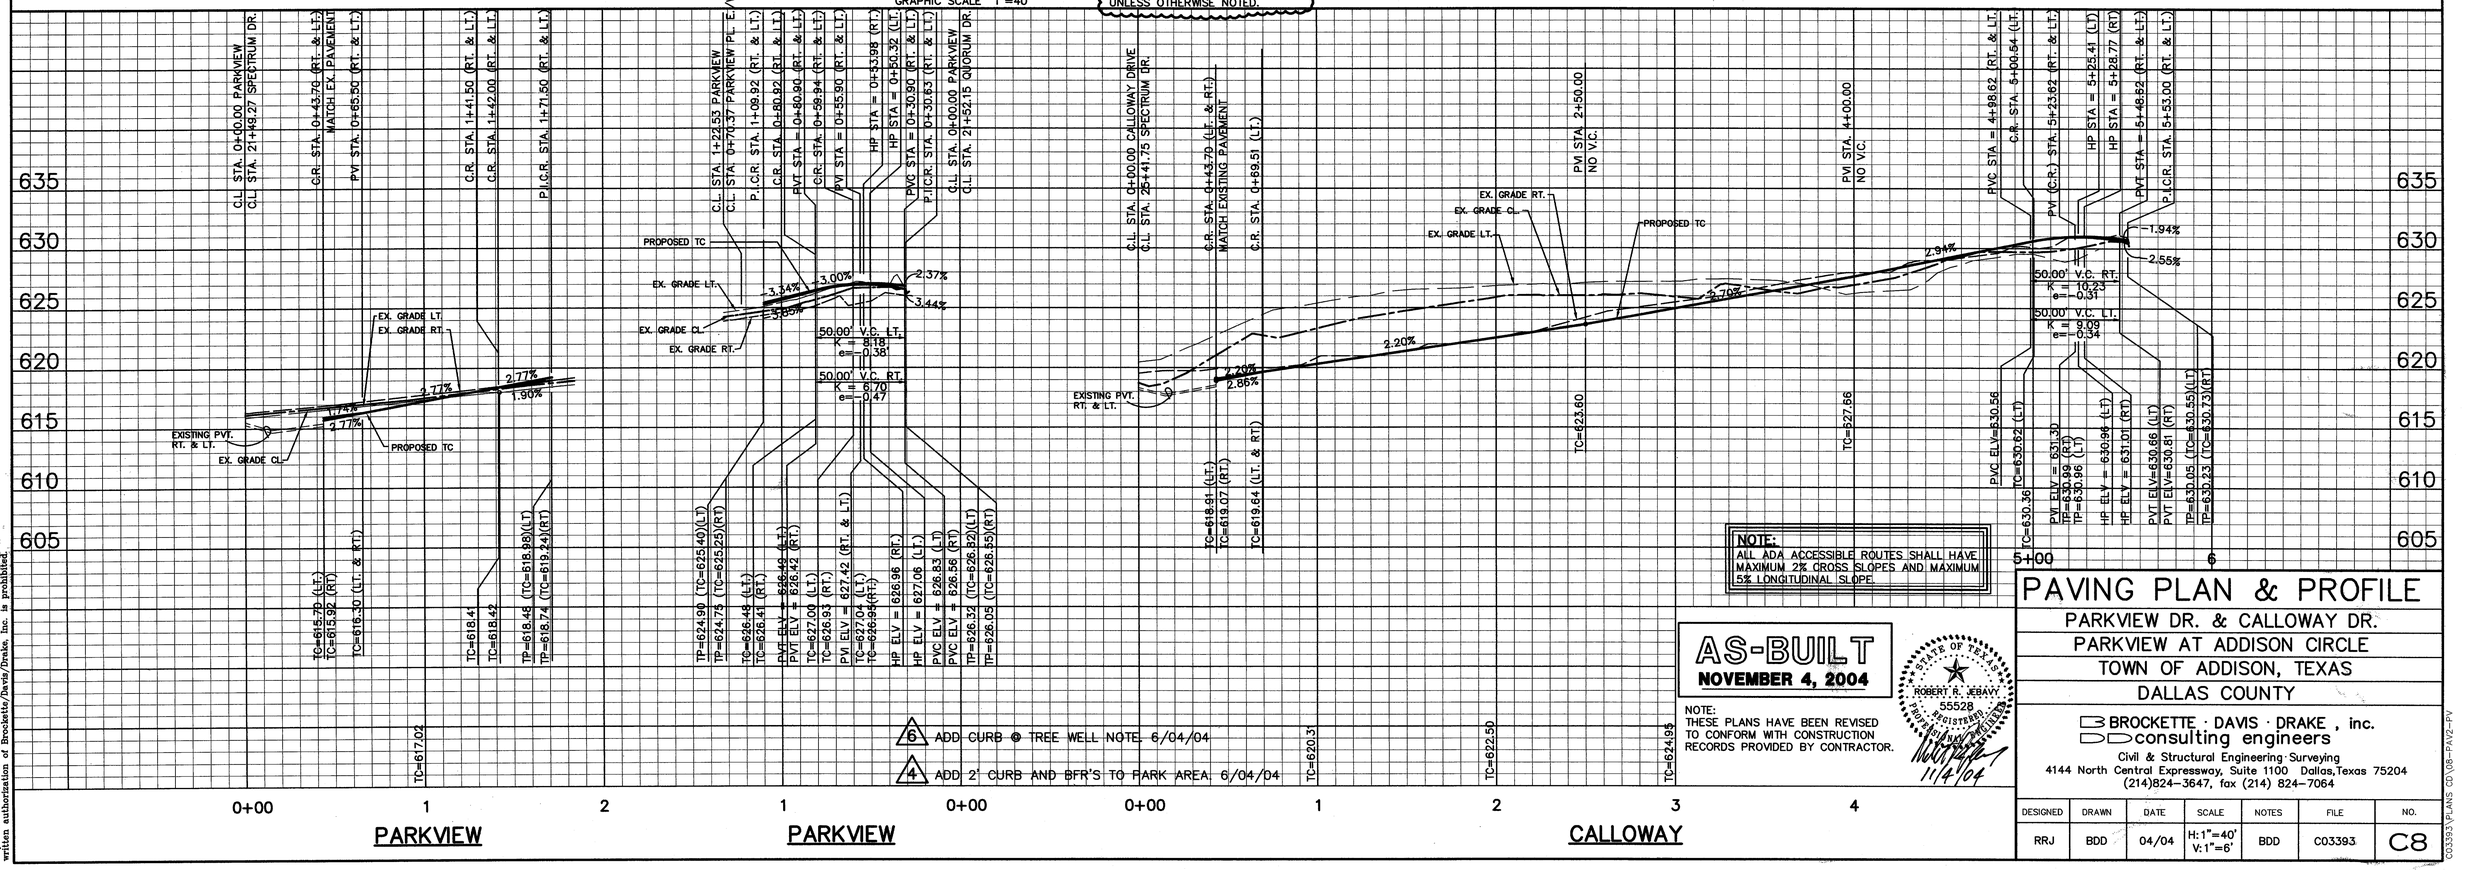

©Copyright 2003 Brockette/Davis/Drake, Inc. All Rights Reserved.
This drawing is the property of Brockette/Davis/Drake, Inc.
and is not to be used in whole or in part for any purpose.
Any modification or use of this drawing without the express
written authorization of Brockette/Davis/Drake, Inc. is prohibited.

AS-BUILT
NOVEMBER 4, 2004

NOTE:
THESE PLANS HAVE BEEN REVISED TO CONFORM WITH CONSTRUCTION RECORDS PROVIDED BY CONTRACTOR.

STATE OF TEXAS
ROBERT R. KRAVY
55528
REGISTERED
PROFESSIONAL ENGINEER
11/4/04

PAVING PLAN & PROFILE

PARKVIEW DR. & CALLOWAY DR.
PARKVIEW AT ADDISON CIRCLE
TOWN OF ADDISON, TEXAS
DALLAS COUNTY

BROCKETTE · DAVIS · DRAKE , inc.
consulting engineers
Civil & Structural Engineering · Surveying
4144 North Central Expressway, Suite 1100 Dallas, Texas 75204
(214)824-3647, fax (214) 824-7064

DESIGNED	DRAWN	DATE	SCALE	NOTES	FILE	NO.
RRJ	BDD	04/04	H: 1"=40' V: 1"=6'	BDD	C03393	C8

C03393\PLANS CD\C8-PAVE-PV