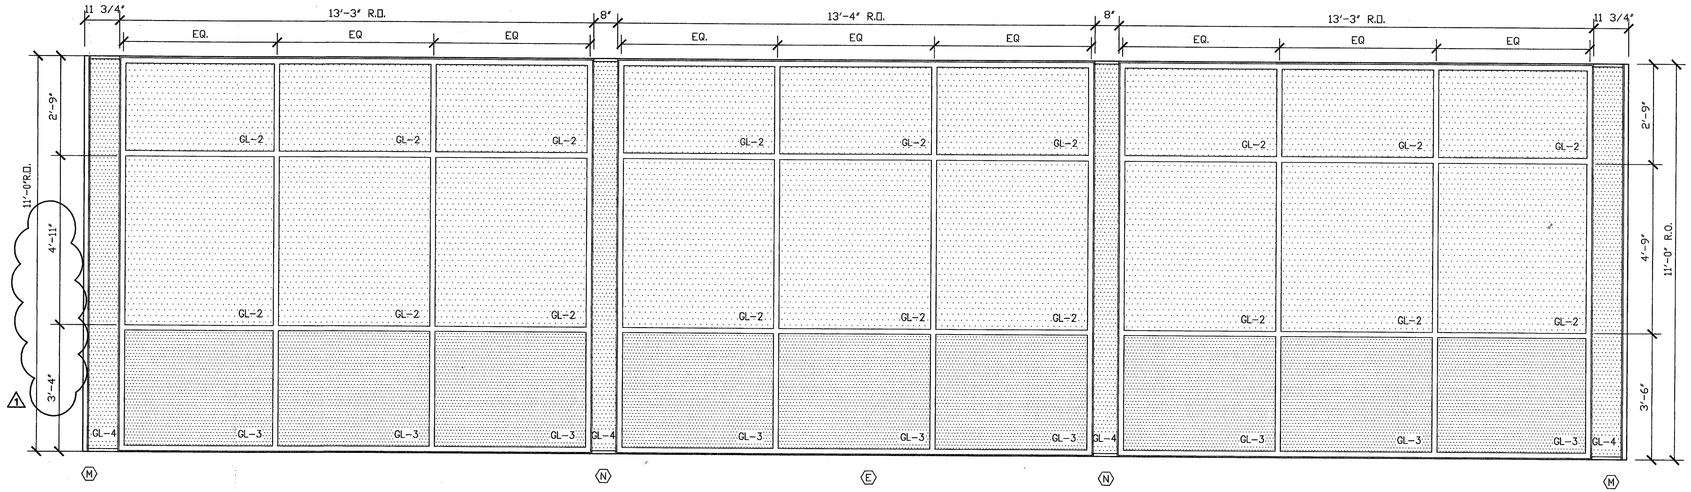

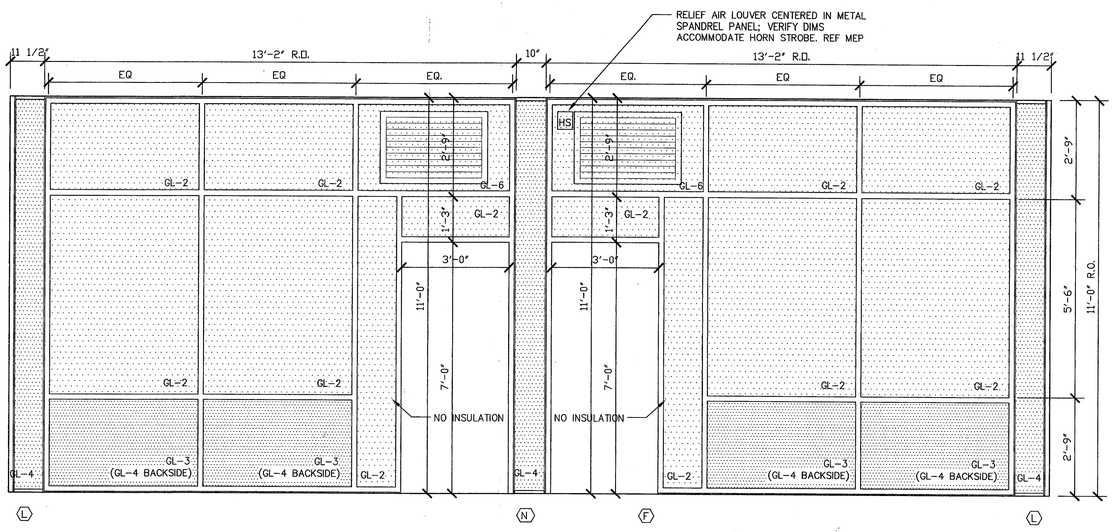

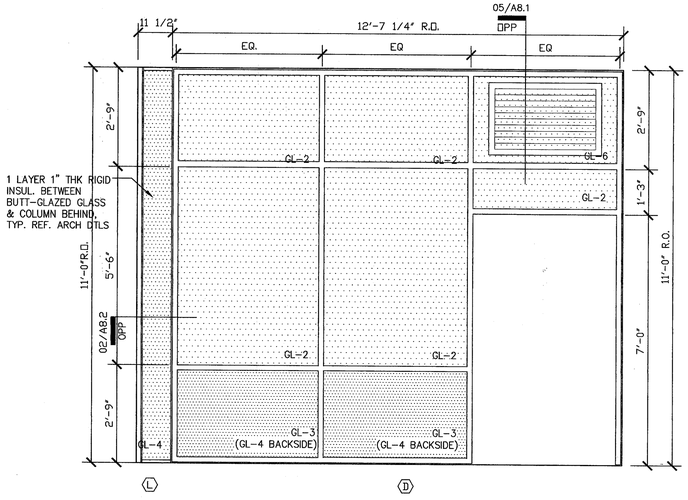

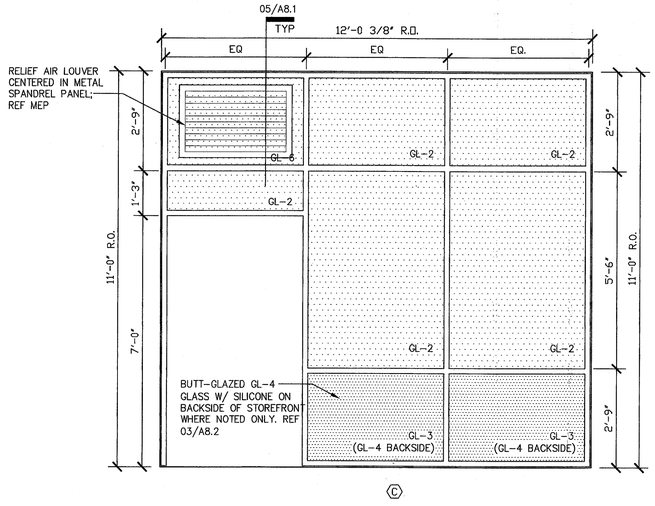

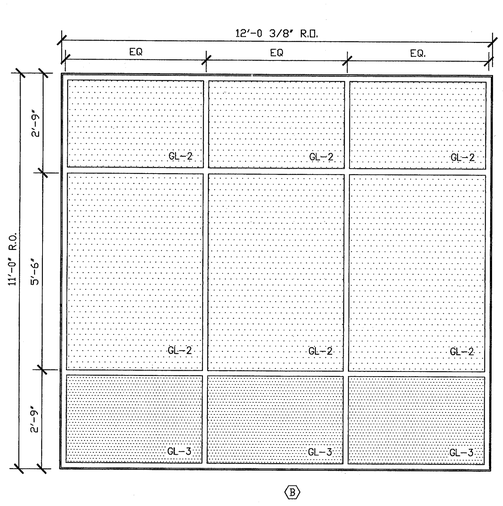

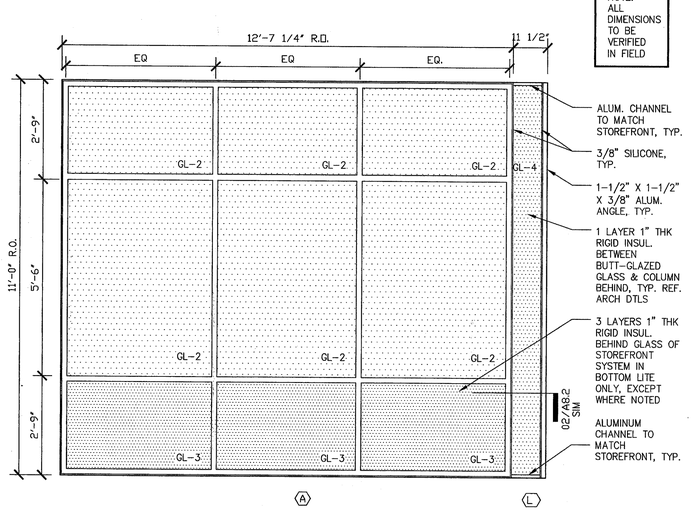

NOTE:
ALL DIMENSIONS TO BE VERIFIED IN FIELD

THIS DRAWING AND ASSOCIATED DATA ARE THE PROPERTY OF CUNNINGHAM ARCHITECTURAL, P.A. AND SHALL NOT BE REPRODUCED OR USED WITHOUT WRITTEN CONSENT OF THE ARCHITECT

cunningham architecture
916 Dragon Street
Dallas, Texas 75207
V 214.651.0900
f 214.915.0901

REGISTERED ARCHITECT CUNNINGHAM GARY L. 8211 STATE OF TEXAS
3.9.03

Addison Arts and Events Pavilion

Addison, Texas

4970 Addison Circle Drive

issue	date
DD	08/26/02
50% CD	11/05/02
100% CD	01/23/03
POST-BID REVISION	03/04/03

A6.1

WINDOW TYPES