




**5 SLAB PLAN**  
**PLAN DETAILS** 1/8"=1'-0"

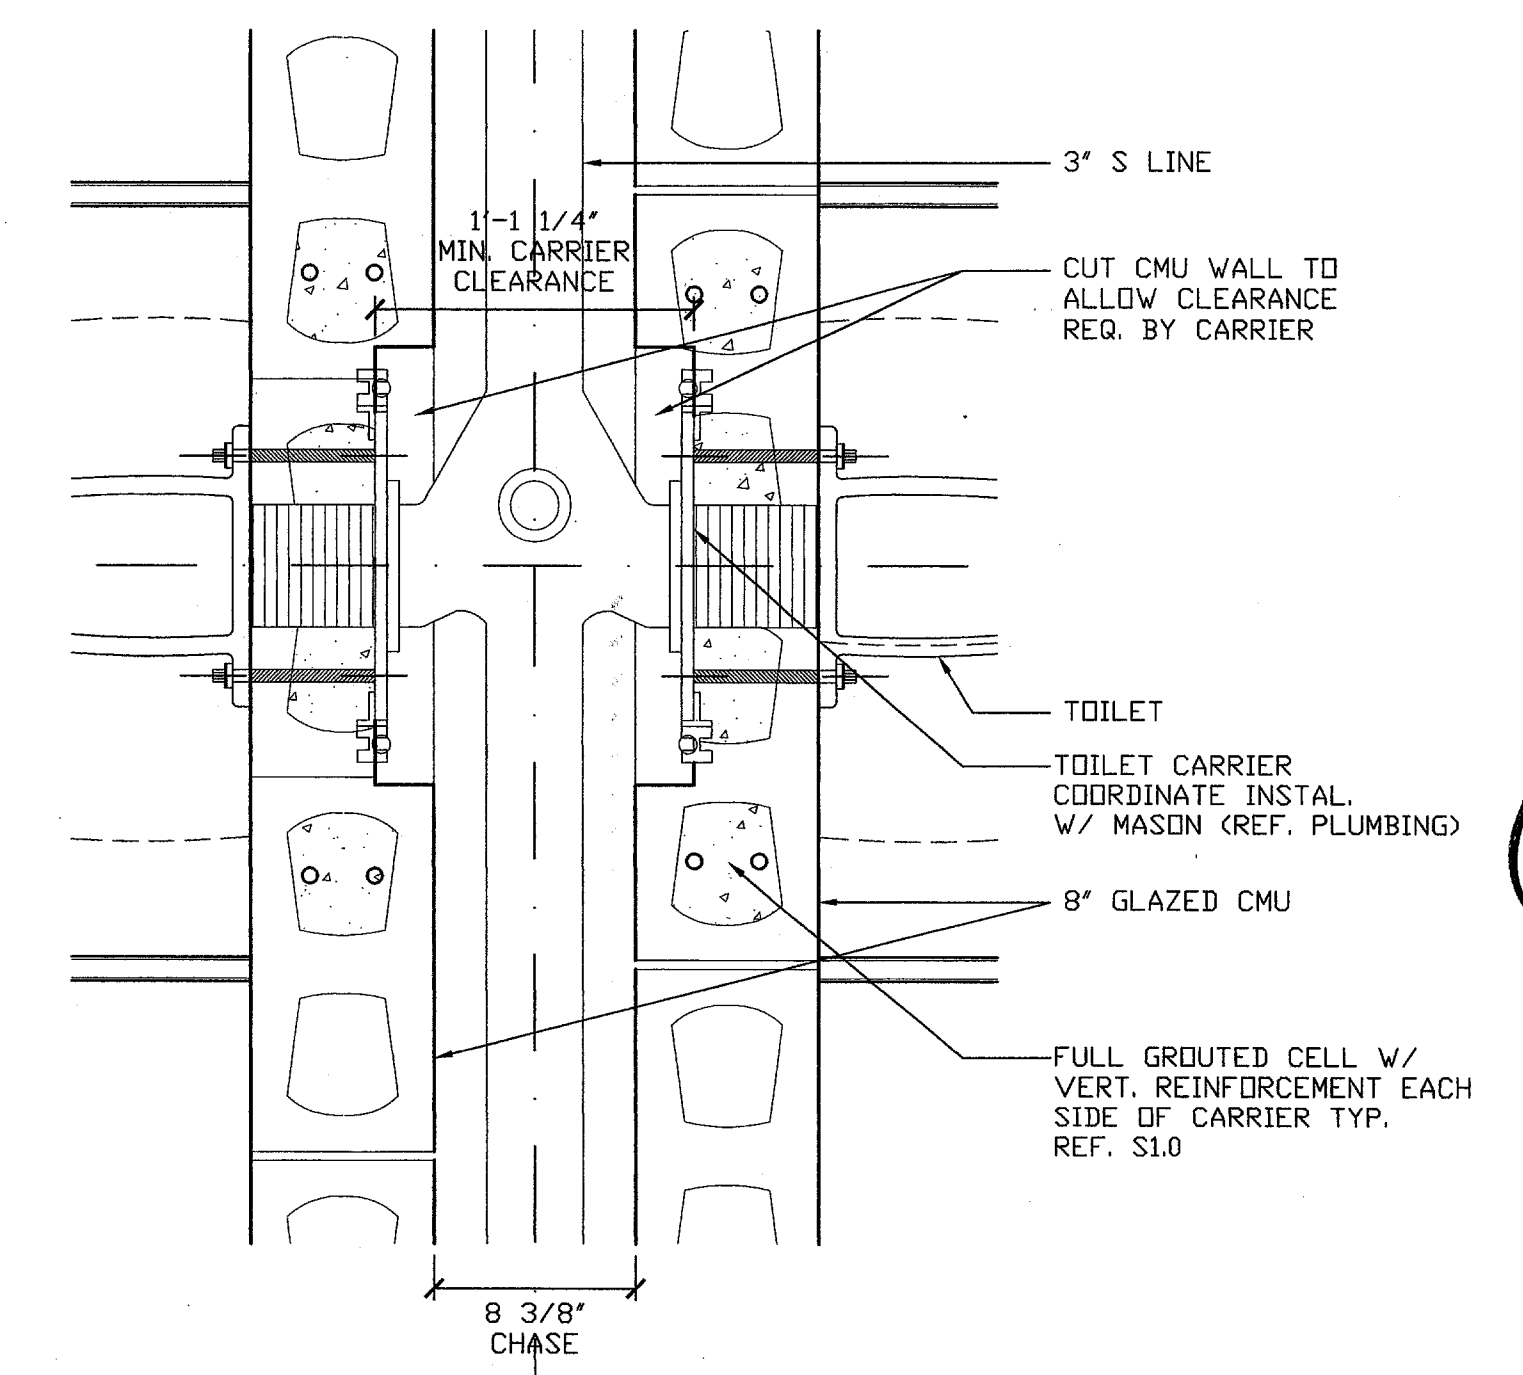


**4 CMU CHASE @ CARRIER**  
**PLAN DETAILS** 1-1/2"=1'-0"

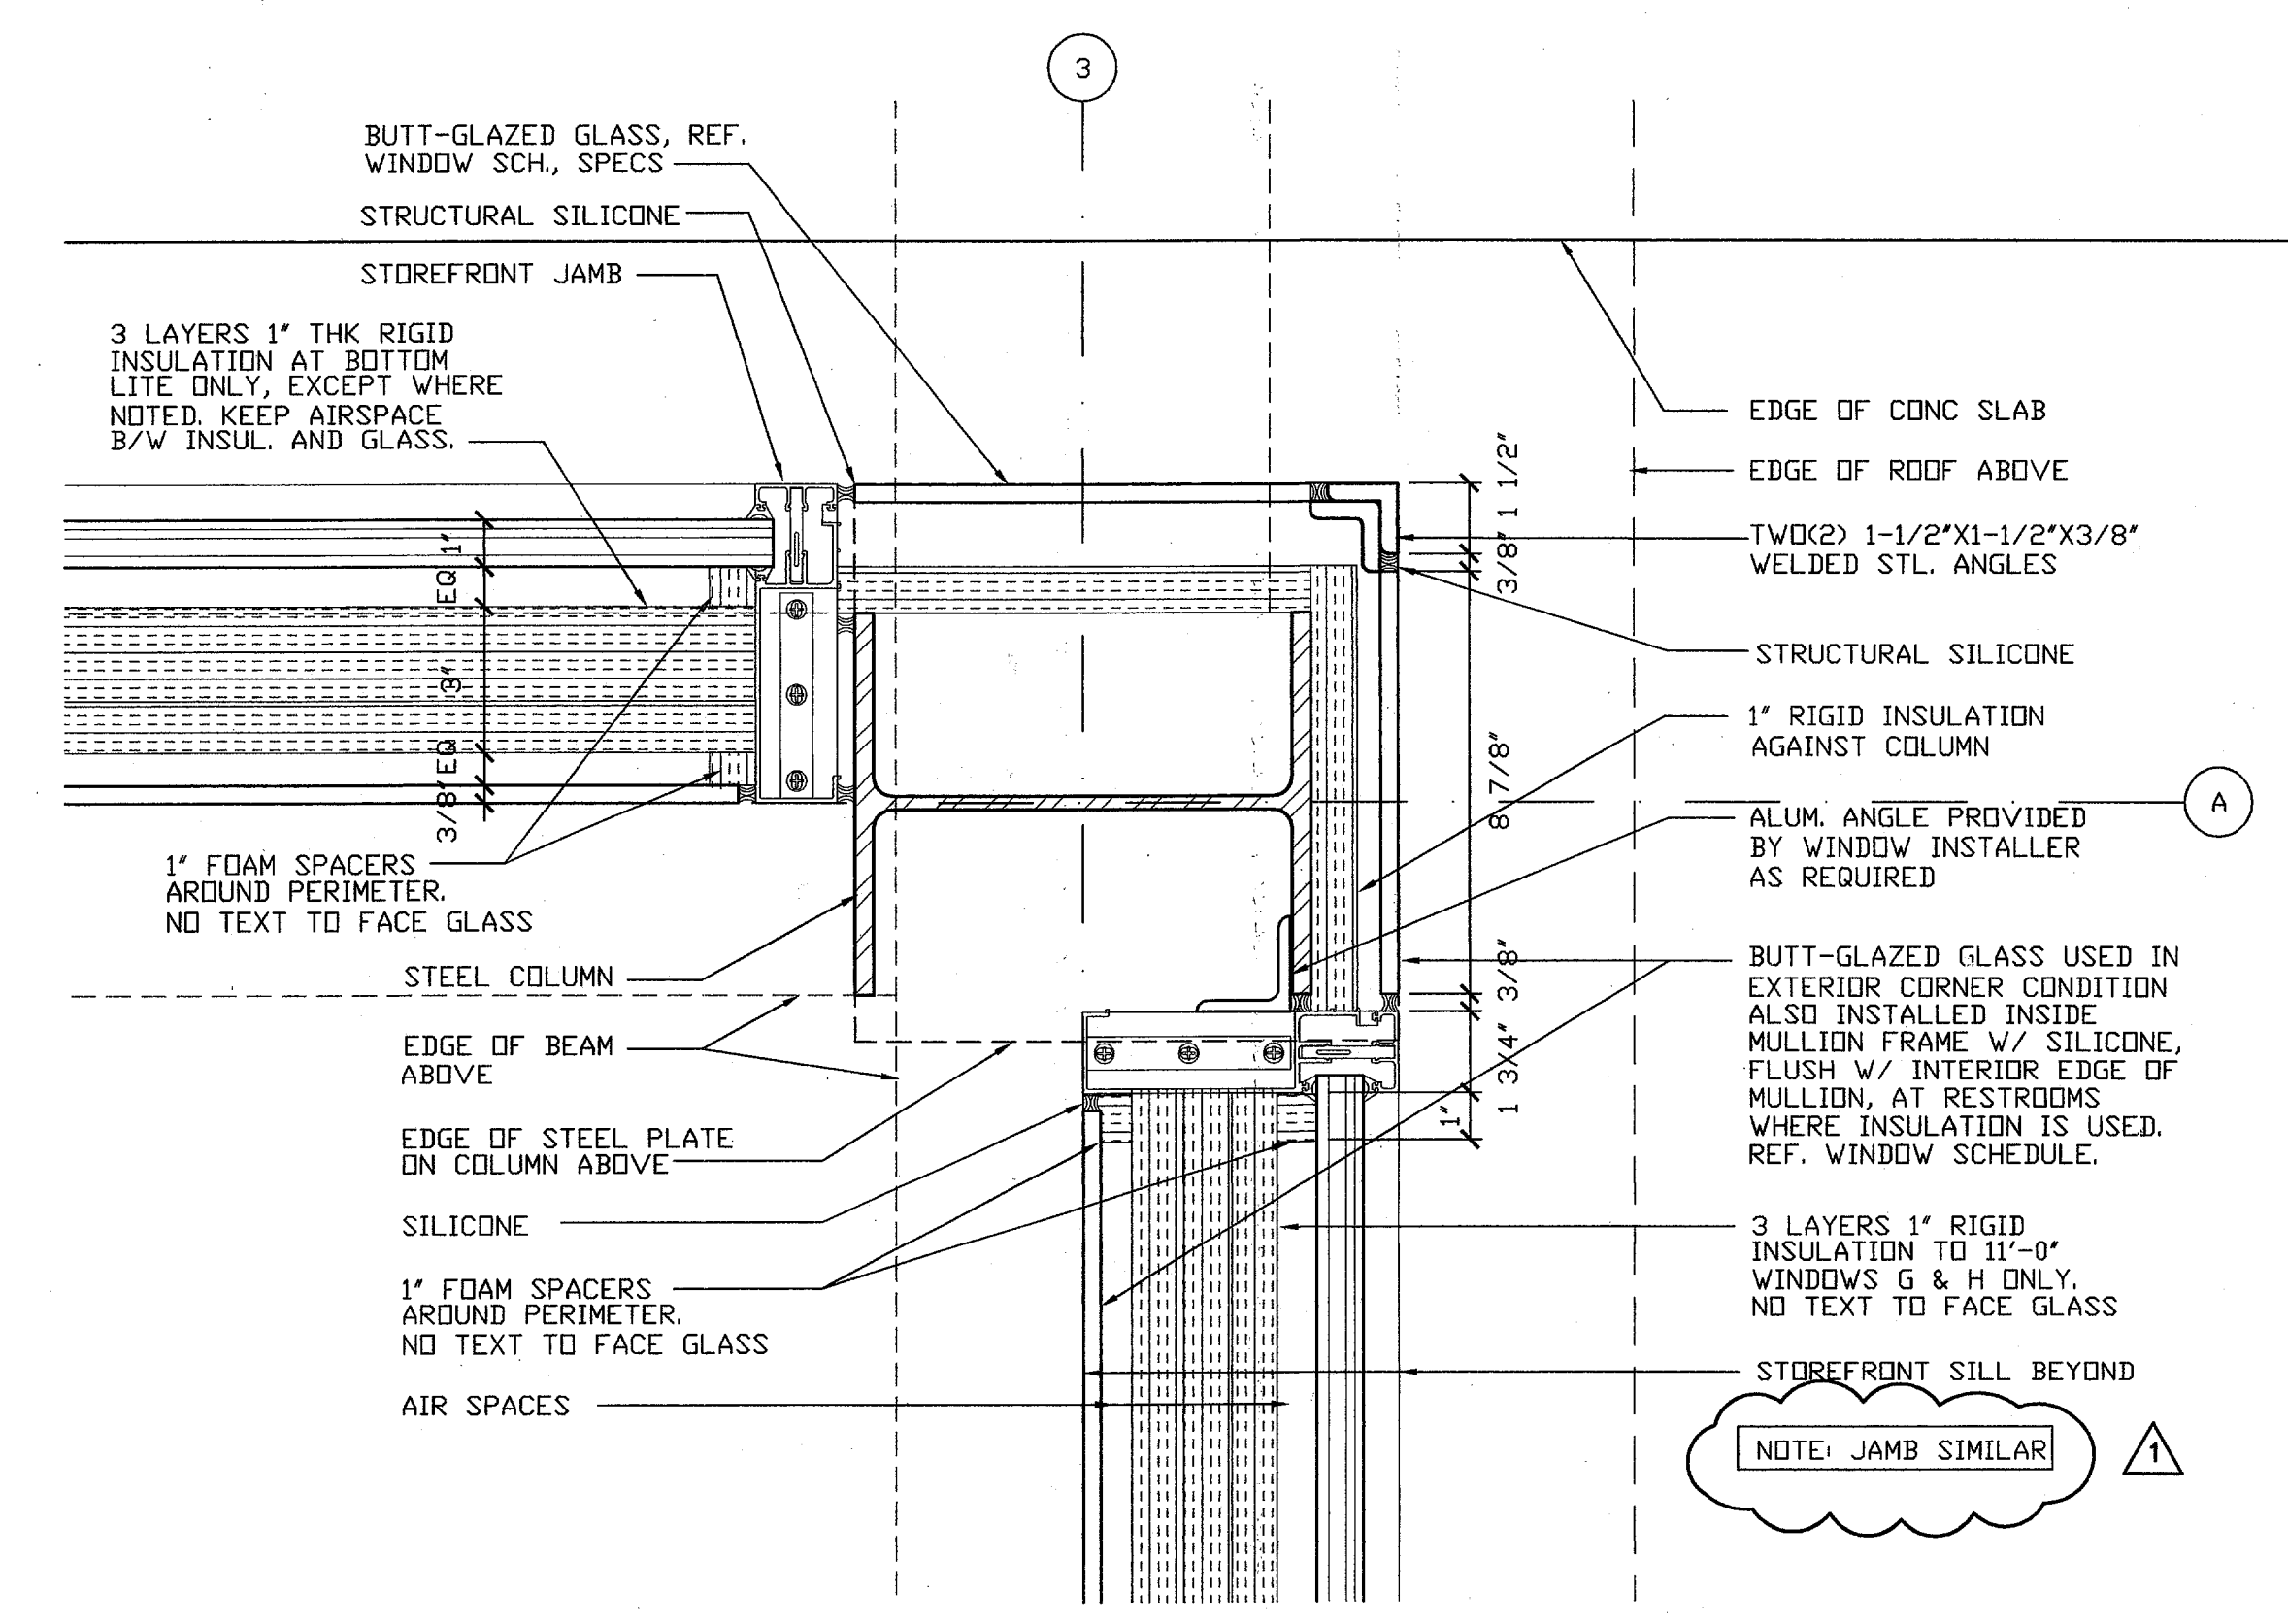

**3 STEEL COLUMN @ 3A**  
**PLAN DETAILS** 3"=1'-0"

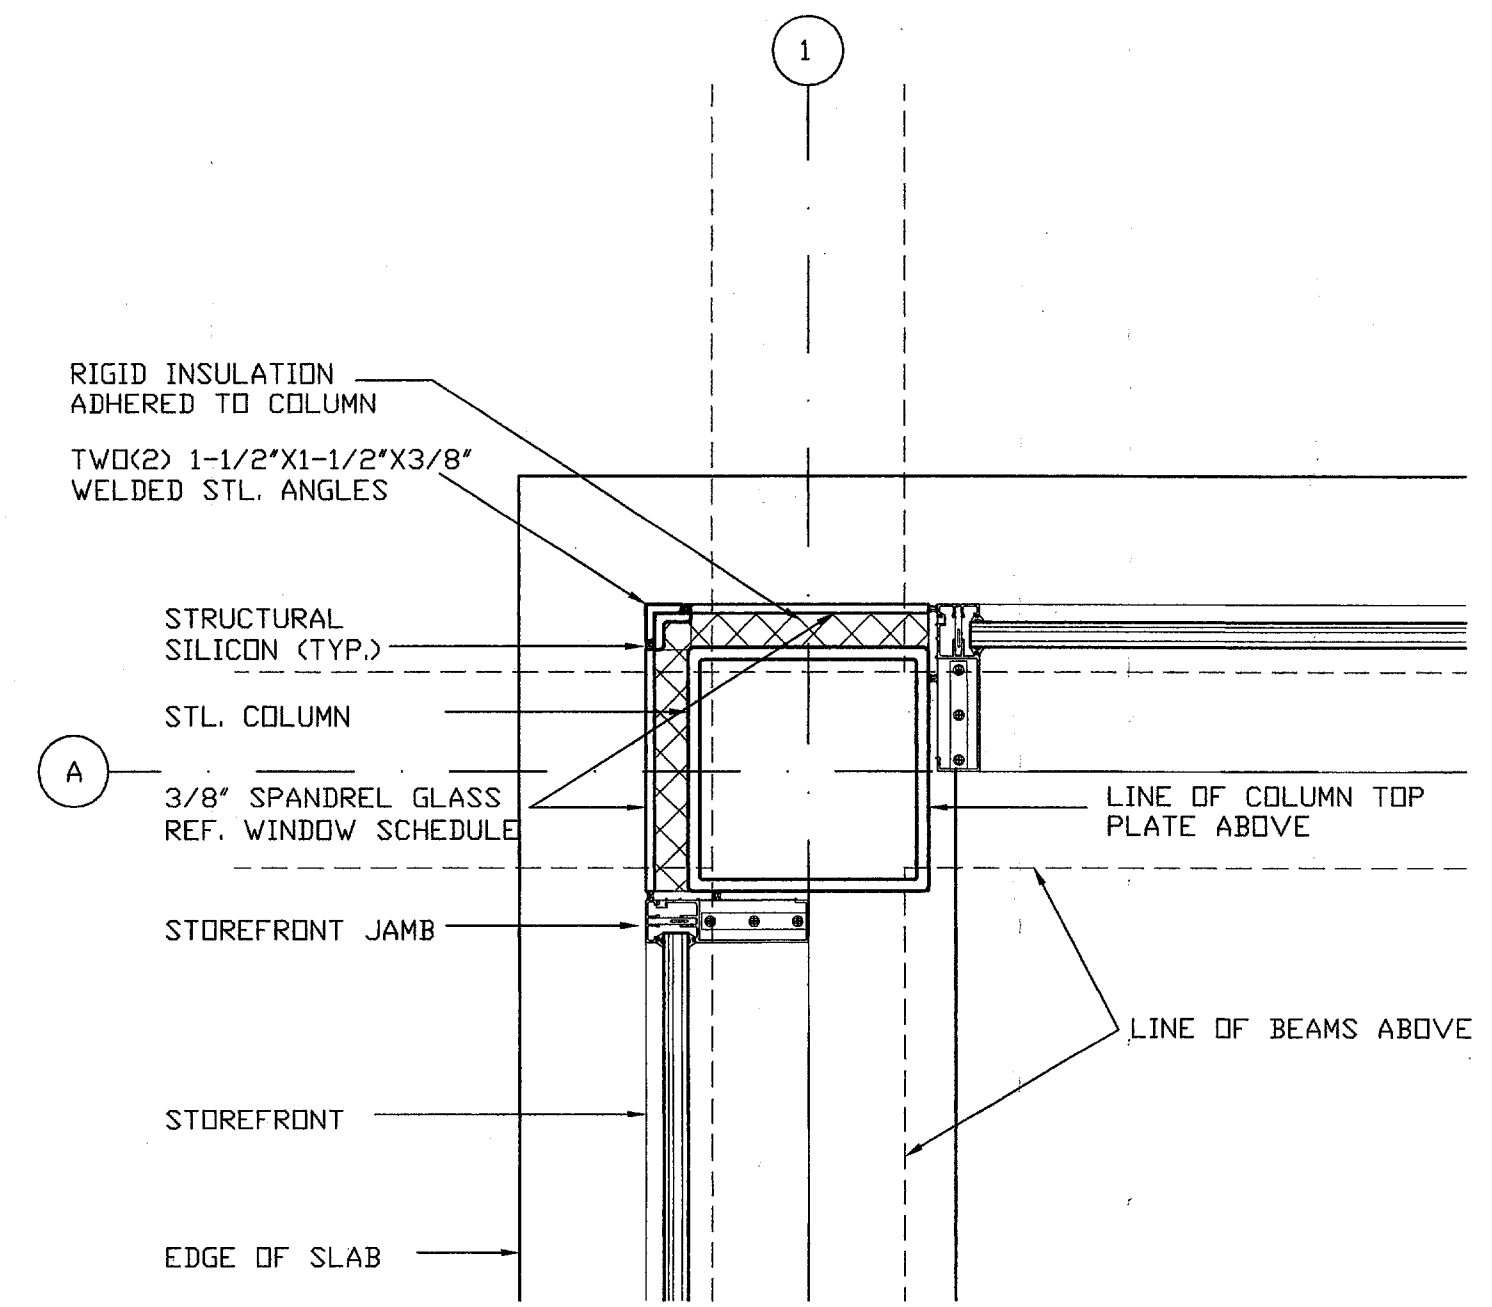

**2 STEEL COLUMN @ CL 1A**  
**PLAN DETAILS** 1-1/2"=1'-0"

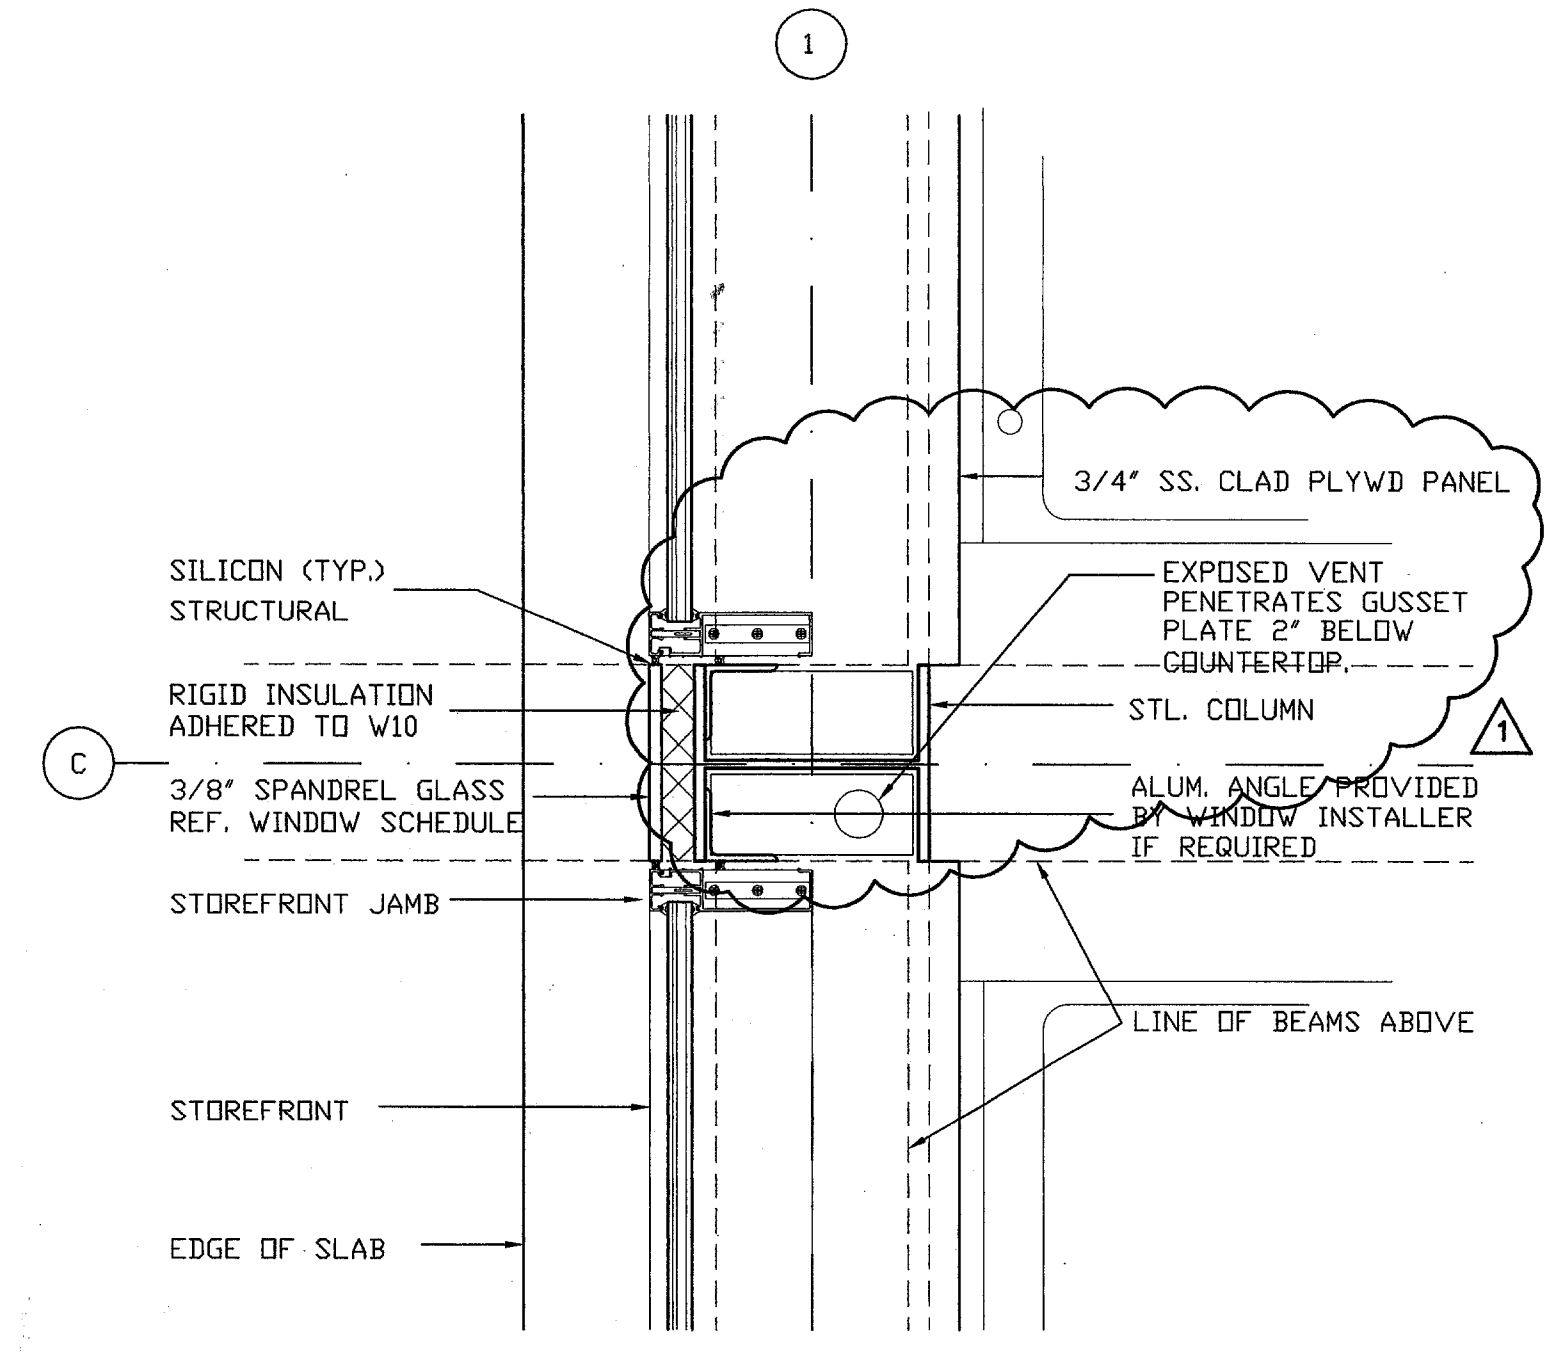

**1 STEEL COLUMN @ CL 1B**  
**PLAN DETAILS** 1-1/2"=1'-0"