


PLANTERS ROW

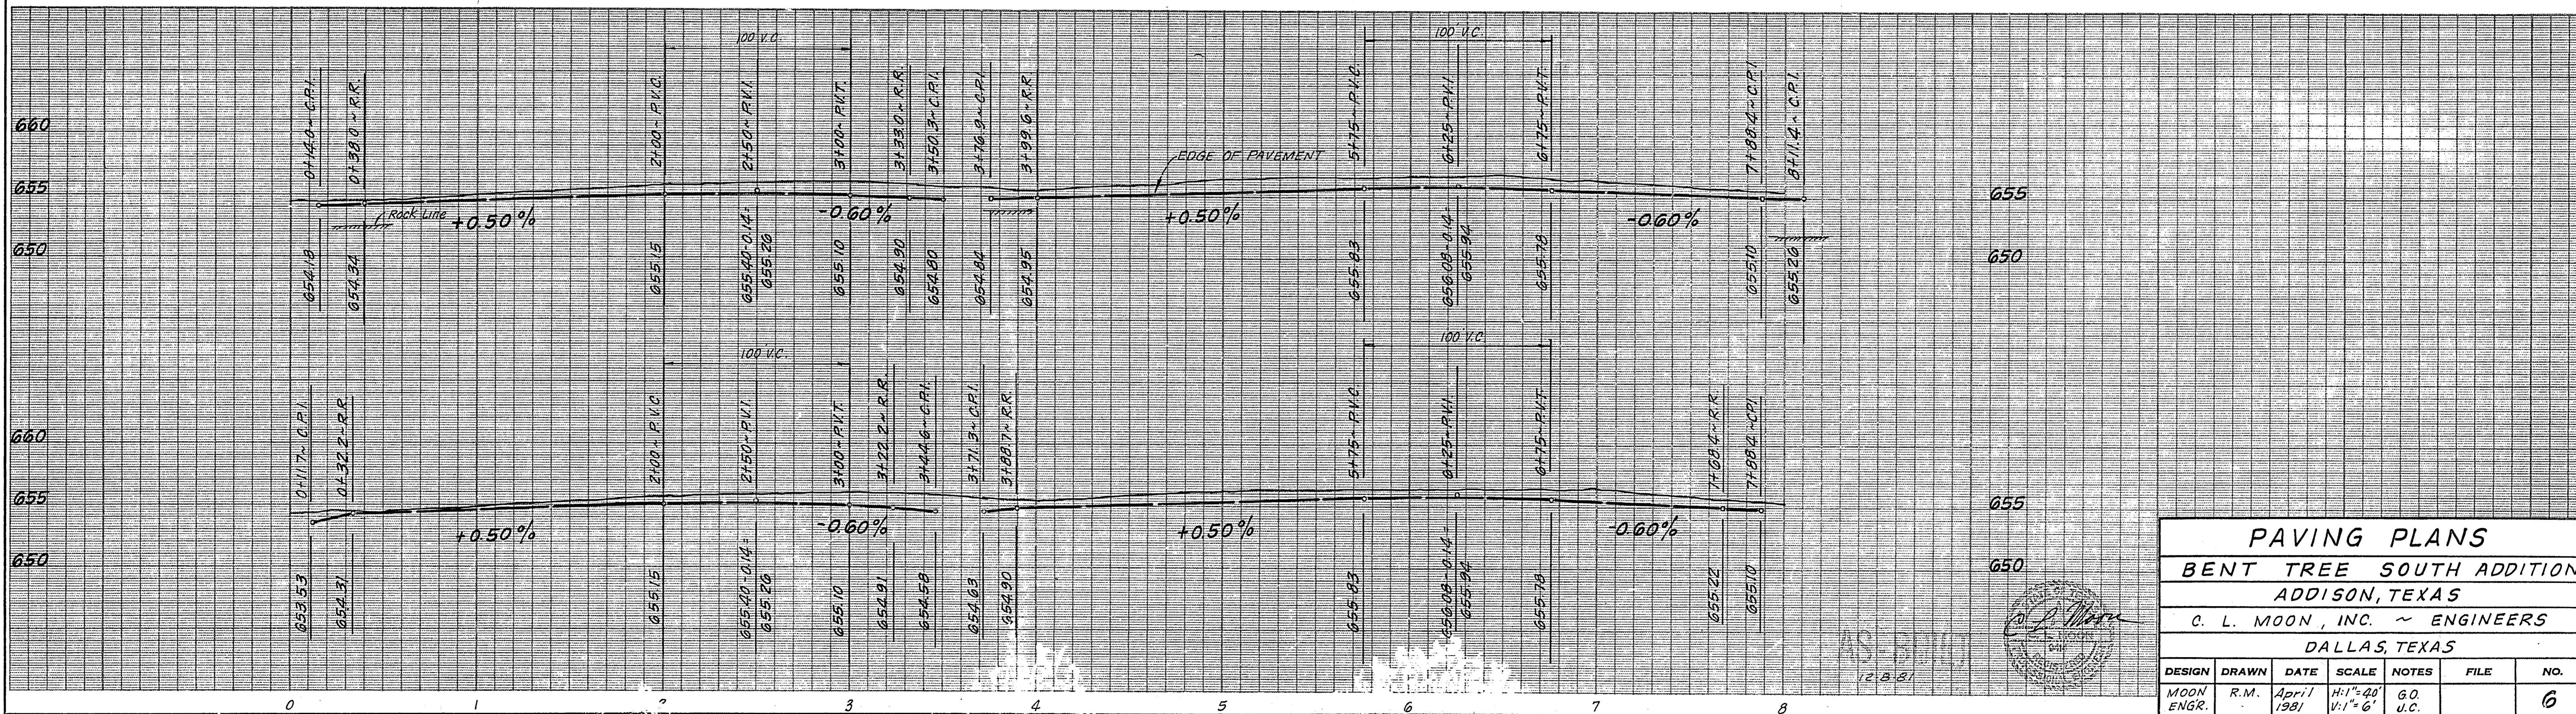

PAVING PLANS						
BENT TREE SOUTH ADDITION						
ADDISON, TEXAS						
C. L. MOON, INC. ~ ENGINEERS						
DALLAS, TEXAS						
DESIGN	DRAWN	DATE	SCALE	NOTES	FILE	NO.
MOON ENGR.	R.M.	April 1981	H:1"=20' V:1"=6'	G.O. U.C.		6