


VINLAND DRIVE

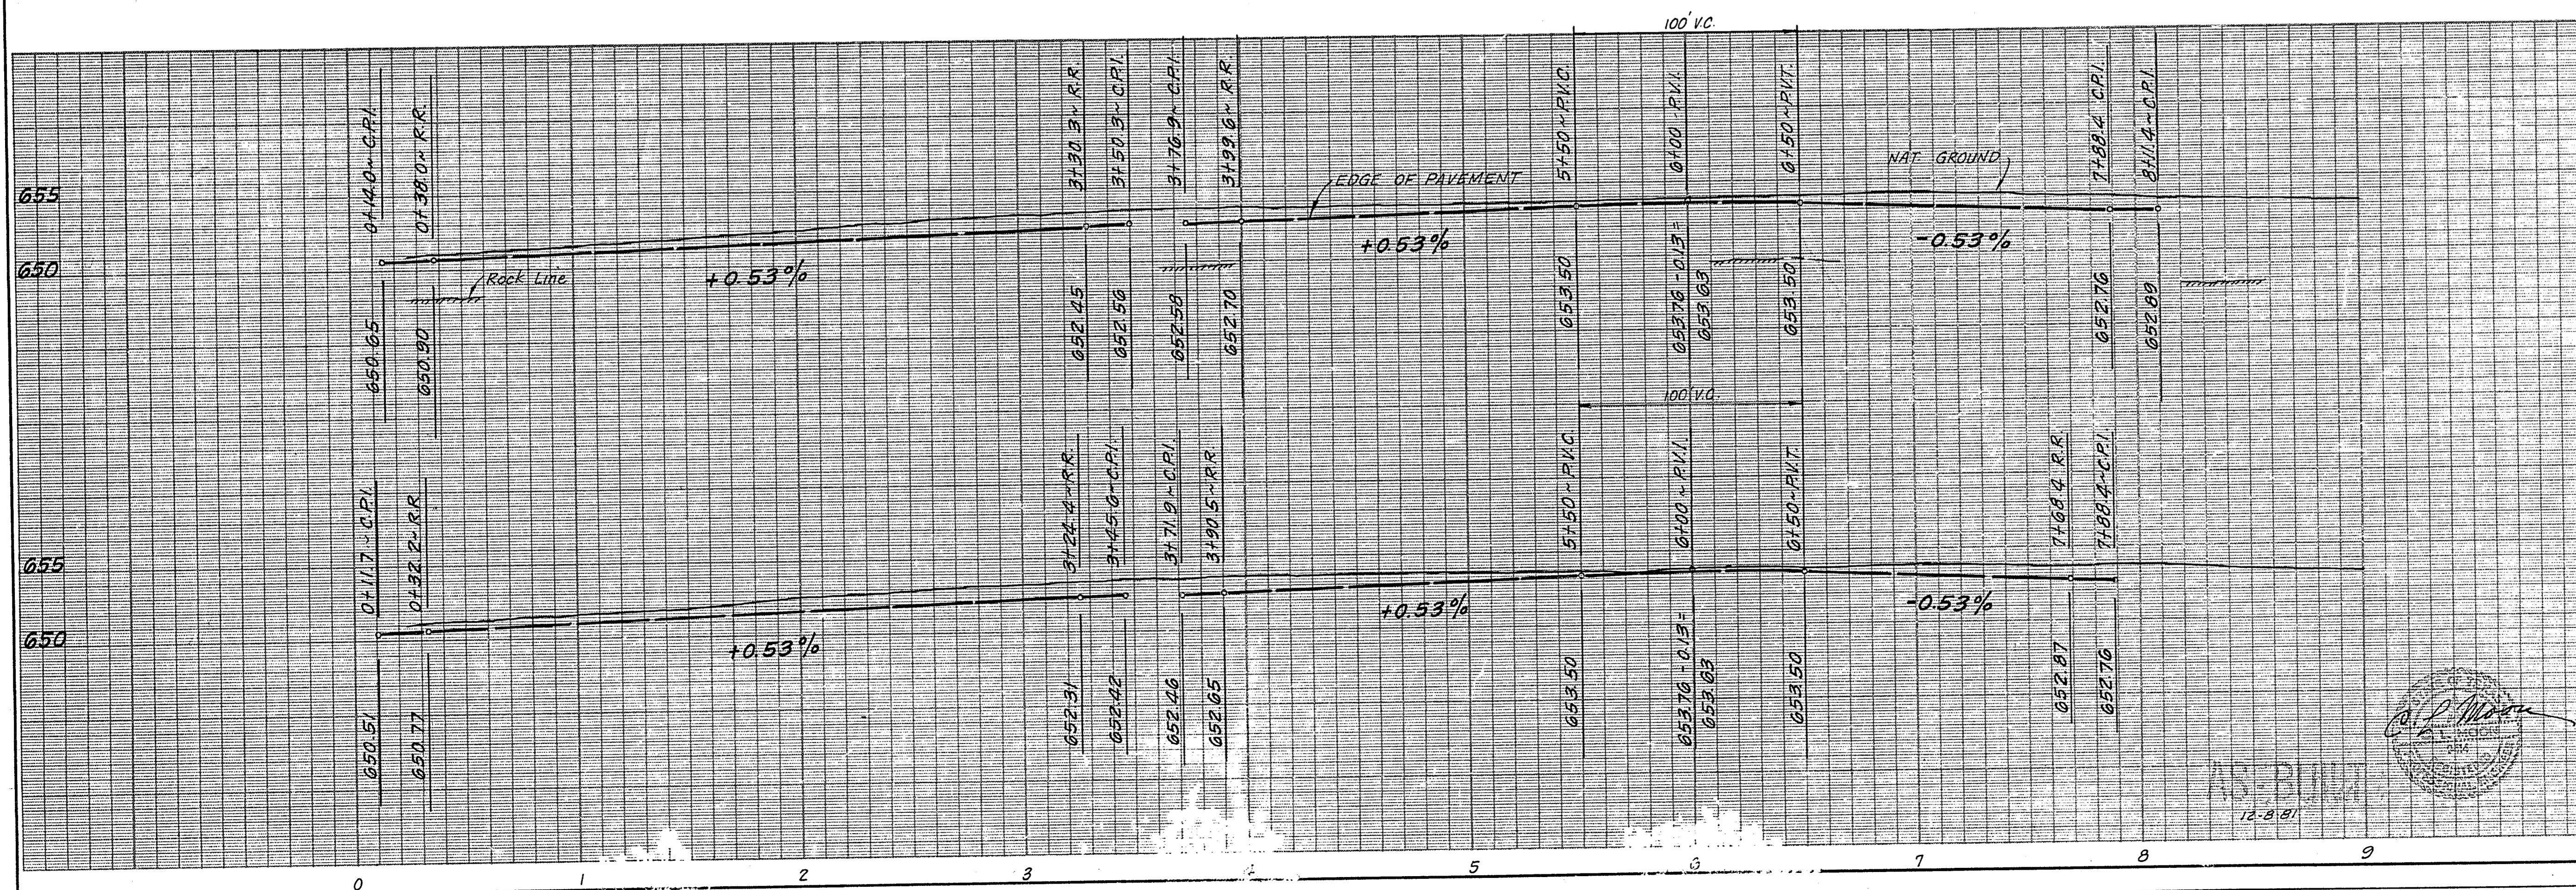

PAVING PLANS						
BENT TREE SOUTH ADDITION						
ADDISON, TEXAS						
C. L. MOON, INC. ~ ENGINEER						
DALLAS, TEXAS						
DESIGN	DRAWN	DATE	SCALE	NOTES	FILE	NO.
MOON ENGR.	R.M.	April 1981	H. 1" = 20' V. 1" = 6'	B.O. U.C.		8

VINLAND DRIVE