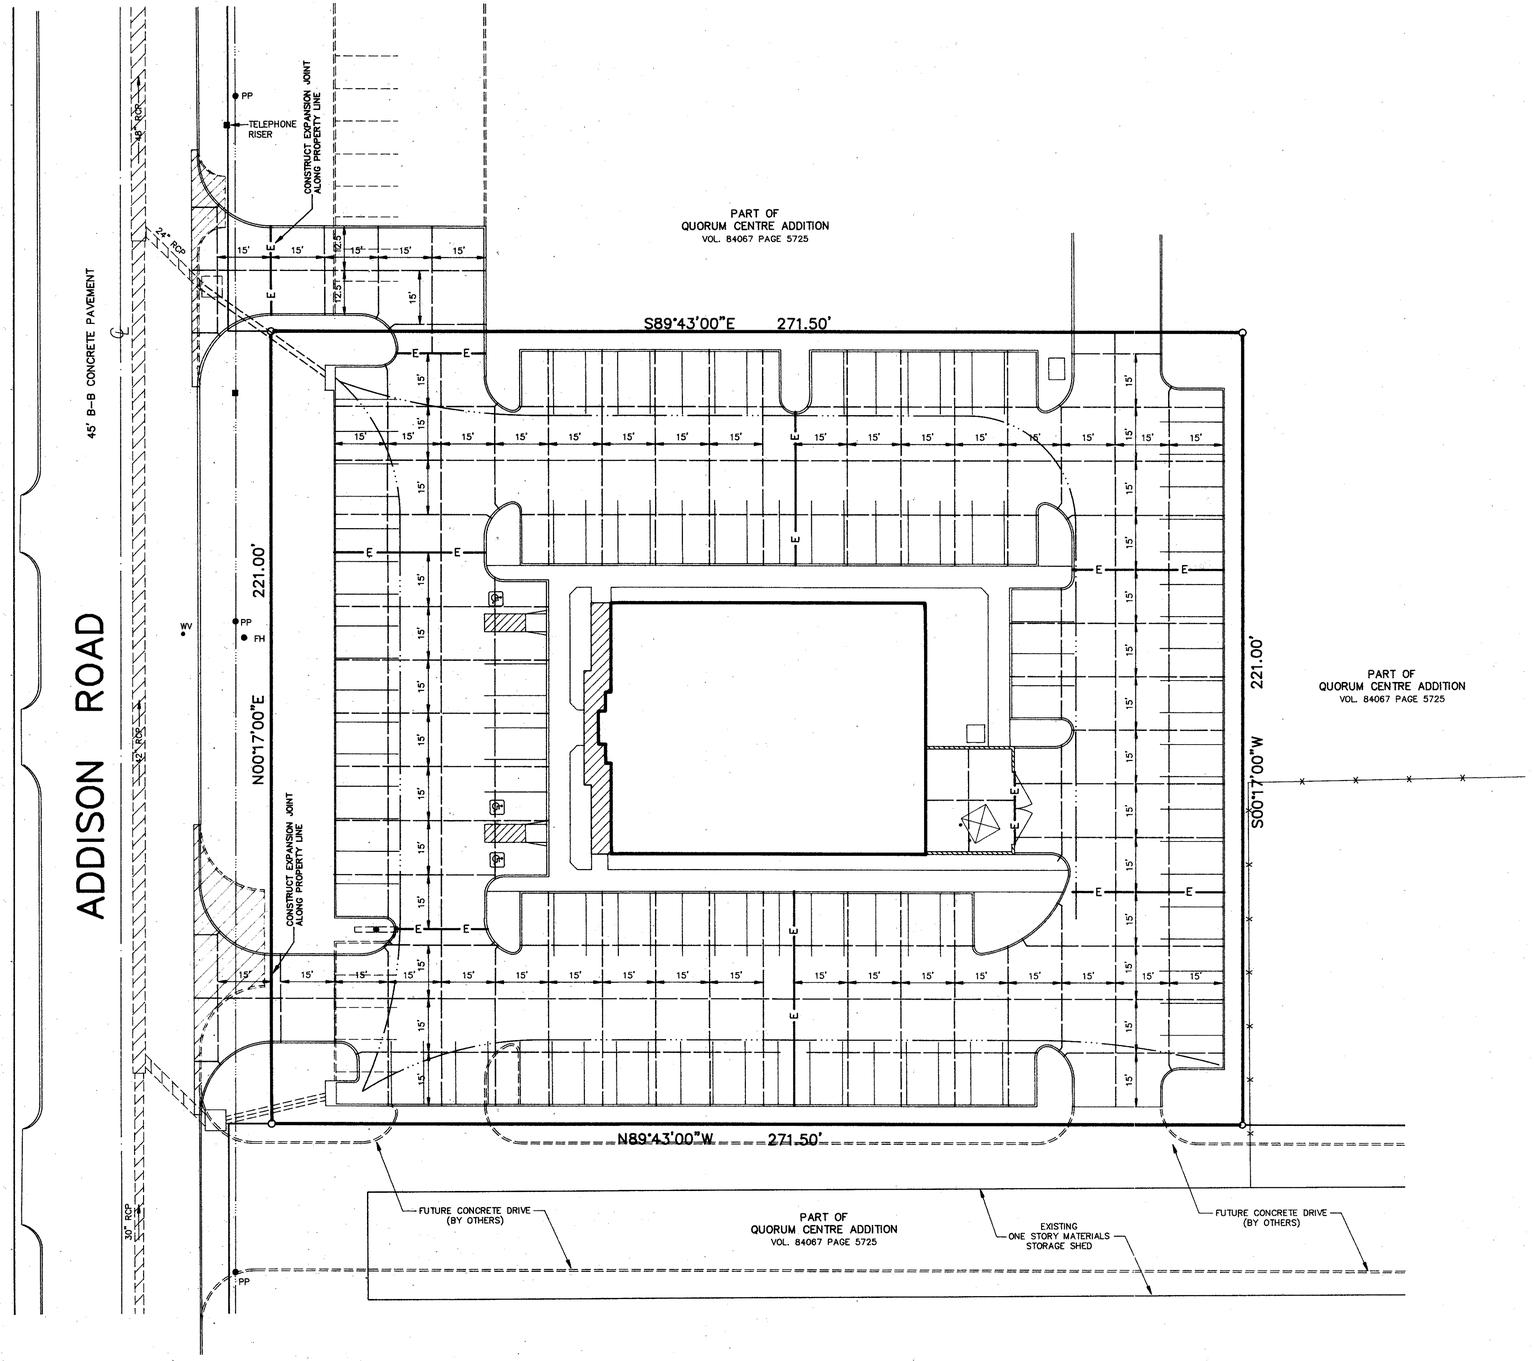

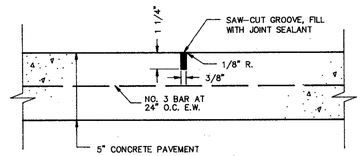

CONTRACTION JOINT DETAIL
NOT TO SCALE

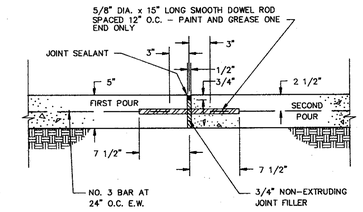

EXPANSION JOINT DETAIL
NOT TO SCALE

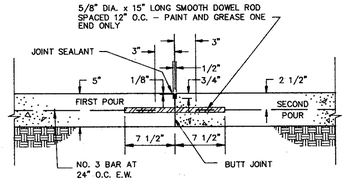

NOTE: CONSTRUCT EXPANSION JOINT WHENEVER THE PLACEMENT OF CONCRETE IS SUSPENDED FOR MORE THAN 30 MINUTES.

CONSTRUCTION JOINT DETAIL
NOT TO SCALE

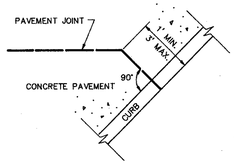

DETAIL OF PAVEMENT JOINT AT CURB
NOT TO SCALE

LEGEND

——E——E——	EXPANSION JOINT
————	CONTRACTION JOINT
—·—·—	FLOWLINE OR INVERT

AS-BUILT

STATE OF TEXAS
JAMES DEWEY, JR.
61480
REGISTERED
PROFESSIONAL ENGINEER

REVISIONS:

DATE	DESCRIPTION
3-19-93	CITY REVIEW COMMENTS

PREPARED BY:
DEWEY & ASSOCIATES
ENGINEERING, SURVEYING
LAND PLANNING, CAD DESIGNS
2505 TEXAS DRIVE, SUITE 110 • IRVING, TEXAS 75062 • 214/255-1501

PREPARED FOR:
OUTBACK STEAKHOUSE
550 NORTH REO STREET, SUITE 204
TAMPA, FLORIDA 33609
PHONE: (813) 282-1225
FAX: (813) 282-1209

OUTBACK STEAKHOUSE
QUORUM CENTRE ADDITION
ADDISON ROAD
TOWN OF ADDISON, TEXAS

SHEET TITLE
CONCRETE JOINT PATTERN PLAN

DATE: FEB. 19, 1993
SCALE: 1" = 20'
DRAWN BY: SAS (ACAD)
CHECKED BY: JDJ
SHEET NO.
C4 OF 5

617