

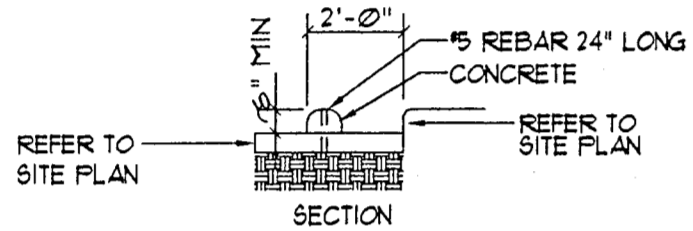


6 GUARDRAIL DETAIL
SCALE: 1/2" = 1'-0"
GORAIL.DWG

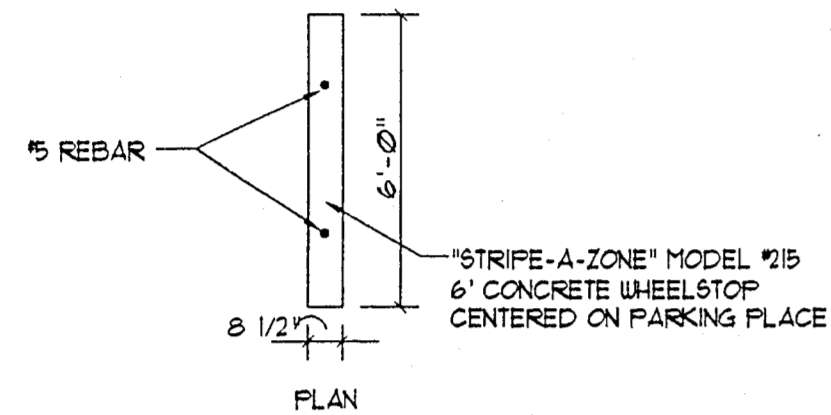


5 PRECAST PARKING BUMPER
SCALE: 1/4" = 1'-0"
BUMPER.DWG

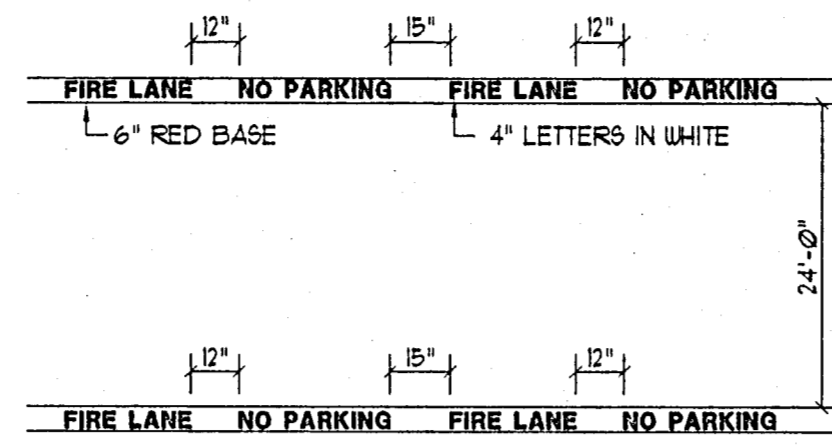


- "FIRE LANE NO PARKING" TO BE PAINTED ENTIRE LENGTH OF DEDICATED FIRE LANE.
- WHERE PRACTICAL, ALL FIRE LANE MARKINGS SHALL BE REQUIRED TO BE PLACED ON THE CURB.
- WHERE THE ABOVE FIRE LANE MARKINGS ARE DETERMINED TO BE INADEQUATE IN CONTROLLING TRAFFIC, THE PROPERTY OWNER WILL BE REQUIRED TO POST FIRE LANE SIGNS IN ADDITION TO OTHER FIRE LANE MARKINGS.
- WHEN RESTRIPING, ADDITIONS TO THE EXISTING FIRE LANES ARE NOT ALLOWED WITHOUT PRIOR APPROVAL OF THE FIRE DEPARTMENT.
- FOR ADDITIONAL FIRE LANE SPECIFICATIONS, PLEASE CONTACT THE FIRE DEPARTMENT.

4 FIRE DEPARTMENT REQUIREMENTS
SCALE: 1/4" = 1'-0"
DET4.DWG


15280 ADDISON ROAD
QUORUM CENTRE ADDITION
VOLUME, 84067, PAGE 5718

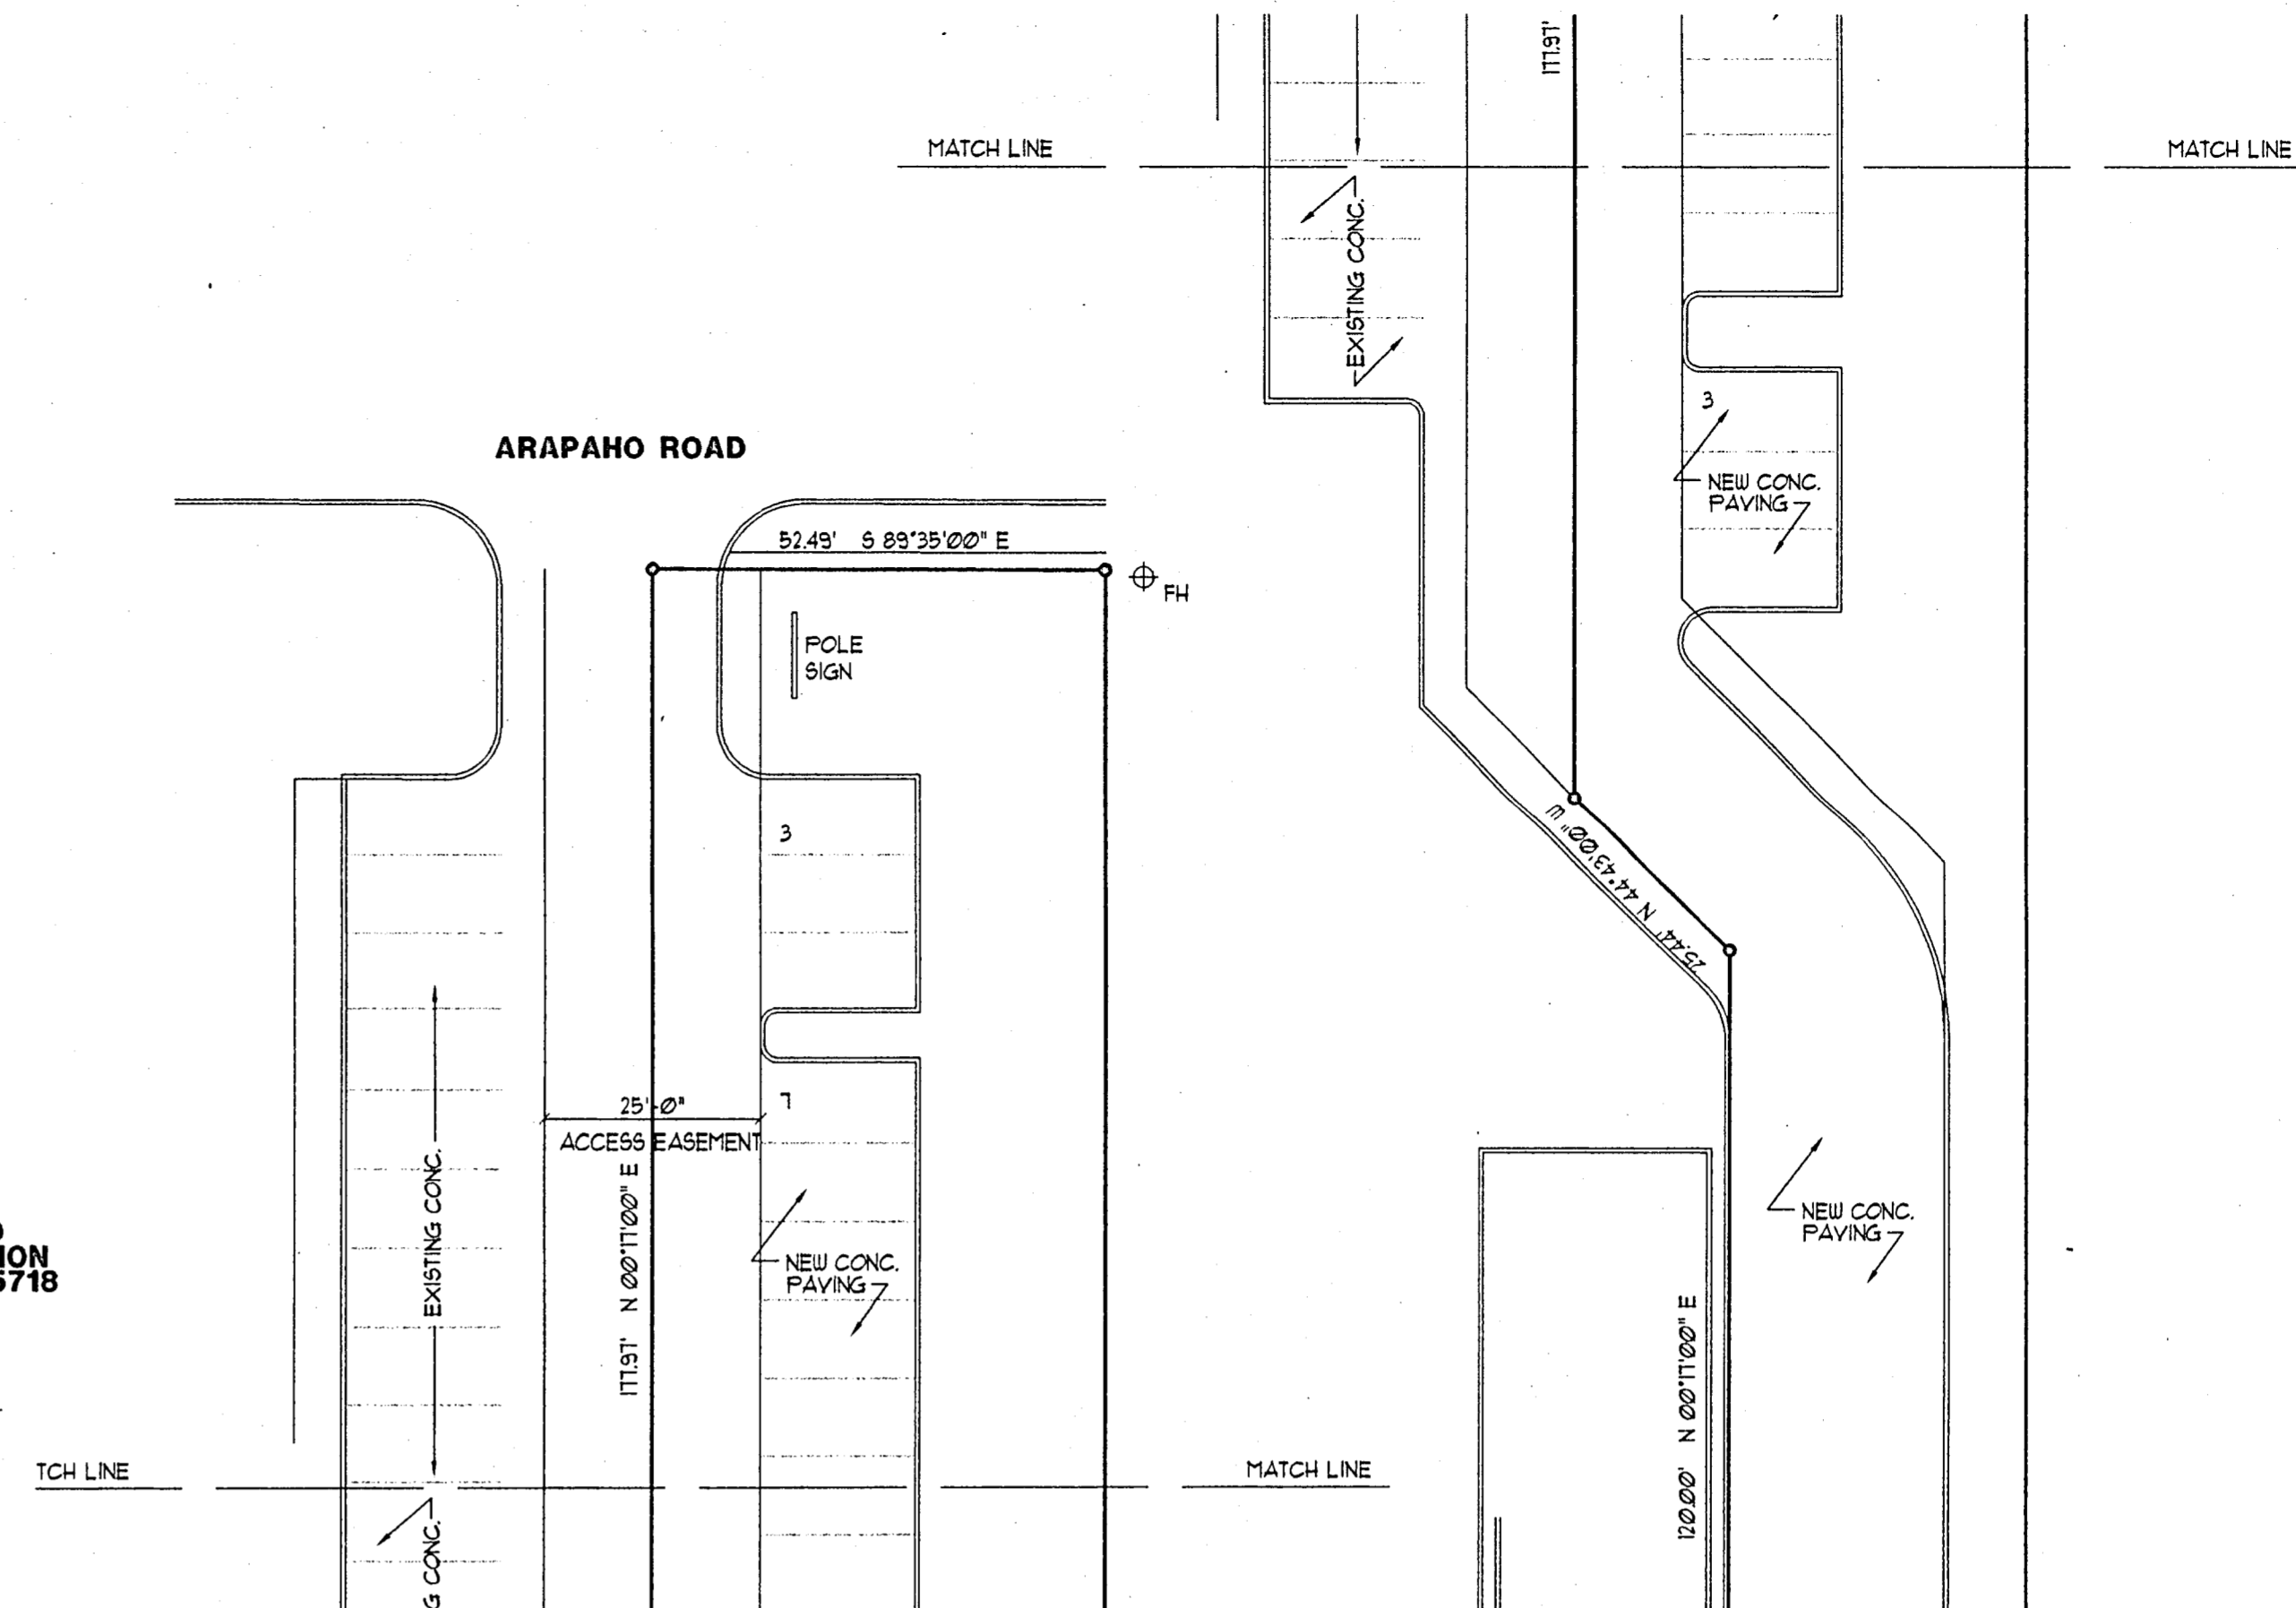

3 CONTINUATION OF SITE PLAN
SCALE: 1" = 20'-0"
ADD3SITE.DWG

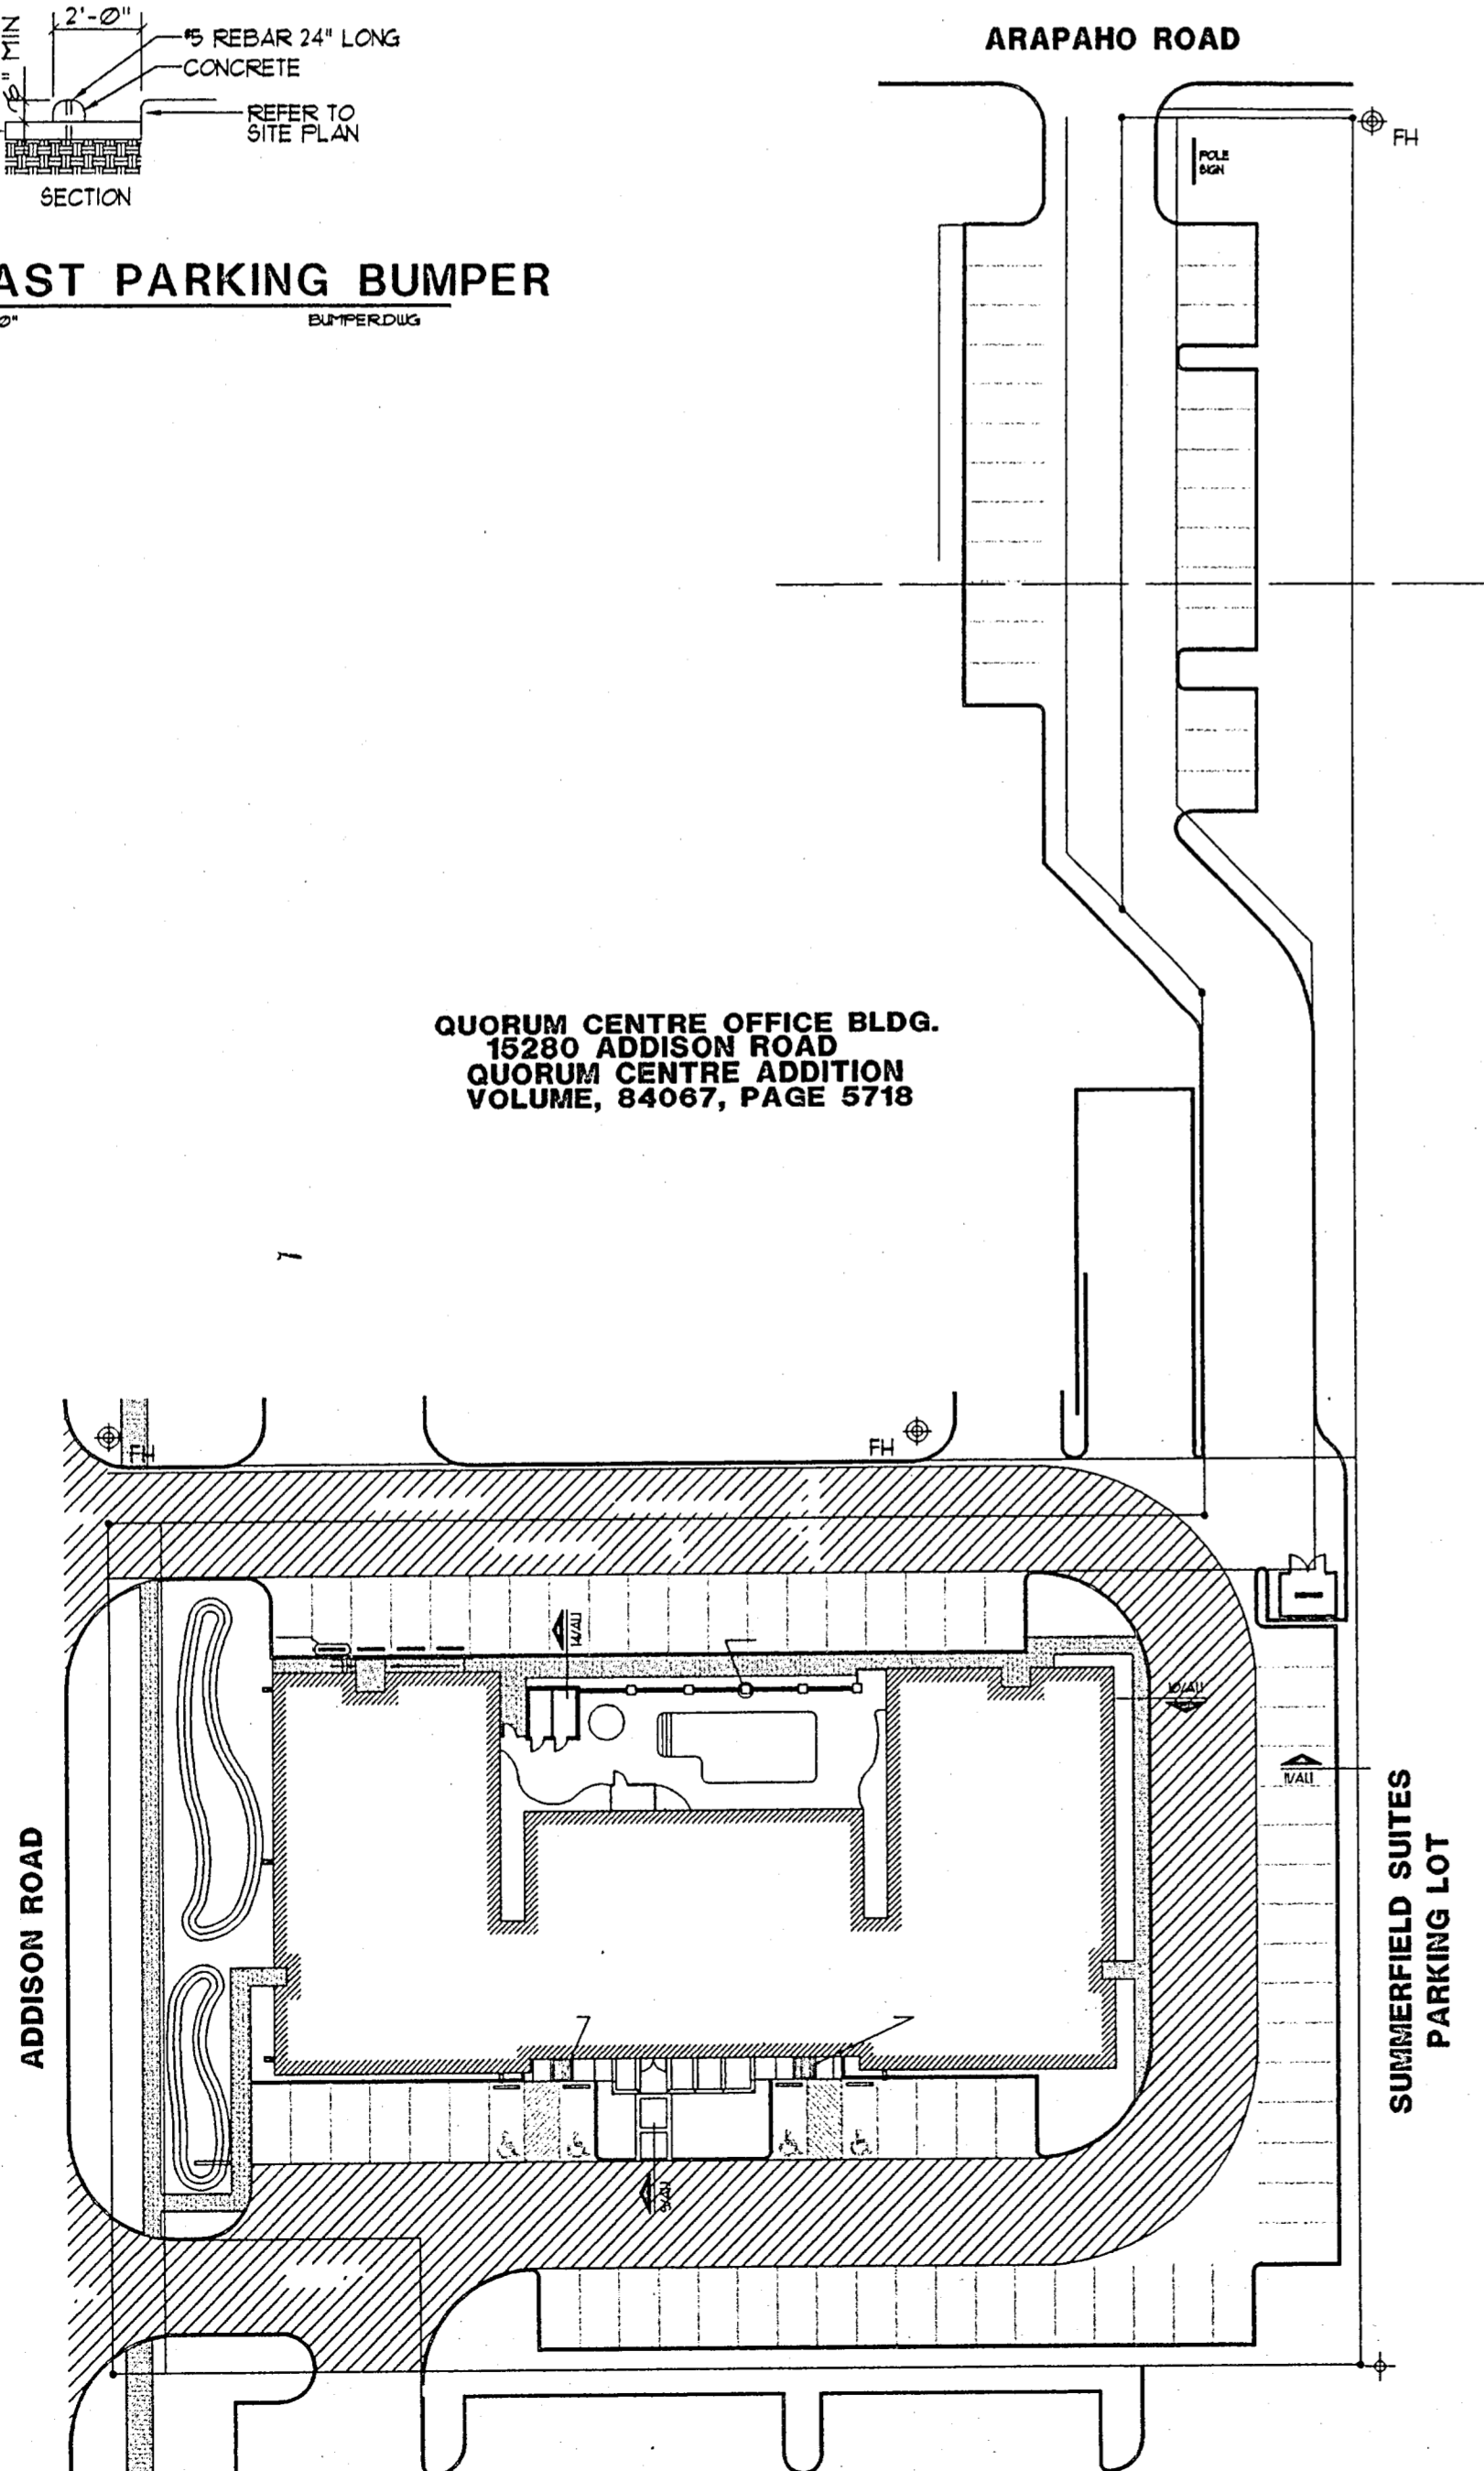

2 OVERALL SITE PLAN
SCALE: 1" = 40'-0"
ADD2SITE.DWG

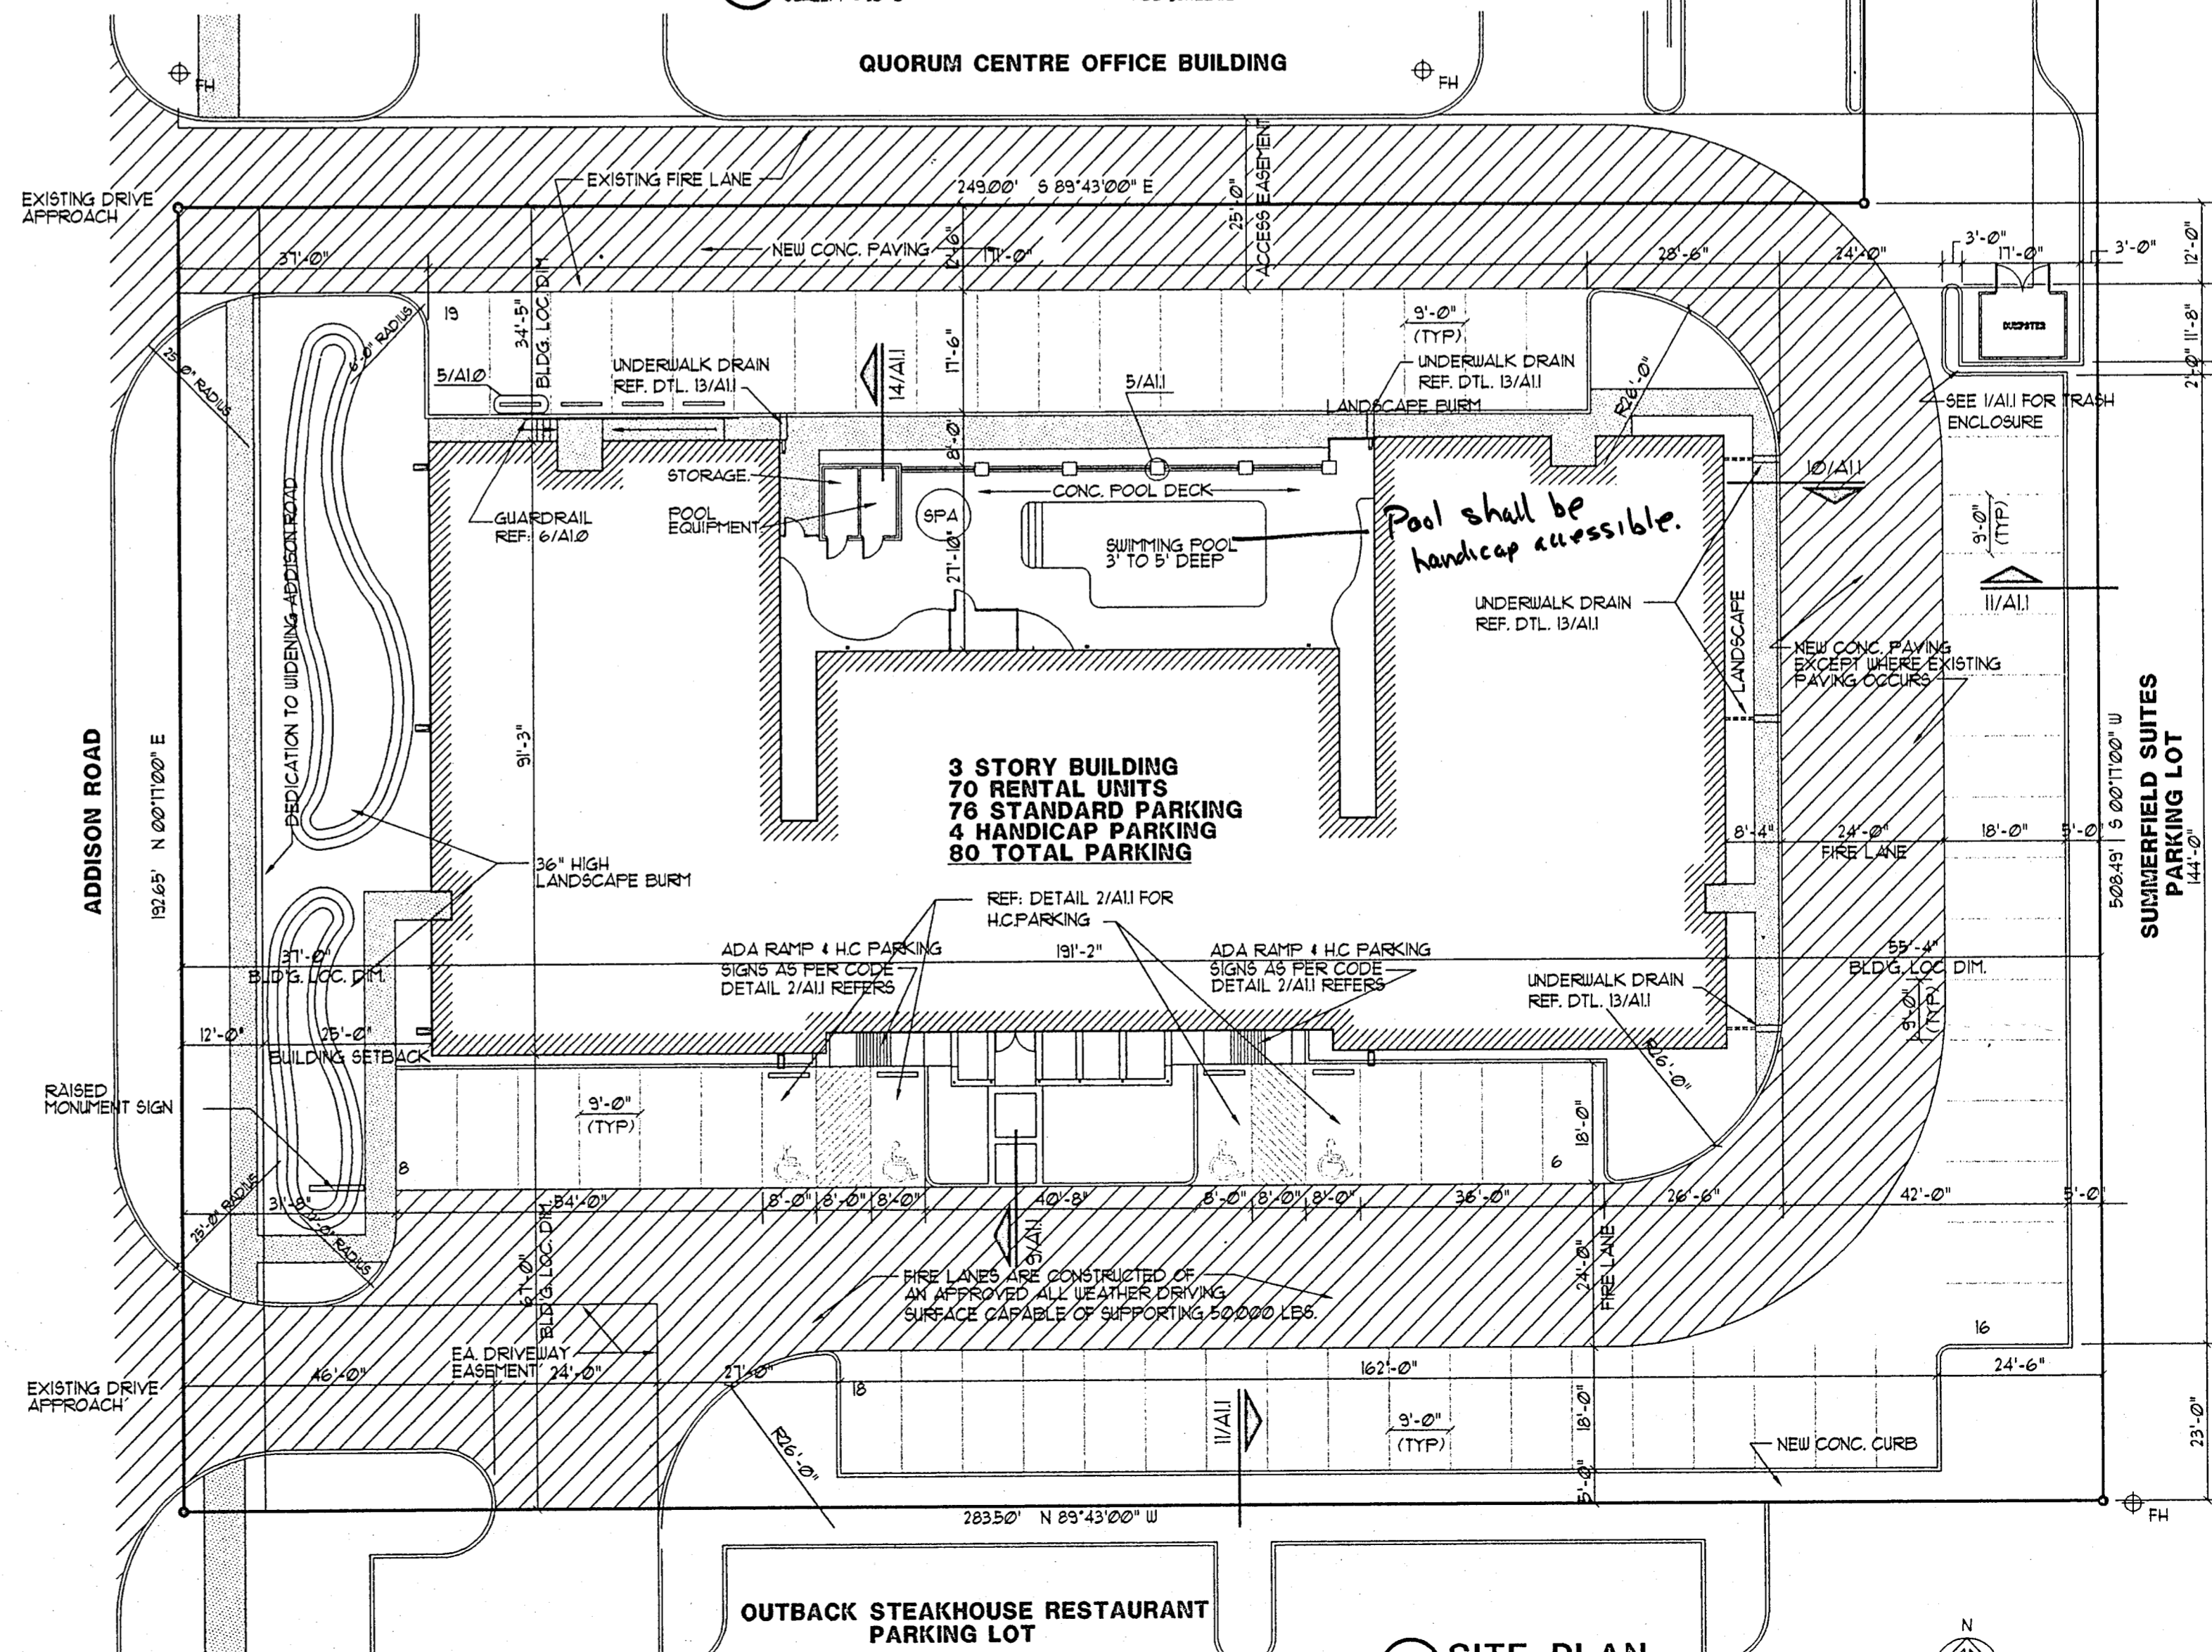


1 SITE PLAN
SCALE: 1" = 20'-0"
ADD1SITE.DWG

MAINSTAY SUITES
ADDISON, TEXAS



ART WILLIAMS JR
ARCHITECT
14180 DALLAS PARKWAY, SUITE 520
DALLAS, TEXAS 75240

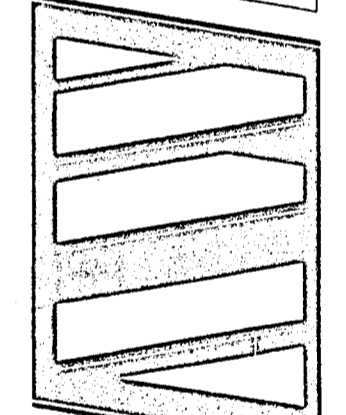

SITE PLAN

JOB: 811
DRAWN: FEC
DATE: 10/2/98
REVISIONS:

SHEET NO.
A1.0
OF: