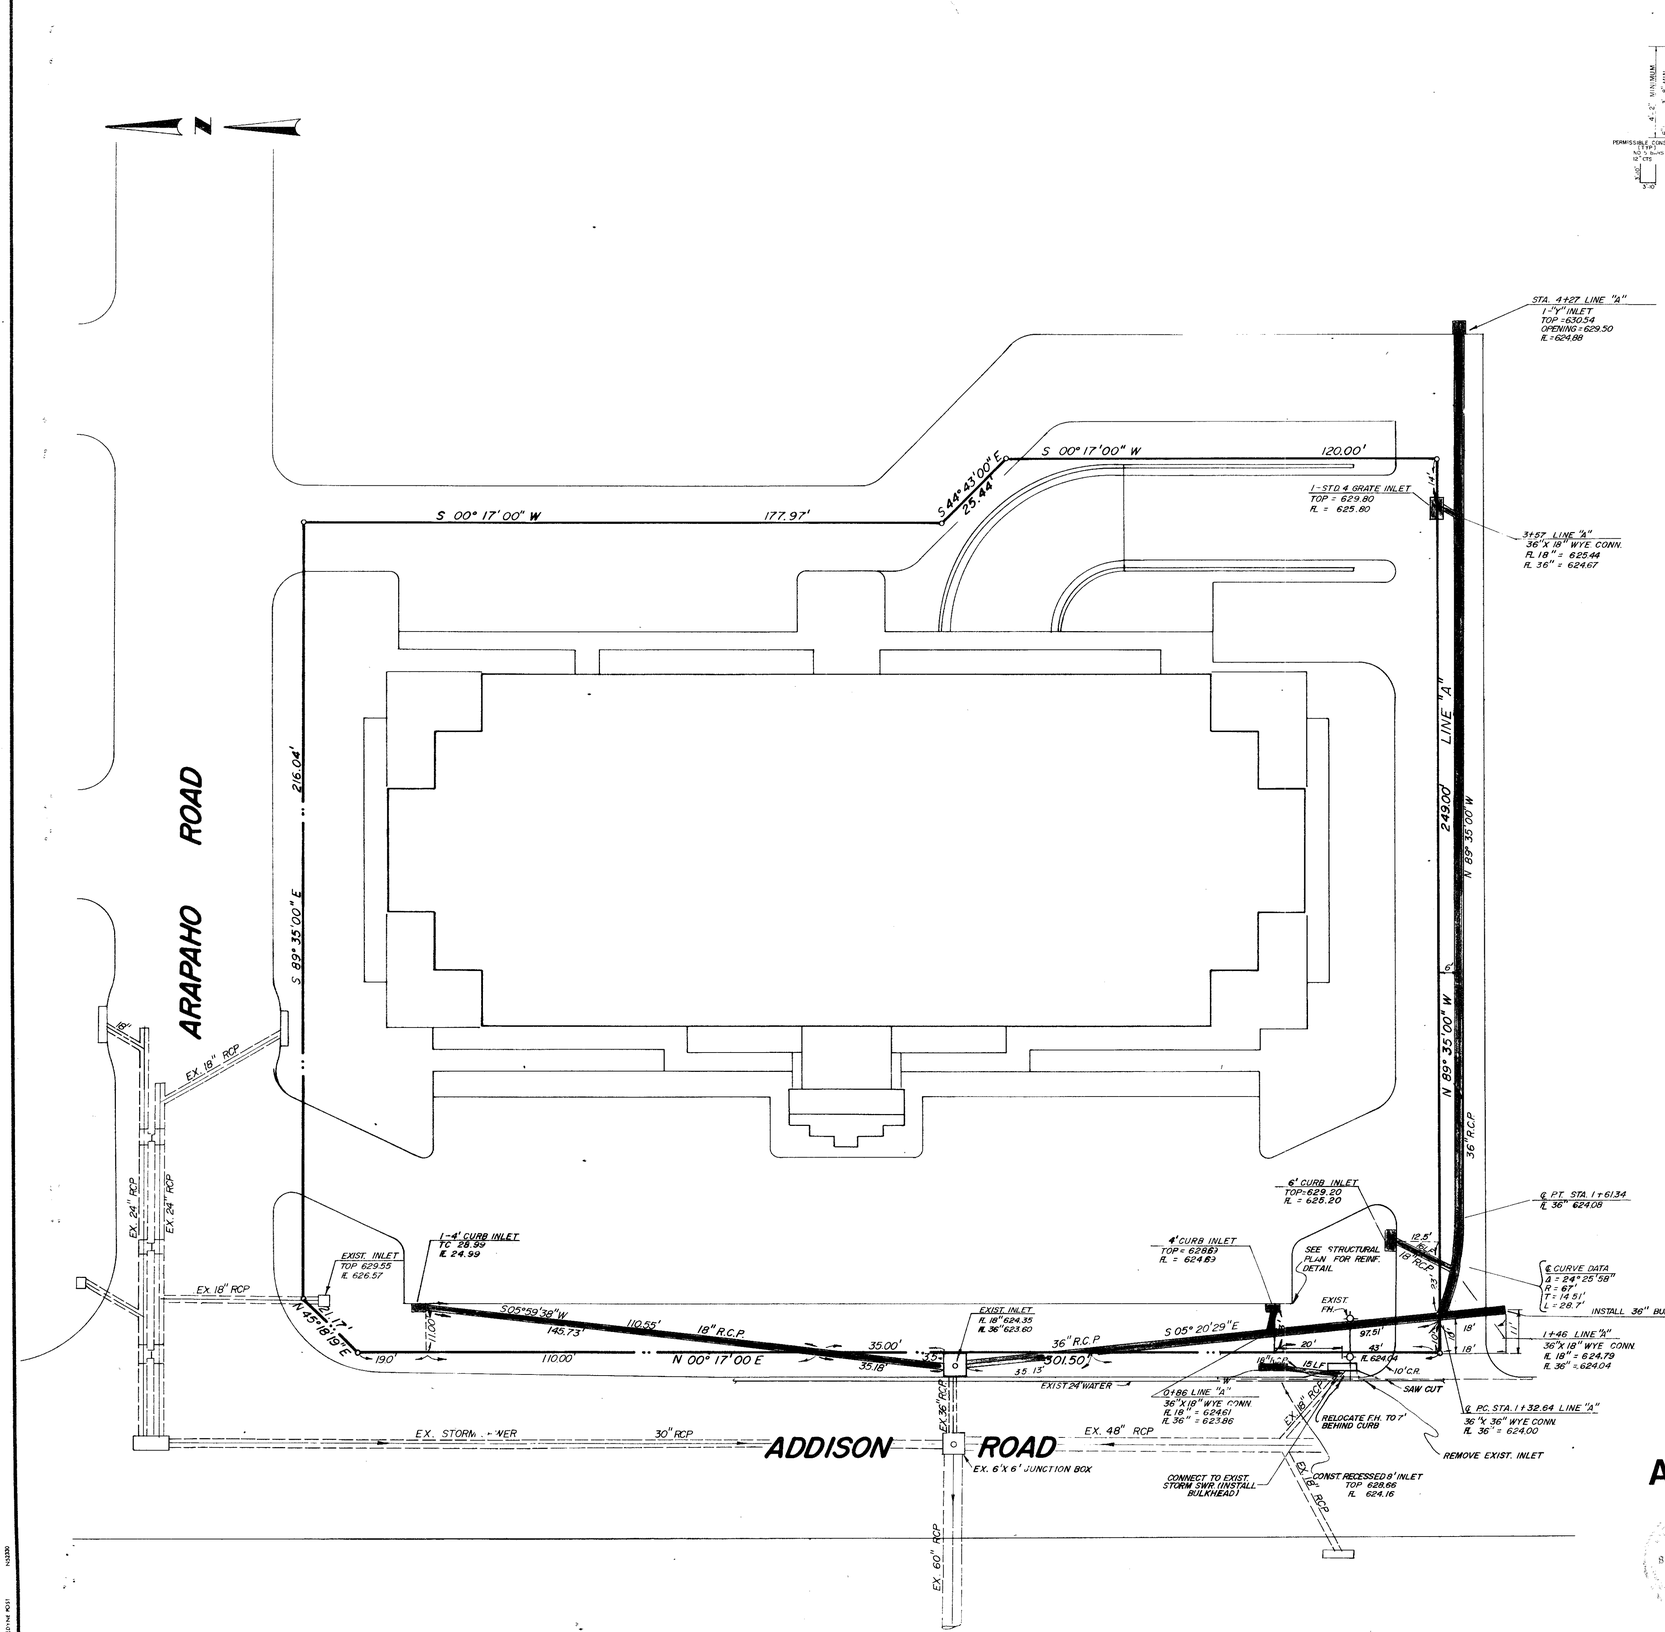

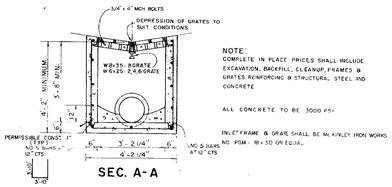

NOTE:
COMPLETE IN PLACE PRICES SHALL INCLUDE EXCAVATION, BACKFILL, CLEANUP, FRAMES & GRATES, REINFORCING & STRUCTURAL STEEL AND CONCRETE

ALL CONCRETE TO BE 3000 PSI

INLET FRAME & GRATE SHALL BE McKINLEY IRON WORKS NO. PDM - 18 x 30 OR EQUAL

SEC. A-A

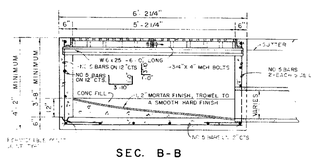

SEC. B-B

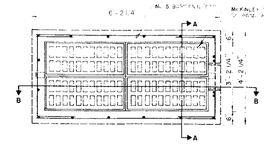

PLAN

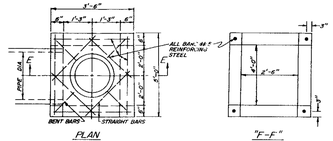

PLAN

"F-F"

ALL CONC. SHALL BE 3000 PSI

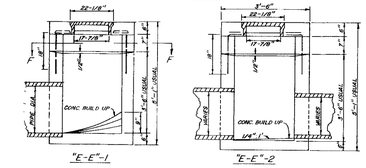

"E-E"-1

"E-E"-2

TYPE "Y" INLET

DEPTH OF INLET MAY VARY TO SUIT CONDITIONS IN FIELD OR AS SPECIFIED ON THE PLANS

GENERAL NOTES - DRAINAGE

1. All work and materials shall be in accordance with current City Standard Specifications.
2. All storm sewer shall be Class III R.C.P.
3. Contractor to verify location of all utilities prior to beginning work and shall protect existing improvements during construction.
4. All trench backfill for storm sewer shall be compacted as required by City, but in no case shall the top 12 inches be compacted to less than 90% Standard Proctor with the remainder being compacted to that of adjoining soil conditions.
5. All fill shall be compacted to 95% Proctor Density in a maximum of six (6) inch lifts.
6. All drainage structures shall be 3000 PSI concrete at 28 days.
7. It will be the responsibility of the contractor to protect all public utilities in the construction of this project. All manholes, cleanouts, valve boxes, fire hydrants, etc., must be adjusted to proper line and grade by the paving contractor prior to and after the placing of permanent paving.

AS-BUILT

B. McWilliams
10/30/85

STATE OF TEXAS
B. McWILLIAMS, JR.
52565
REGISTERED PROFESSIONAL ENGINEER
10/30/85

QUORUM CENTER
STORM SEWER PLAN-PHASE I
TOWN OF ADDISON

JACK R. DAVIS & associates, inc.
consulting civil engineers & surveyors
3535 Travis Street ····· Suite 100
Dallas, Texas 75204 ····· (214) 522-9540

design	drawn	date	scale	notes	job no.	sheet no.
M.P.	R.T.	FEB. 85	1"=20'		C 85.33 M	3 of 7

ELECTRONIC COPY