CONSTRUCTION PLANS FOR:

PAVING AND DRAINAGE IMPROVEMENTS
15841 ADDISON ROAD

ADDISON AIRPORT
ADDISON, TEXAS

SEPTEMBER 2009

PW# 2008-21

PREPARED FOR:
MSF PROPERTIES
TWO LEGACY TOWN CENTER
6900 N. DALLAS PARKWAY, SUITE 730
PLANO, TEXAS 75024
PHONE: (972) 403-0909
CONTACT: RICHARD FRENCH

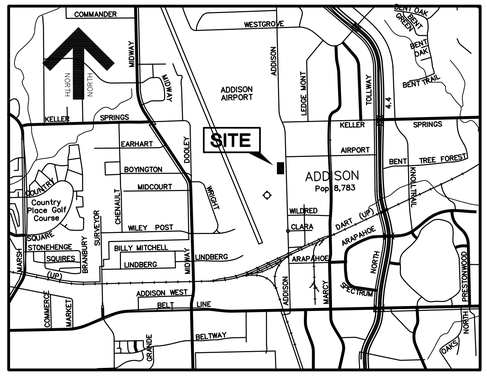

LOCATION MAP
SCALE: 1"=2000'

"AS-BUILT"
THIS AS-BUILT DRAWING IS BASED ON INFORMATION OBTAINED FROM BUILDING CONTRACTORS DURING CONSTRUCTION AS PROVIDED TO JDJR ENGINEERS & CONSULTANTS, INC..
JDJR ENGINEERS & CONSULTANTS, INC. DOES NOT GUARANTEE THE ACCURACY OR COMPLETENESS OF THESE RECORDS.

SHEET INDEX

	COVERSHEET
	PLAT
C1A	SITE DIMENSIONAL CONTROL PLAN
C1B	SITE DIMENSIONAL CONTROL PLAN
C2	DEMOLITION PLAN
C3A	GRADING, DRAINAGE AND PAVING PLAN
C3B	GRADING, DRAINAGE AND PAVING PLAN
C3C	PAVEMENT JOINT PATTERN PLAN
C3D	PAVEMENT JOINT PATTERN PLAN
C4	STORM DRAIN PLAN
C5	STORM DRAIN PROFILE AND DETAILS
C6	FIRE SPRINKLER SERVICE PLAN
C7	EROSION CONTROL PLAN

JDJR ENGINEERS AND CONSULTANTS, INC.
TSBPE REGISTRATION NUMBER F-8527
ENGINEERS • SURVEYORS • LAND PLANNERS
2500 Texas Drive Suite 100 Irving, Texas 75062
Tel 972-252-5357 (JDJR) Fax 972-252-8958

H:\JDJRproj\2008\0824\0824-2 Addison Airport\civil\0824-2-08 CIVIL ADDITIONAL PAVING no sidewalk.dwg, 5/18/2010 8:41:41 AM, JDJR ENGINEERS & CONSULTANTS, INC., - SAS