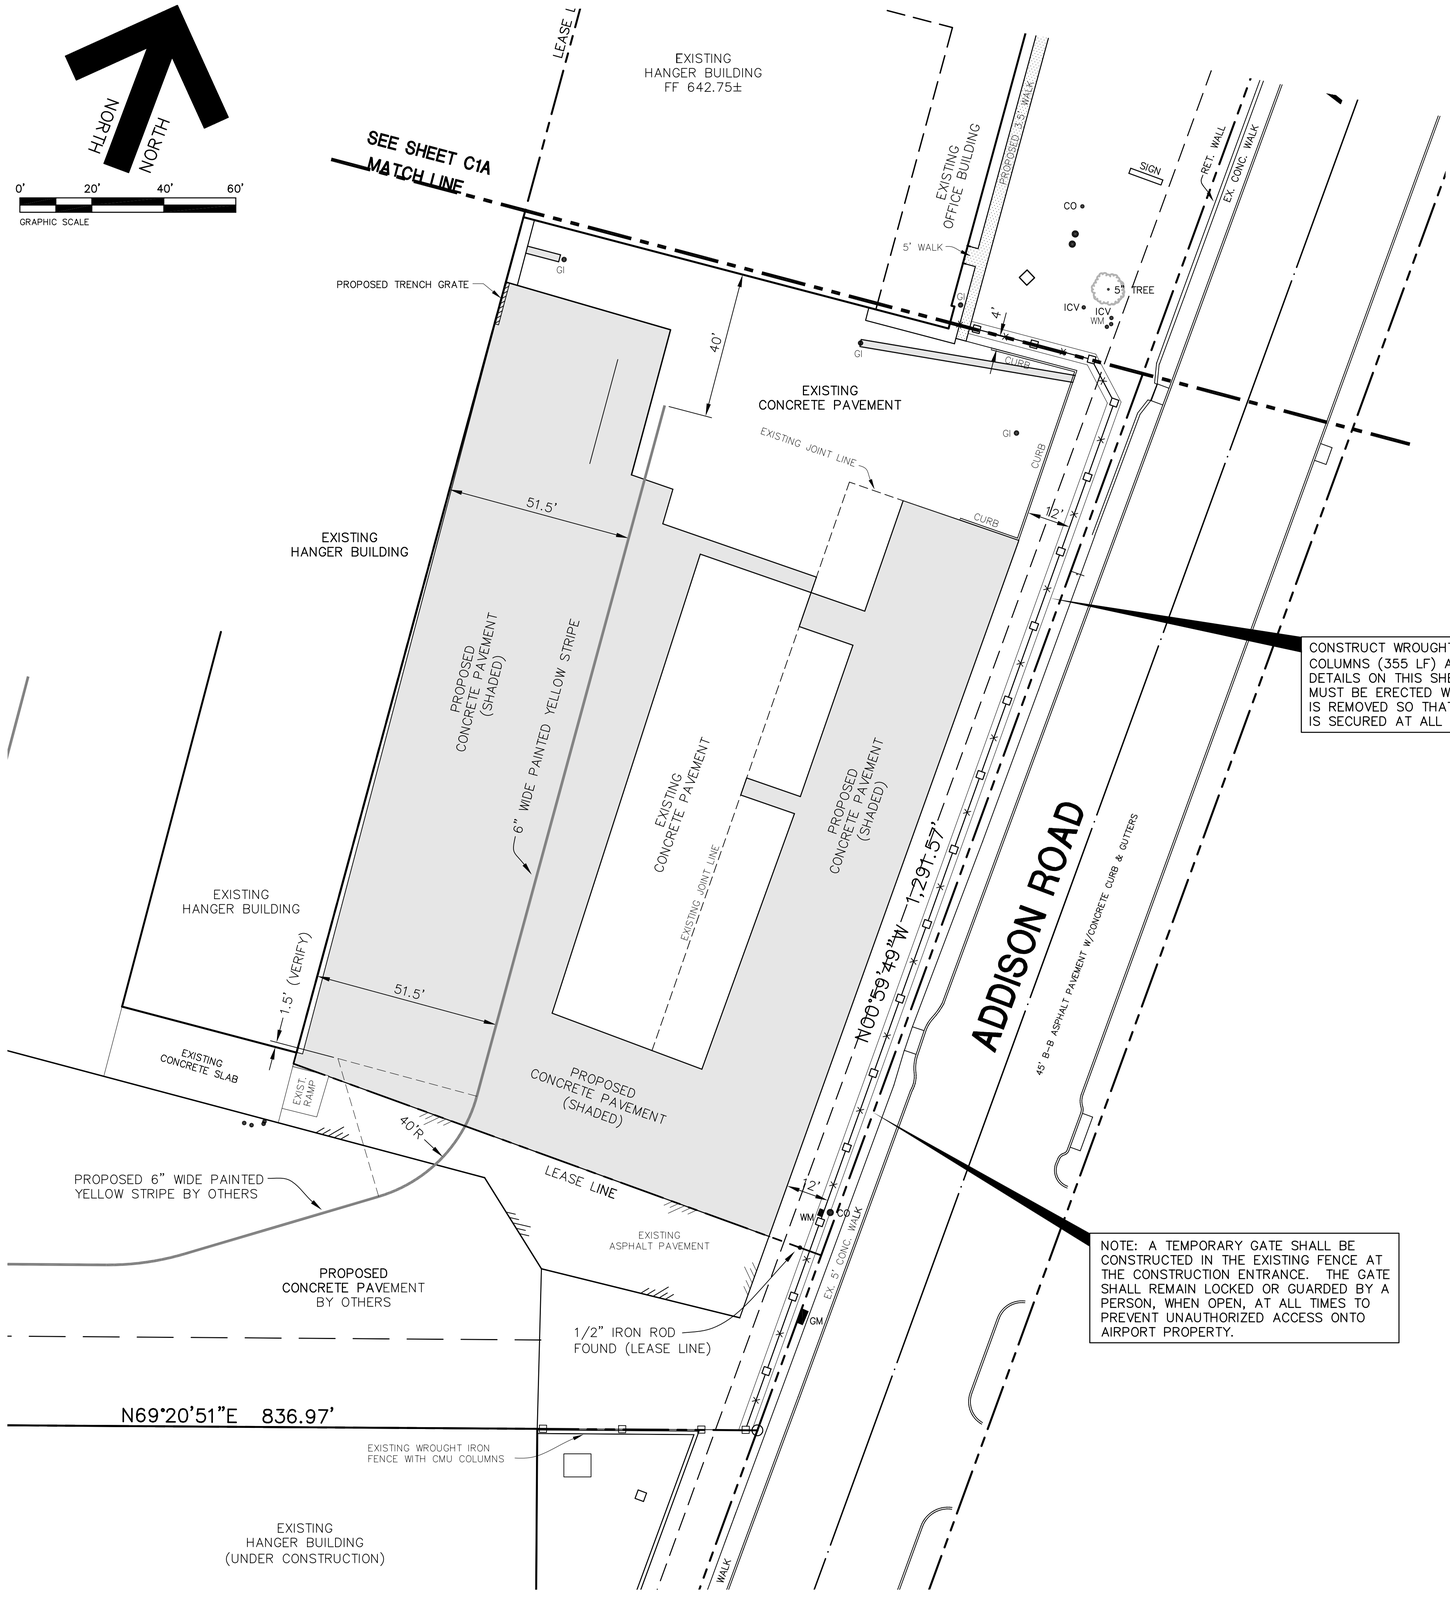

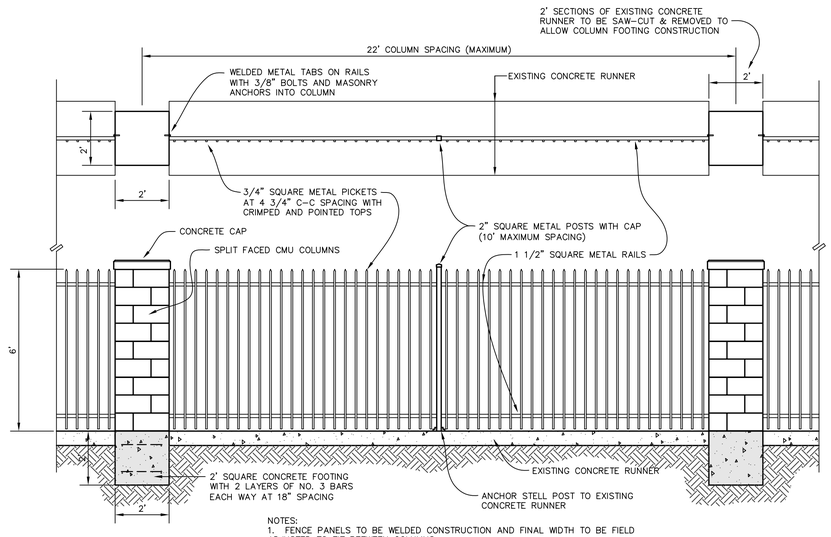

NOTES:
1. FENCE PANELS TO BE WELDED CONSTRUCTION AND FINAL WIDTH TO BE FIELD ADJUSTED TO FIT BETWEEN COLUMNS.
2. CMU COLOR AND STYLE TO MATCH EXISTING FENCE TO THE SOUTH OF THIS PROJECT.
3. ALL METAL POSTS, RAILS AND PICKETS TO BE PRIMED AND PAINTED TO MATCH EXISTING FENCE TO THE SOUTH OF THIS PROJECT.

WROUGHT IRON FENCE DETAIL

NOT TO SCALE

NOTES:

1. ALL CONSTRUCTION TO BE DONE IN STRICT ACCORDANCE TO THESE PLANS AND ALL APPLICABLE MUNICIPAL CODES AND STANDARDS.
2. SEE ARCHITECTURAL PLANS FOR ALL BUILDING DIMENSIONS AND DETAILS.
3. SEE SHEET C-2 FOR ALL SITE DEMOLITION PLAN.
4. SEE SHEET C-3 FOR ALL PAVING AND GRADING PLANS.
5. SEE SHEET C-6 FOR UTILITY PLAN OF THE SITE.
6. SEE SHEET C-7 FOR EROSION CONTROL PLAN OF THE SITE.

AIRCRAFT ACCESS NOTES:

1. THE CONTRACTOR SHALL INSURE THAT THE PAVEMENT SURFACE WITHIN AN ACTIVE AIRCRAFT MOVEMENT AREA IS KEPT CLEAN FROM DIRT, MUD AND OTHER DEBRIS.
2. AT ALL TIMES AIRCRAFT MOVEMENT SHALL HAVE THE RIGHT OF WAY OVER THE CONTRACTOR'S EQUIPMENT.

REVISIONS:	
1/07/09	PER CITY REVIEW
8/11/09	REV FOR CLIENT
9/11/09	PER CITY REVIEW
9/23/09	PER CITY REVIEW
12/18/09	ADDED FENCE
3/10/10	REV. FENCE DTL.
4/13/10	ADD TRENCH GRATE
5/18/10	AS BUILT

STATE OF TEXAS
JAMES DEWEY, JR.
61480
REGISTERED
PROFESSIONAL ENGINEER

"AS-BUILT"
THIS AS-BUILT DRAWING IS BASED ON INFORMATION OBTAINED FROM BUILDING CONTRACTORS DURING CONSTRUCTION AS PROVIDED TO JDJR ENGINEERS & CONSULTANTS, INC..
JDJR ENGINEERS & CONSULTANTS, INC. DOES NOT GUARANTEE THE ACCURACY OR COMPLETENESS OF THESE RECORDS.

SHEET TITLE:
SITE DIMENSIONAL CONTROL PLAN
PAVING AND DRAINAGE IMPROVEMENTS
15841 ADDISON ROAD
ADDISON AIRPORT
ADDISON, TEXAS

JDJR
PREPARED BY:
ENGINEERS AND CONSULTANTS
TSBPE REGISTRATION NUMBER F-8527
ENGINEERS • SURVEYORS • LAND PLANNERS
2500 Texas Drive Suite 100 Irving, Texas 75062
Tel 972-252-5357 Fax 972-252-8958

DATE:	DEC. 2, 2008	DRAWN BY:	SAS	SHEET NO.
SCALE:	1" = 20'	CHECKED BY:	JDJR	C1B OF 7

H:\JDJRproj\2008\924-2 Addison Airport\civil\924-2-08 CIVIL ADDITIONAL PAVING no sidewalk.dwg, 5/18/2010 8:45:42 AM, JDJR ENGINEERS & CONSULTANTS, INC. - SAS