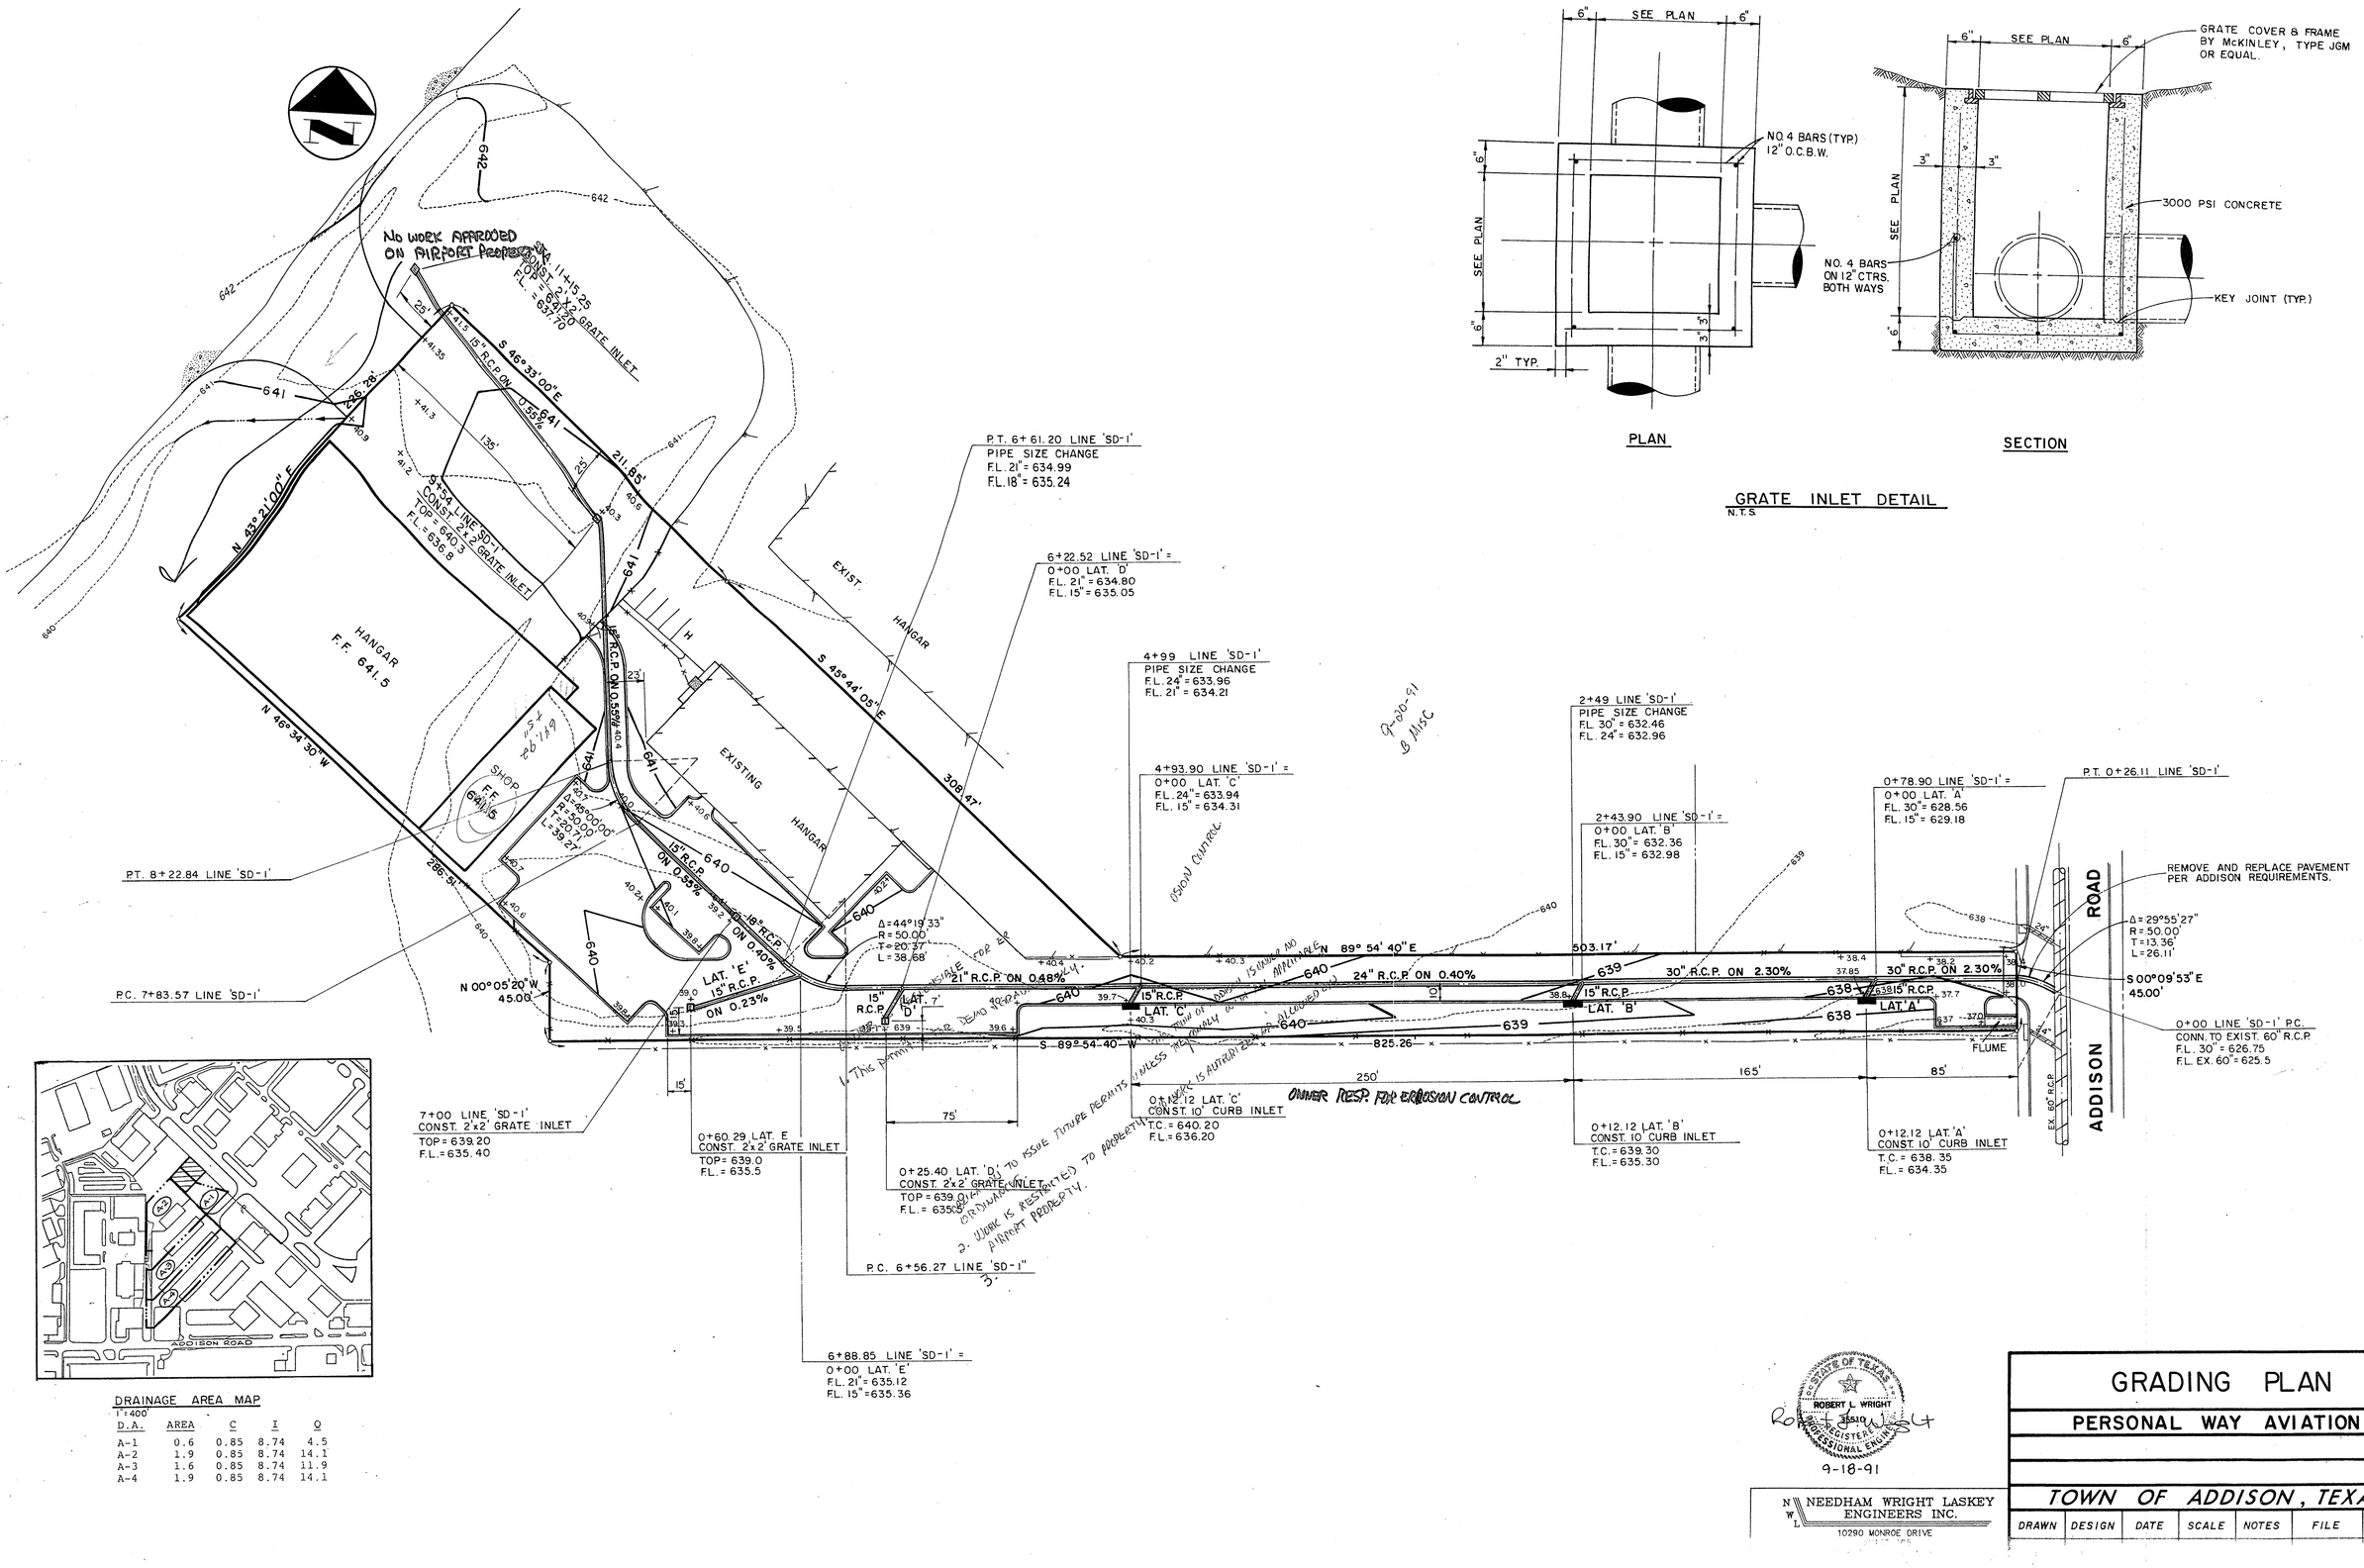

GRATE INLET DETAIL
N.T.S.

DRAINAGE AREA MAP
1"=400'

D.A.	AREA	C	I	Q
A-1	0.6	0.85	8.74	4.5
A-2	1.9	0.85	8.74	14.1
A-3	1.6	0.85	8.74	11.9
A-4	1.9	0.85	8.74	14.1

STATE OF TEXAS
ROBERT L. WRIGHT
35510
REGISTERED PROFESSIONAL ENGINEER
9-18-91

NEEDHAM WRIGHT LASKEY ENGINEERS INC.
10290 MONROE DRIVE

GRADING PLAN

PERSONAL WAY AVIATION

TOWN OF ADDISON, TEXAS

DRAWN	DESIGN	DATE	SCALE	NOTES	FILE	NUMBER