CONSTRUCTION PLANS

FOR

PAVING, DRAINAGE & UTILITIES

ADDISON
OFFICE CONDOS

TOWN OF ADDISON, DALLAS COUNTY, TEXAS

MARCH 2006

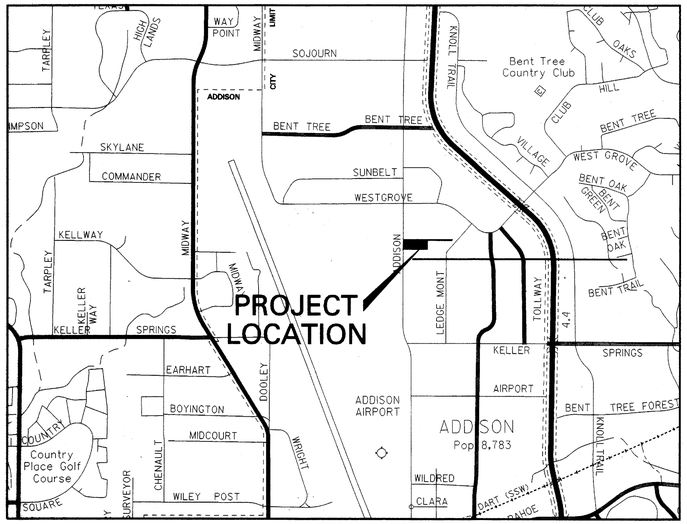

VICINITY MAP
NTS

SHEET INDEX

1	COVER SHEET
2	FINAL PLAT
3	GENERAL NOTES
4	DIMENSION CONTROL PLAN
5	GRADING PLAN
6	PAVING PLAN & PROFILE - SHARED DRIVE A & SHARED DRIVE B
7	PAVING PLAN & PROFILE - SHARED DRIVE C, SHARED DRIVE D & SHARED DRIVE E
8	DRAINAGE AREA MAP
9	STORM DRAIN PLAN & PROFILE - SD-1 & SD-2
10	DETENTION GRADING & INLET DETAIL
11	WATER LAYOUT
12	SANITARY SEWER PLAN & PROFILE
13	TRAFFIC CONTROL
14	EROSION CONTROL
15	HORIZONTAL INLET - TYPE 'H' DETAIL
16	DRAINAGE CALCULATIONS
17	PAVING DETAILS

RECORD DRAWING

THIS DRAWING HAS BEEN MODIFIED TO REFLECT CONSTRUCTION RECORDS PROVIDED TO THE ENGINEER

ENGINEER:

Carter :: Burgess

CARTER & BURGESS, INC.
7950 ELMBROOK DRIVE, SUITE 250
DALLAS, TX. 75247-4951

STATE OF TEXAS
BRYAN P. POWELL
94881
LICENSED
PROFESSIONAL ENGINEER

FF-6

PROJECT NO. 023313.010 C&B FILE NO 01- SHEET 1 OF 17

The seal appearing on this document was authorized by Bryan P. Powell, P.E. 94881, on March 07, 2006. Alteration of a sealed document without proper notification to the responsible engineer is an offense under the Texas Engineering Practice Act.

FF-6

16420 ADDISON RD.

ADDISON OFFICE CONDOS

CONSTRUCTION PLANS

P & G 06/24/05 | UTILS

(DWF=GA:\SLD\023313001\MSGFRA\3Dmodp.dgn - LOG=Image) - ON=43
D&M=GA:\SLD\023313001\MSGFRA\3Dtc00.dgn - ON=43
(DWF=GA:\SLD\023313001\MSGFRA\3Dtc00.dgn - LOG=LAYW) - ON=40,43-45,51-53,56
PRF=\\DAL-SIF-SAMVOL2\P\ATTOOMA\313tc00.prf - ROT=90.000000 - SCALE=20.000000 TBL=O:\PLT-TBL\LANDEXHT.TBL
PLOTTED Thu Mar 09 13:48:39 2006 JOB#=GUNKWONNG USER=tpayton