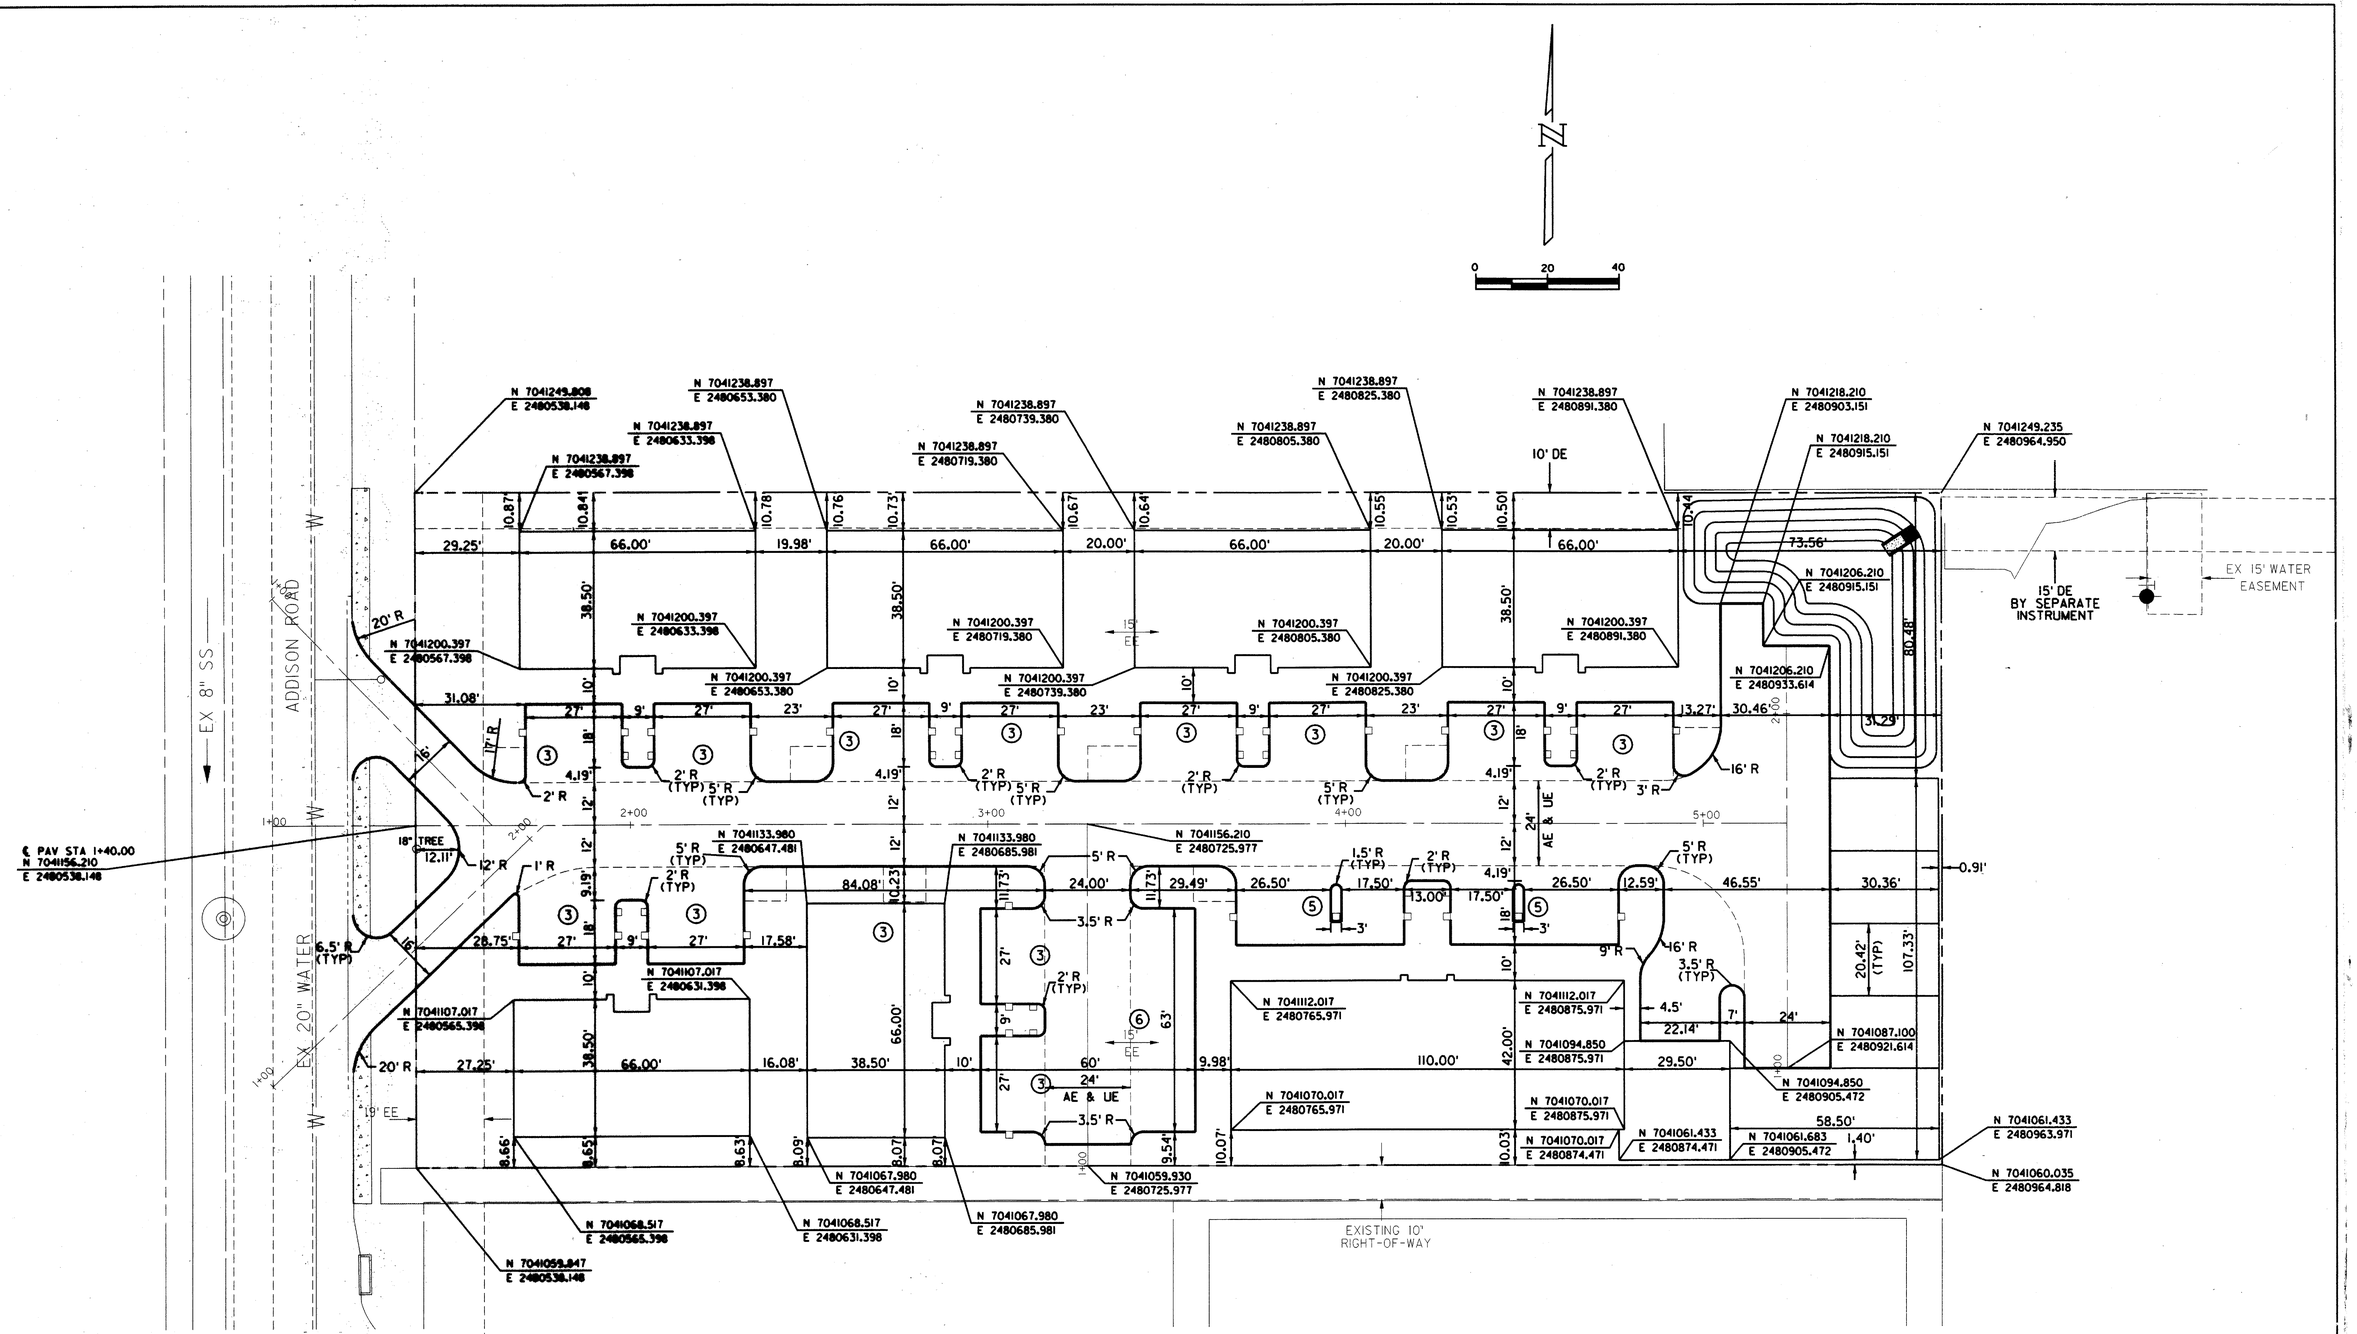

NOTE:
ALL DIMENSIONS ARE TO FACE OF CURB AND OUTSIDE EDGE OF BUILDING

RECORD DRAWING

THIS DRAWING HAS BEEN MODIFIED TO REFLECT CONSTRUCTION RECORDS PROVIDED TO THE ENGINEER

DATE	REVISION	MADE	CKD	APPD

Carter=Burgess

Carter & Burgess, Inc. 7950 Elmbrook Drive Dallas, Texas 75247-4961
(214) 638-0145 Metro (214) 263-2019 Fax (214) 638-0447

DIMENSION CONTROL PLAN
ADDISON OFFICE CONDOS

TOWN OF ADDISON, DALLAS COUNTY, TEXAS

DESIGN	DRAWN	CHECKED	SCALE	DATE	FILE	NO.
TIPTON		POWELL	1" = 20'	MARCH'06	01-6628	4 OF 17

BRYAN P. POWELL 94881 LICENSED PROFESSIONAL ENGINEER

The seal appearing on this document was authorized by Bryan P. Powell, P.E. 94881, on March 07, 2006. Alteration of a sealed document without proper notification to the responsible engineer is an offense under the Texas Engineering Practice Act.

C&B JOB No. 023313010

DGN=d:\SLD\023313010\MSGRA\313dc01.dgn - GN=1-56
USER=TIPTON - SCALE=20.000000 TBL=d:\PLT-TBL\LMDC1NT.TBL
PWP=\\DAL-SRS-SAN1\GL2\WORKGROUP\MSGRA\313dc01.dgn - ROT=90.000000 - SCALE=20.000000
PLOTTED Thu Mar 09 13:46:48 2006