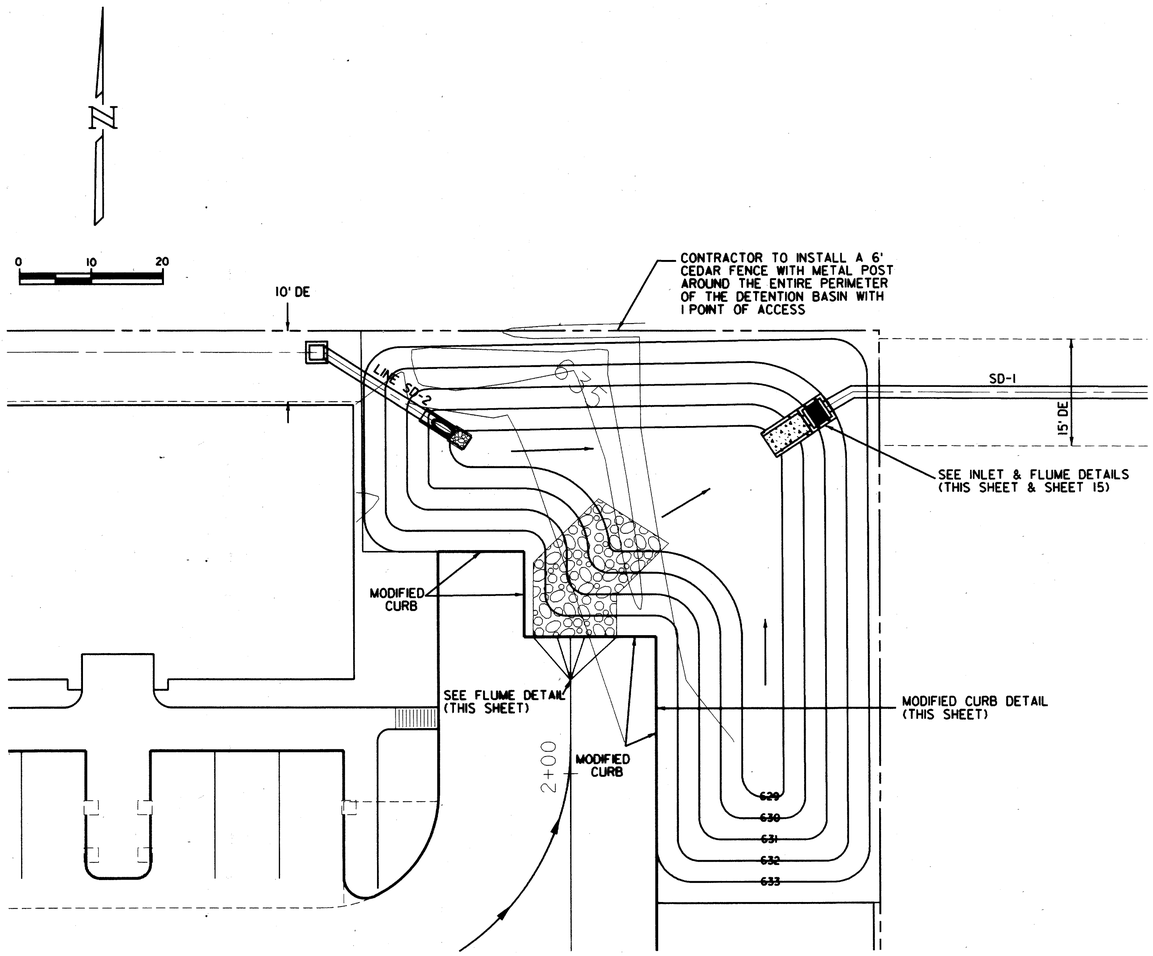

DETENTION BASIN
BOTTOM GRADING
SCALE = 1" = 10'

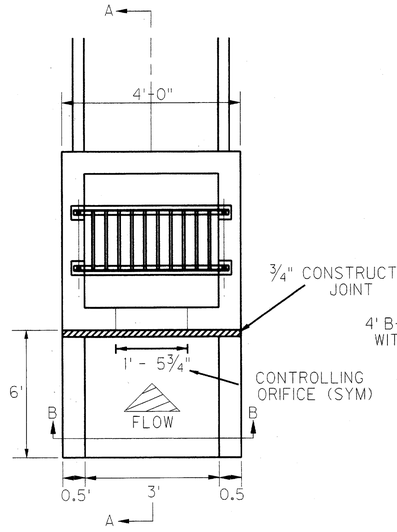

PLAN VIEW
N.T.S.

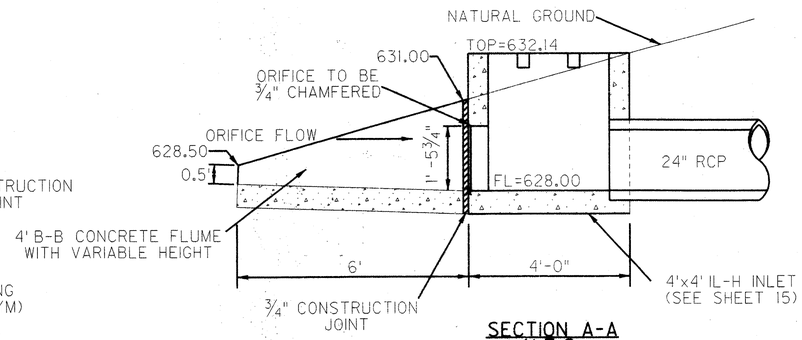

SECTION A-A
N.T.S.

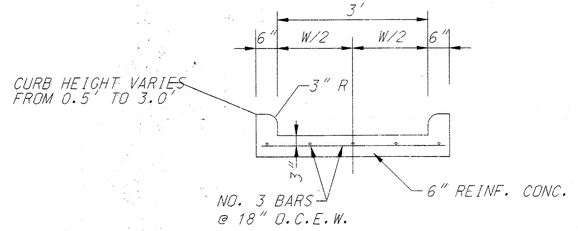

SECTION B-B

INLET AND FLUME DETAILS
N.T.S.

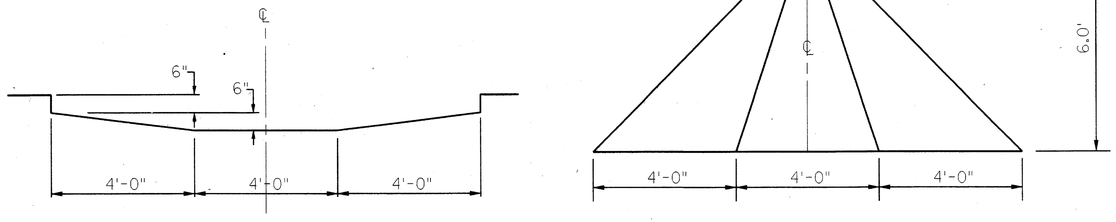

STREET FLUME DETAILS
N.T.S.

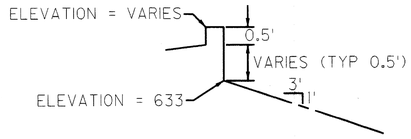

MODIFIED CURB AROUND DETENTION POND
N.T.S.

BENCHMARKS

1.) "" CUT ON INLET SW CORNER OF RATLIFF AND ADDISON ROAD.
ELEV. 637.20

2.) "" CUT ON INLET EAST SIDE OF ADDISON ROAD, 20' 35/64 SOUTH OF THE SOUTHWEST CORNER OF SUBJECT TRACT.
ELEV. 637.92

RECORD DRAWING

THIS DRAWING HAS BEEN MODIFIED TO REFLECT CONSTRUCTION RECORDS PROVIDED TO THE ENGINEER

DATE	REVISION	MADE	CKD	APPD

Carter-Burgess
Carter & Burgess, Inc. 7950 Elmbrook Drive Dallas, Texas 75247-4961
(214) 638-0145 Metro (214) 263-2019 Fax (214) 638-0447

DETENTION GRADING & INLET DETAIL
ADDISON OFFICE CONDOS

TOWN OF ADDISON, DALLAS COUNTY, TEXAS

DESIGN	DRAWN	CHECKED	SCALE	DATE	FILE	NO.
TIPTON	SPONSEL	POWELL	1" = 20'	MARCH'06	01-6628	10 OF 17

STATE OF TEXAS — PYOTR I. GULER — 87141 — LICENSED PROFESSIONAL ENGINEER — 3-9-06

The seal appearing on this document was authorized by Pyotr I. Guler, P.E. 87141, on March 09, 2006. Alteration of a sealed document without proper notification to the responsible engineer is an offense under the Texas Engineering Practice Act.

DGN=d:\SLD\023350\MSGRA\313dt01.dgn - ONH-56
C&B JOB No. 023513010
(DRF=d:\SLD\023350\MSGRA\350dr01.dgn - LOG=DET1 - ONH=6.8-33.36-44.46-55.62.63
(DRF=d:\SLD\023350\MSGRA\331ph04.dgn - LOG=TB - ONH=2,4,46
PRF=\\DAI-SS2\SANFILE\PW ATTOOOM\331dt04.prf - ROT=90.000000 - SCALE=20.000000 TIBLOG\PLT-TIBLLANDEWHT.tbl
USER=tipton JOB#=HUMMONNI PLOTTED Thu Mar 09 13:08:53 2006
(DRF=d:\SLD\023350\MSGRA\350ss00.dgn - LOG=LAB1 - ONH=7.12-26.36.38.42.71.10-34.35.44.45
DGN=d:\SLD\023350\MSGRA\331dt01.dgn - ONH-56