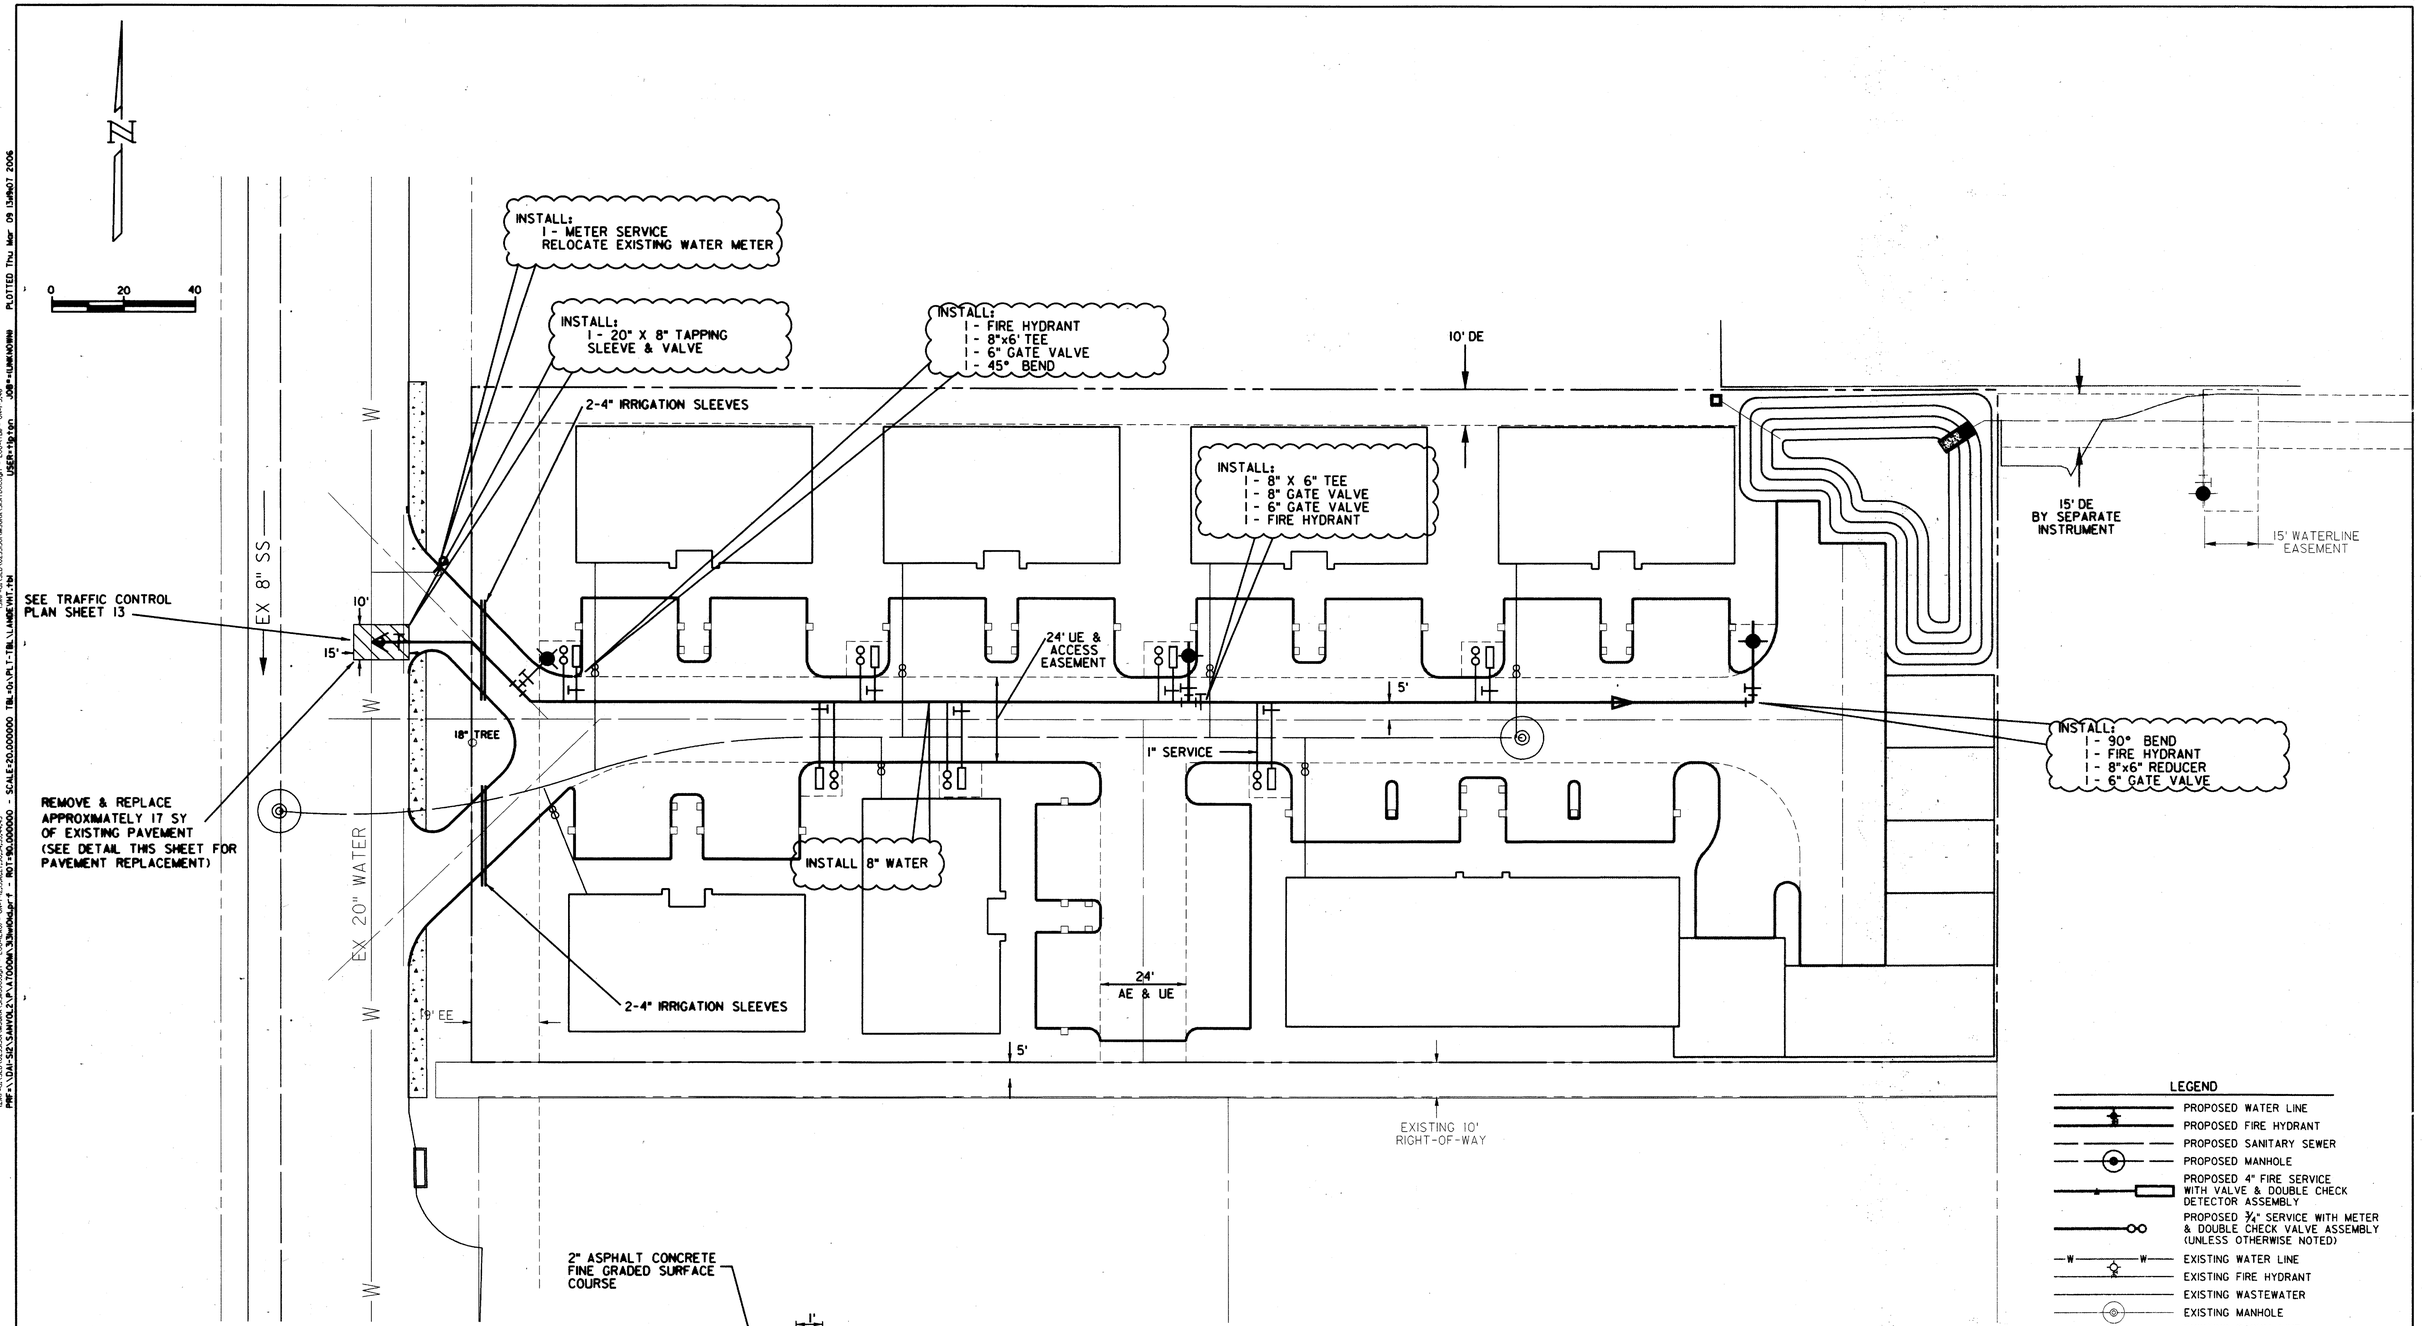

RECORD DRAWING

THIS DRAWING HAS BEEN MODIFIED TO REFLECT CONSTRUCTION RECORDS PROVIDED TO THE ENGINEER

DATE	REVISION	MADE	CKD	APPD

Carter Burgess

Carter & Burgess, Inc. 7950 Elmbrook Drive Dallas, Texas 75247-4961
(214) 638-0145 Metro (214) 263-2019 Fax (214) 638-0447

WATER LAYOUT

ADDISON OFFICE CONDOS

TOWN OF ADDISON, DALLAS COUNTY, TEXAS

DESIGN	DRAWN	CHECKED	SCALE	DATE	FILE	NO.
TIPTON	SPONSEL	POWELL	1" = 20'	MARCH'06	01-6628	11 OF 17

BRYAN P. POWELL 94881 LICENSED PROFESSIONAL ENGINEER

DGN=d:\SLD\0233130\MSGRA\3131W10.dgn - ON=1-56

The seal appearing on this document was authorized by Bryan P. Powell, P.E. 94881, on March 07, 2006. Alteration of a sealed document without proper notification to the responsible engineer is an offense under the Texas Engineering Practice Act.

C&B JOB No. 023313.010

I:\INF=d:\SLD\0233130\MSGRA\xrefs\SET.dgn - LOG=(ANT) - ON=1,7,8,9,15,21,23,33,34,37,44,52
I:\INF=d:\SLD\0233130\MSGRA\xrefs\notes.dgn - LOG=(ALL) - ON=1,7,8,15,21,23,33,34,44,52
I:\INF=d:\SLD\0233130\MSGRA\xrefs\notes.dgn - LOG=(ALL) - ON=1-5
DGN=d:\SLD\0233130\MSGRA\3131W10.dgn - ON=1-56