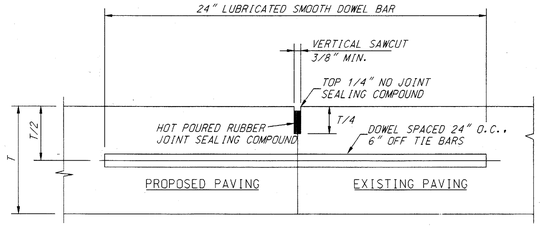

NOTE:
1. T-8" AND GREATER NO. 6 BAR. T-6" AND LESS NO. 5 BAR
2. LONGITUDINAL BUTT CONSTRUCTION MAY BE UTILIZED IN PLACE OF LONGITUDINAL HINGED (KEYWAY) JOINT AT CONTRACTORS OPTION.
3. DOWEL BARS SHALL BE DRILLED INTO PAVEMENT HORIZONTALLY BY USE OF A MECHANICAL RIG. HAND DRILLING NOT ACCEPTABLE. DAMAGE TO EXISTING PAVEMENT SHALL BE REMOVED BY CONTRACTOR AND JOINT CONSTRUCTED AT CONTRACTORS EXPENSE.
4. DOWEL BAR SHOWN IS IN ADDITION TO TIE BARS (12" O.C.-6" OFF DOWELS).
5. TIE BARS SHALL BE NO. 5 BAR DEFORMED. TIE BAR SHALL HAVE A LENGTH OF 24 INCHES.

LONGITUDINAL BUTT JOINT

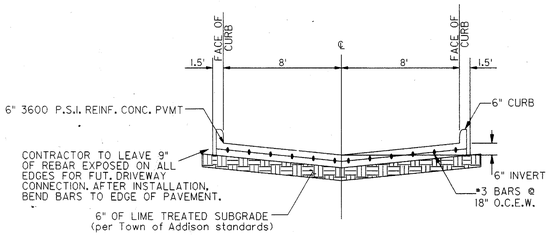

TYPICAL SECTION SHARED DRIVE D & E

N.T.S.

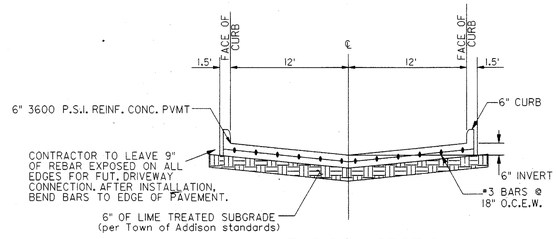

TYPICAL SECTION SHARED DRIVE A,B, & C

N.T.S.

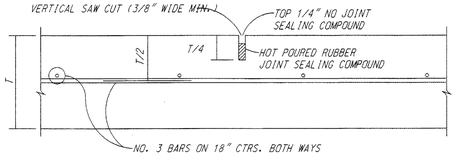

TRANSVERSE JOINTS SPACED 15 FT. C.-C. (MAX.)
LONGITUDINAL JOINTS SPACED 20 FT. C.-C. (MAX.)

SAWED DUMMY JOINT

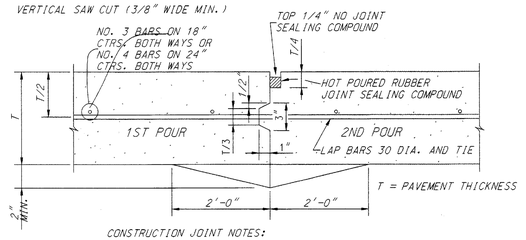

CONSTRUCTION JOINT NOTES:
1. CONTRACTOR SHALL PROTECT KEYWAY PRIOR TO SECOND POUR. IF LONGITUDINAL KEYWAY IS DAMAGED, CONTRACTOR SHALL REPAIR WITH THE USE OF LONGITUDINAL BUTT JOINT (DRILL DOWELS INTO FIRST POUR).
2. THICKENED EDGES ARE REQUIRED FOR FUTURE WIDENING ONLY.

CONSTRUCTION JOINT

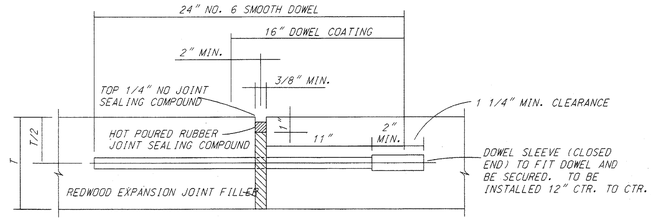

TRANSVERSE EXPANSION JOINT NOTES:
1. DOWELS AND REINFORCING BARS SHALL BE SUPPORTED BY AN APPROVED DEVICE.
2. TRANSVERSE EXPANSION JOINTS SHALL BE SPACED AT 60 FT. MAXIMUM AND AT ALL INTERSECTIONS.

TRANSVERSE EXPANSION JOINT

RECORD DRAWING
THIS DRAWING HAS BEEN MODIFIED TO REFLECT CONSTRUCTION RECORDS PROVIDED TO THE ENGINEER

DATE	REVISION	MADE	CKD	APPD

Carter=Burgess
Carter & Burgess, Inc. 7950 Elmbrook Drive Dallas, Texas 75247-4961
(214) 638-0145 Metro (214) 263-2019 Fax (214) 638-0447

PAVING DETAILS

ADDISON OFFICE CONDOS

TOWN OF ADDISON, DALLAS COUNTY, TEXAS

DESIGN	DRAWN	CHECKED	SCALE	DATE	FILE	NO.
TIPTON	GUERIN	POWELL	1" = 20'	MARCH'06	01-6628	17 OF 17

BRYAN P. POWELL 94881 LICENSED PROFESSIONAL ENGINEER

DGN=d:\SLD\023330\MSGRA\303pd1.dgn - ON=1-56

The seal appearing on this document was authorized by Bryan P. Powell, P.E. 94881, on March 07, 2006. Alteration of a sealed document without proper notification to the responsible engineer is an offense under the Texas Engineering Practice Act.

C&B JOB No. 023313010

USER=tipton JOB=UNKNOWN PLOTTED Thu Mar 09 13:19:00 2006
DGN=d:\SLD\023330\MSGRA\303pd1.dgn - ON=1-56
PRF=\\DAI-SVC1\WP02\PW_ATTOOOM.303prf01.prf - ROT=90.000000 - SCALE=20.000000 TBL=O:\PLT-TBL\LWDEVHT.tbl
DGN=d:\SLD\023330\MSGRA\sections.dgn - LOG=LAB - ON=17-25,45,62,67,90,94,95,44,46