BENCHMARKS

1.) "" CUT ON INLET SW CORNER OF RATLIFF AND ADDISON ROAD.
ELEV. 637.20

2.) "" CUT ON INLET EAST SIDE OF ADDISON ROAD, 20' 35/64 SOUTH OF THE SOUTHWEST CORNER OF SUBJECT TRACT.
ELEV. 637.92

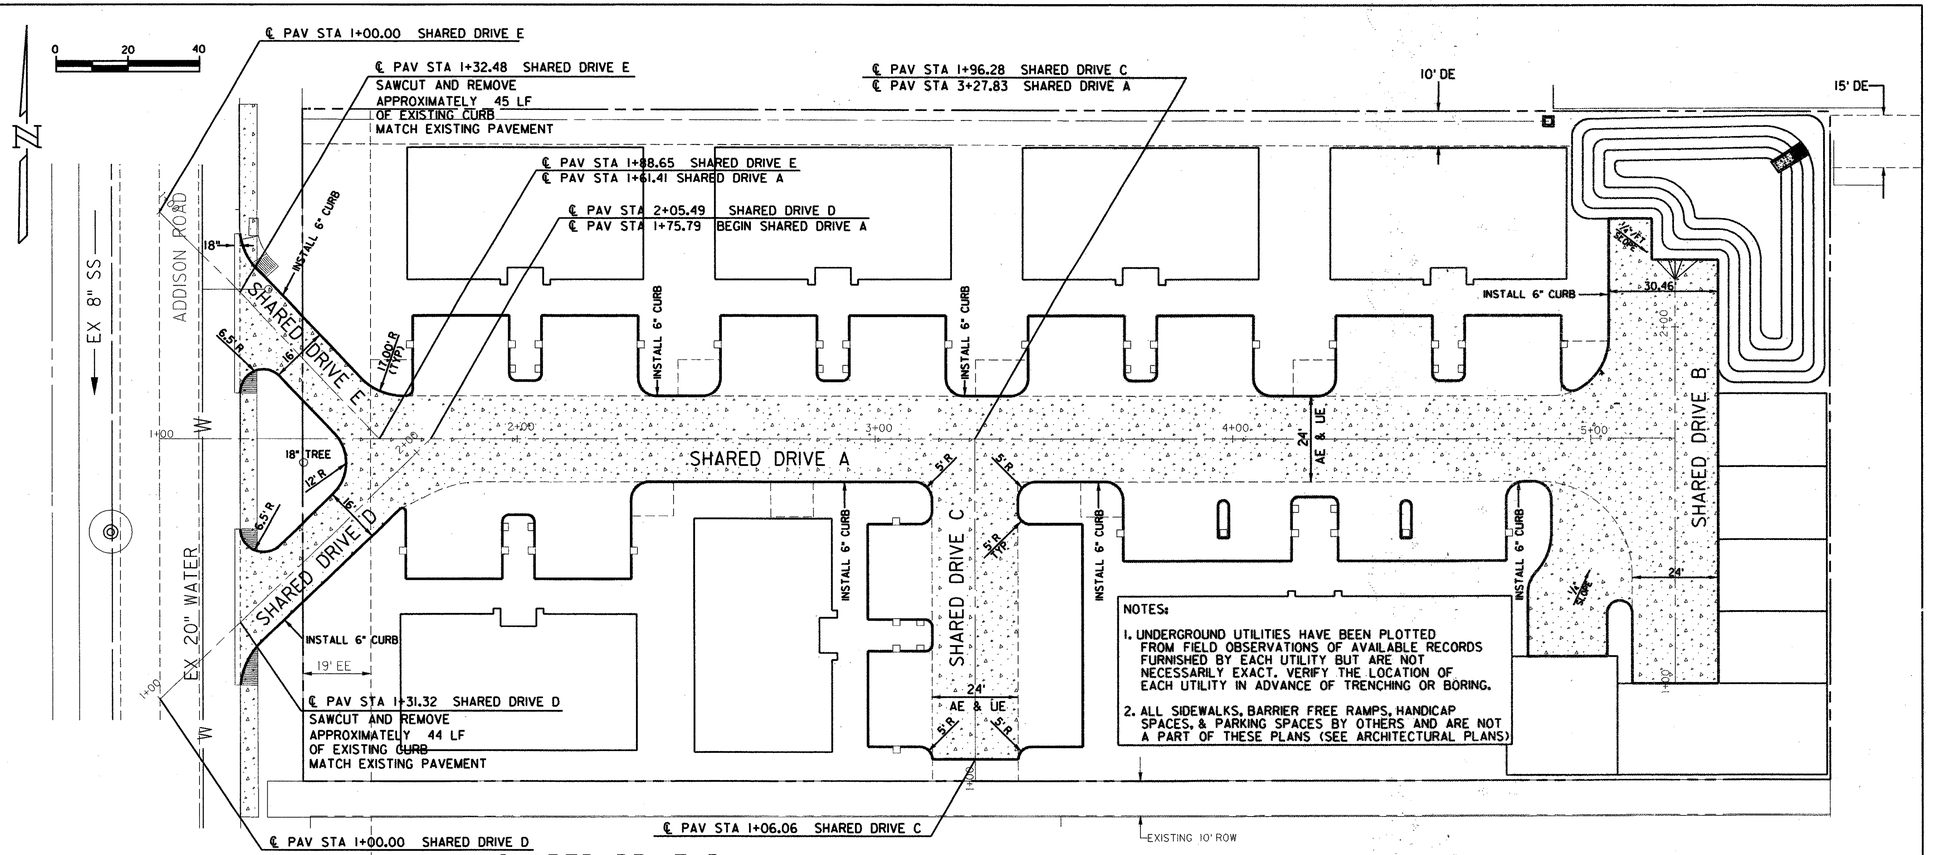

SHARED DRIVE C

SHARED DRIVE D

SHARED DRIVE E

RECORD DRAWING

THIS DRAWING HAS BEEN MODIFIED TO REFLECT CONSTRUCTION RECORDS PROVIDED TO THE ENGINEER

DATE	REVISION	MADE	CKD	APPD

Carter=Burgess

Carter & Burgess, Inc. 7950 Elmbrook Drive Dallas, Texas 75247-4961
(214) 638-0145 Metro (214) 263-2019 Fax (214) 638-0447

PAVING PLAN & PROFILE

ADDISON OFFICE CONDOS

SHARED DRIVE C, SHARED DRIVE D & SHARED DRIVE E

TOWN OF ADDISON, DALLAS COUNTY, TEXAS

DESIGN	DRAWN	CHECKED	SCALE	DATE	FILE	NO.
TIPTON	SPONSEL	POWELL	1" = 20' H 1" = 4' V	MARCH'06	01-6628	7 OF 17

STATE OF TEXAS
BRYAN P. POWELL
94881
LICENSED PROFESSIONAL ENGINEER

The seal appearing on this document was authorized by Bryan P. Powell, P.E. 94881, on March 07, 2006. Alteration of a sealed document without proper notification to the responsible engineer is an offense under the Texas Engineering Practice Act.

C&B JOB No. 023313.010

DGN=d:\SLD\023313.01\MSGRA\313pp03.dgn - ON=1-56

PLOTTED Thu Mar 09 13:59:02 2006
USER=TIPTON JOB#=DUNKNOWN
- SCALE=20.000000TBL=d:\PLT-TBL\LANDEXHT.TBL - ROT=90.000000