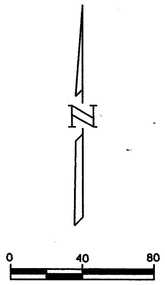

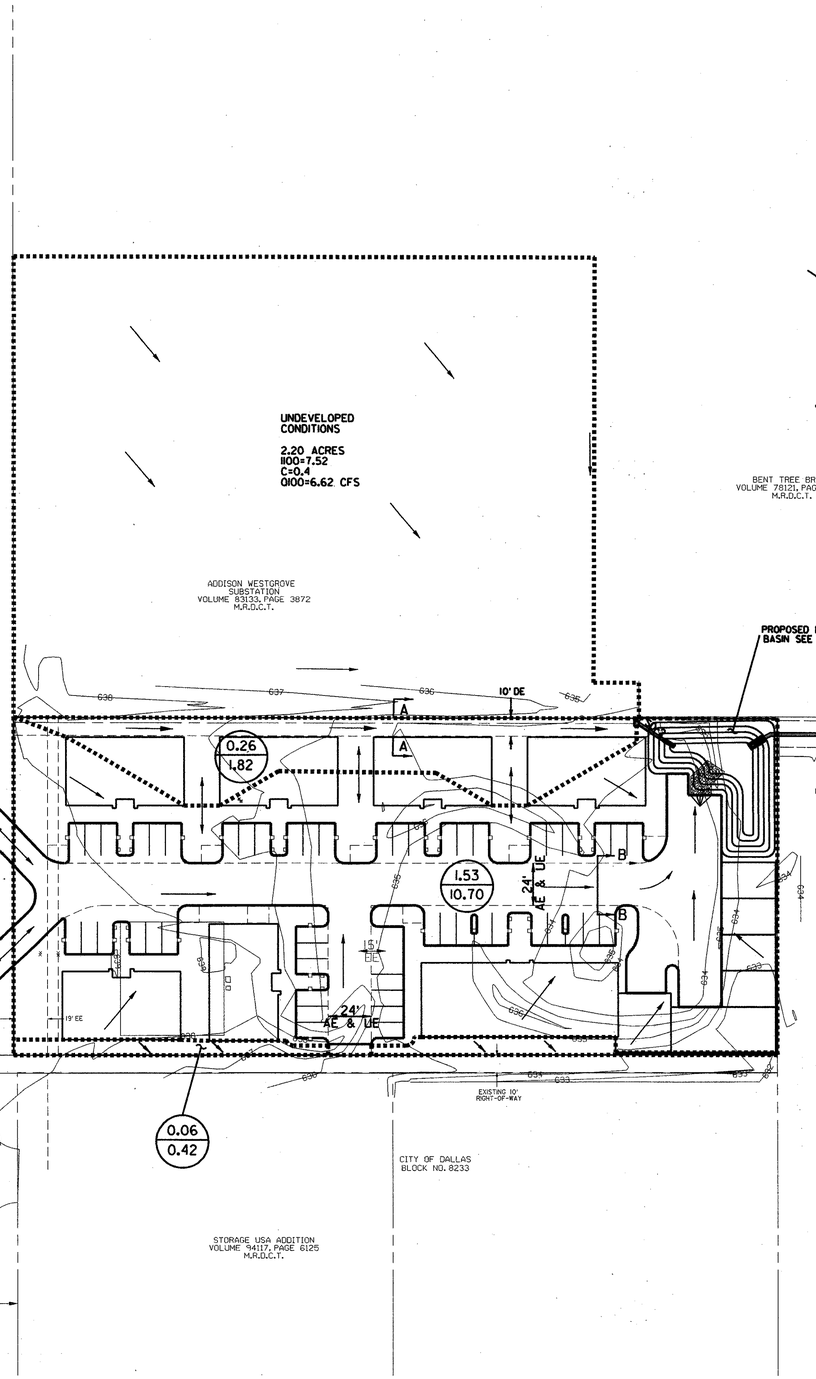

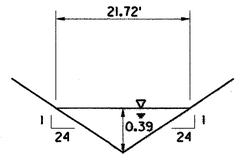

INVERT SECTION B-B

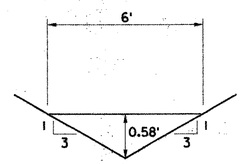

SECTION A-A

Q100 = 1.83 CFS
S = 0.77%
V = 1.83 FPS
d = 0.58 FT

DRAINAGE DESIGN CRITERIA
RATIONAL METHOD
100 YEAR DESIGN

Q = C I A
Q = FLOW IN CUBIC FEET PER SECOND = CFS
C = RUNOFF COEFFICIENT = 0.80
I = INTENSITY WITH TIME OF CONCENTRATION OF 15 MINUTES = 7.52
I = INTENSITY WITH TIME OF CONCENTRATION OF 10 MINUTES = 8.74
A = DRAINAGE AREA = AREA IN ACRES

LEGEND

- PROPOSED STORM DRAIN LINE W/INLET
- DRAINAGE DIVIDE
- (9W) INLET NUMBER
- FLOW DIRECTION
- AREA IN ACRES / Q100 IN CFS (8.88 / 55.5) DRAINAGE AREA
- DRAINAGE SWALE

RECORD DRAWING

THIS DRAWING HAS BEEN MODIFIED TO REFLECT CONSTRUCTION RECORDS PROVIDED TO THE ENGINEER

DATE	REVISION	MADE	CKD	APPD

Carter=Burgess
Carter & Burgess, Inc. 7950 Elmbrook Drive Dallas, Texas 75247-4961
(214) 638-0145 Metro (214) 263-2019 Fax (214) 638-0447

DRAINAGE AREA MAP
ADDISON OFFICE CONDOS

TOWN OF ADDISON, DALLAS COUNTY, TEXAS

DESIGN	DRAWN	CHECKED	SCALE	DATE	FILE	NO.
TIPTON		POWELL	1" = 40'	MARCH'06	01-6628	8 OF 17

STATE OF TEXAS — BRYAN P. POWELL — 94881 — LICENSED PROFESSIONAL ENGINEER

DGN=I:\SLD\0233130\MSGRA\313dd01.dgn - ON=1-56

The seal appearing on this document was authorized by Bryan P. Powell, P.E. 94881, on March 07, 2006. Alteration of a sealed document without proper notification to the responsible engineer is an offense under the Texas Engineering Practice Act.

C&B JOB No. 023313.010

I:\SLD\0233130\MSGRA\339dd01.dgn - LOG=(EF3) - ON=1,3-16,18,20-58
I:\SLD\0233130\MSGRA\339dd02.dgn - LOG=(EF3) - ON=1,3-16,18,20-58
I:\SLD\0233130\MSGRA\339dd03.dgn - LOG=(EF3) - ON=1,3-16,18,20-58
C:\PRF=I:\SLD\0233130\MSGRA\339dd00.dgn - LOG=(ndi - ON=1,8,10,15&,17,29-31,34,35,44,56
PRF=\\DAI-S12\SANV0L2\P\A1000M\339dd00.prf - ROT=90.000000 - SCALE=40.000000 TBL=I:\SLD\0233130\MSGRA\339dd00.tbl - ON=1-56
USER=tiptonJOB#=(UNKNOWN) PLOTTED Thu Mar 09 13:48:44 2006
