

**BENT TREE GARDENS PHASE 2**



**wahlberg-morales and associates architects**  
Houston, Texas 77027  
628-0880

3202 Westlynn  
Houston, Texas 77027

REV. 2:	8/15/79
REV. 1:	7-27-79
DATE:	8/18/79
DRAWN:	
COMM:	1076

**2.5**

**legend**

sanitary sewer

water distrib.

INDICATES DIRECTION OF CLEANOUT

4" TURBO METER OR 6" STANDARD METER OR MANIFOLD (8) 2" METERS


INDICATES CLEANOUT AND TWO CHECK VALVES

clean out detail



San. Sewer Water

site

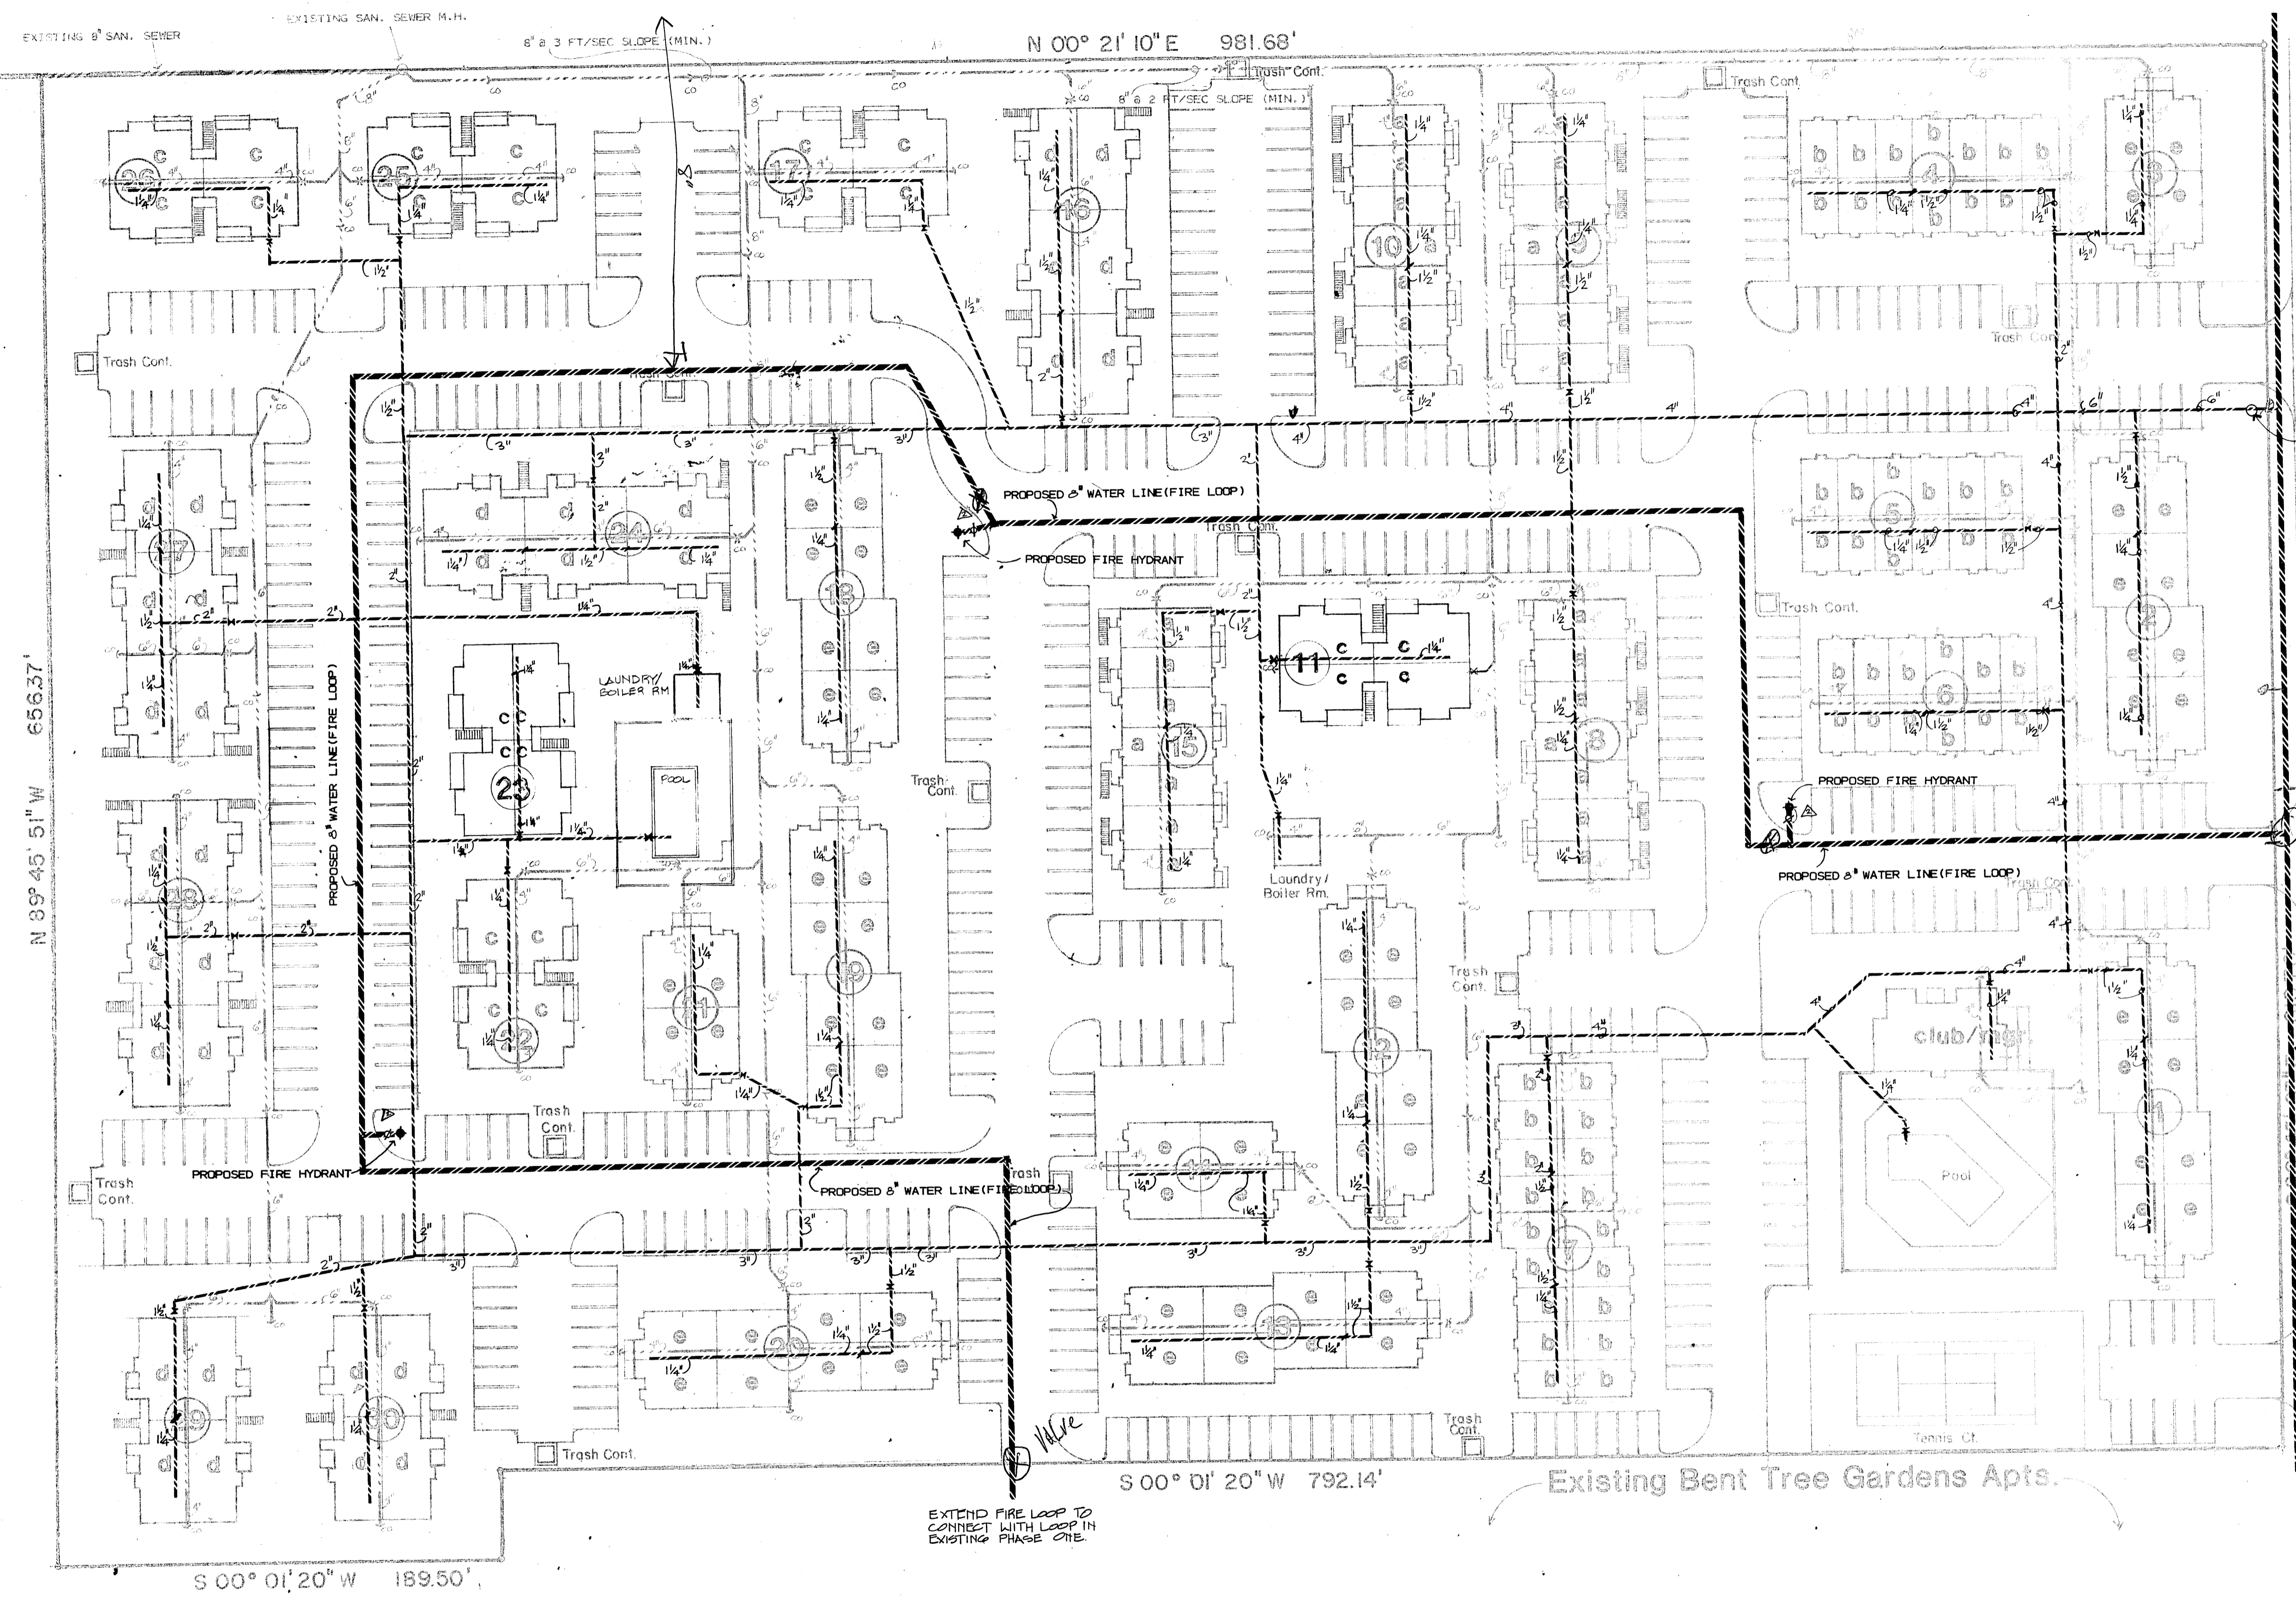

EXISTING 8" SAN. SEWER  
EXISTING SAN. SEWER R.H.  
8" @ 3 FT/SEC SLOPE (MIN.)

N 00° 21' 10" E 981.68'


S 00° 01' 20" W 189.50'

S 00° 01' 20" W 792.14'

Existing Bent Tree Gardens Apts.

EXTEND FIRE LOOP TO CONNECT WITH LOOP IN EXISTING PHASE ONE

TAPPING VALVE  
Copper wire

Bank of America	-----
New York Life	-----
Owner	-----