NOTE: VAULT SHALL MEET ALL REQUIREMENTS PER TOWN OF ADDISON

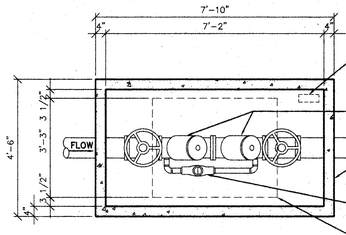

.PLAN

NAMEPLATE INDICATING: MANUFACTURE COMPANY, COMPANY PHONE NUMBER, MODEL NUMBER, AND DATE MANUFACTURED

U.S.G. CERTIFIED U.L. DOUBLE DETECTOR BACKFLOW PREVENTER

VAULT WITH 4500 PSI CONCRETE AND NO. 4 BARS AT 8" O.C.E.W. GRADE 60 ACCEPTABLE MANUFACTURE: BROOKS PRODUCTS, INC.

3/4" DETECTOR METER WITH 2 SHUT-OFF VALVES AND BACKFLOW PREVENTER

LINE OF ALUMINUM HATCHWAY

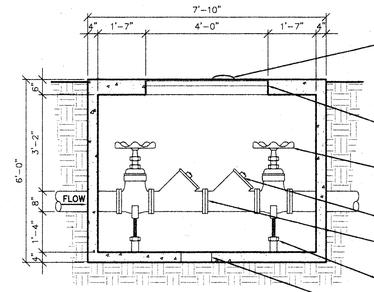

SECTION

REMOTE REGISTER SENSOR TO METER

39"x48" ALUMINUM HATCH, SPRING ASSISTED

RISING STEM VALVE, TYPICAL

ALL TEST COCKS SEALED WITH THREADED PLUG TYPICAL

U.S.G. CERTIFIED U.L. DOUBLE DETECTOR BACKFLOW PREVENTER

GALVANIZED SUPPORT TYPICAL

12"x12" SUMP WITH GALVANIZED IRON GRATE

CHECK VALVE VAULT | SCALE: 1/2"=1'-0" | P102

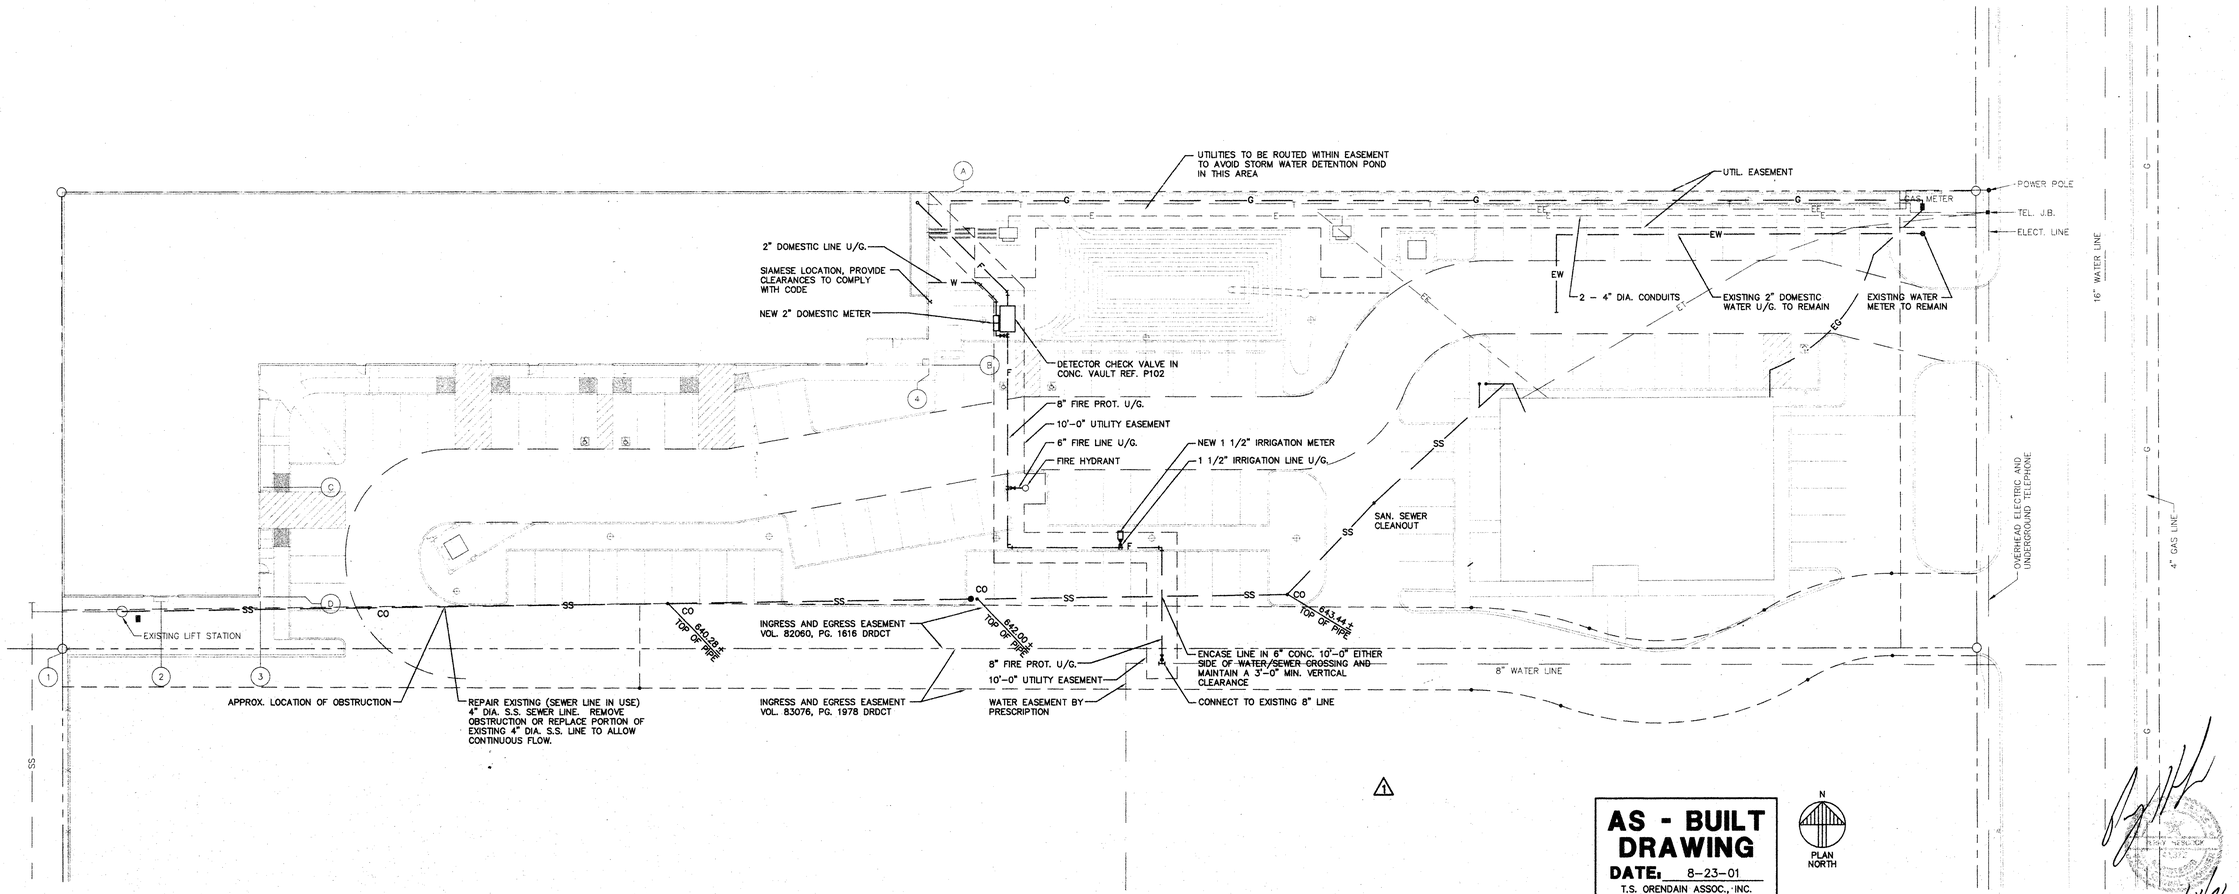

AS - BUILT DRAWING

DATE: 8-23-01

T.S. ORENDAIN ASSOC., INC.
Architecture * Planning * Interior Design
16835 Addison Road, Suite 101
Addison, Texas 75001 972-250-0119

9/14/01

SITE PLUMBING PLAN | SCALE: 1"=20'-0" | P101

AMO
16835 ADDISON ROAD
SUITE 101
ADDISON, TX. 75001
TEL: 972-250-0119
FAX: 972-250-3157

ADDISON PARK CENTRE OFFICE/TECH./FLEX. PHASE 1

16835 ADDISON ROAD ADDISON, TEXAS

T.S. Orendain Associates Inc.
Architecture * Planning * Interior Design
16835 Addison Road
Suite 101
Addison, Texas 75001
(972) 250-0119

JOB: 8396	DATE: 2/25/2000
DRAWN:	CHECKED:

Date	Issued For / Description	By
9-30-98	PERMIT ISSUE	
11-1-99	T.D.L.R.	
2-25-00	100% ISSUED FOR CONSTRUCTION	
XX-XX-2000	GENERAL REVISION	

SITE PLUMBING PLAN

P-1