
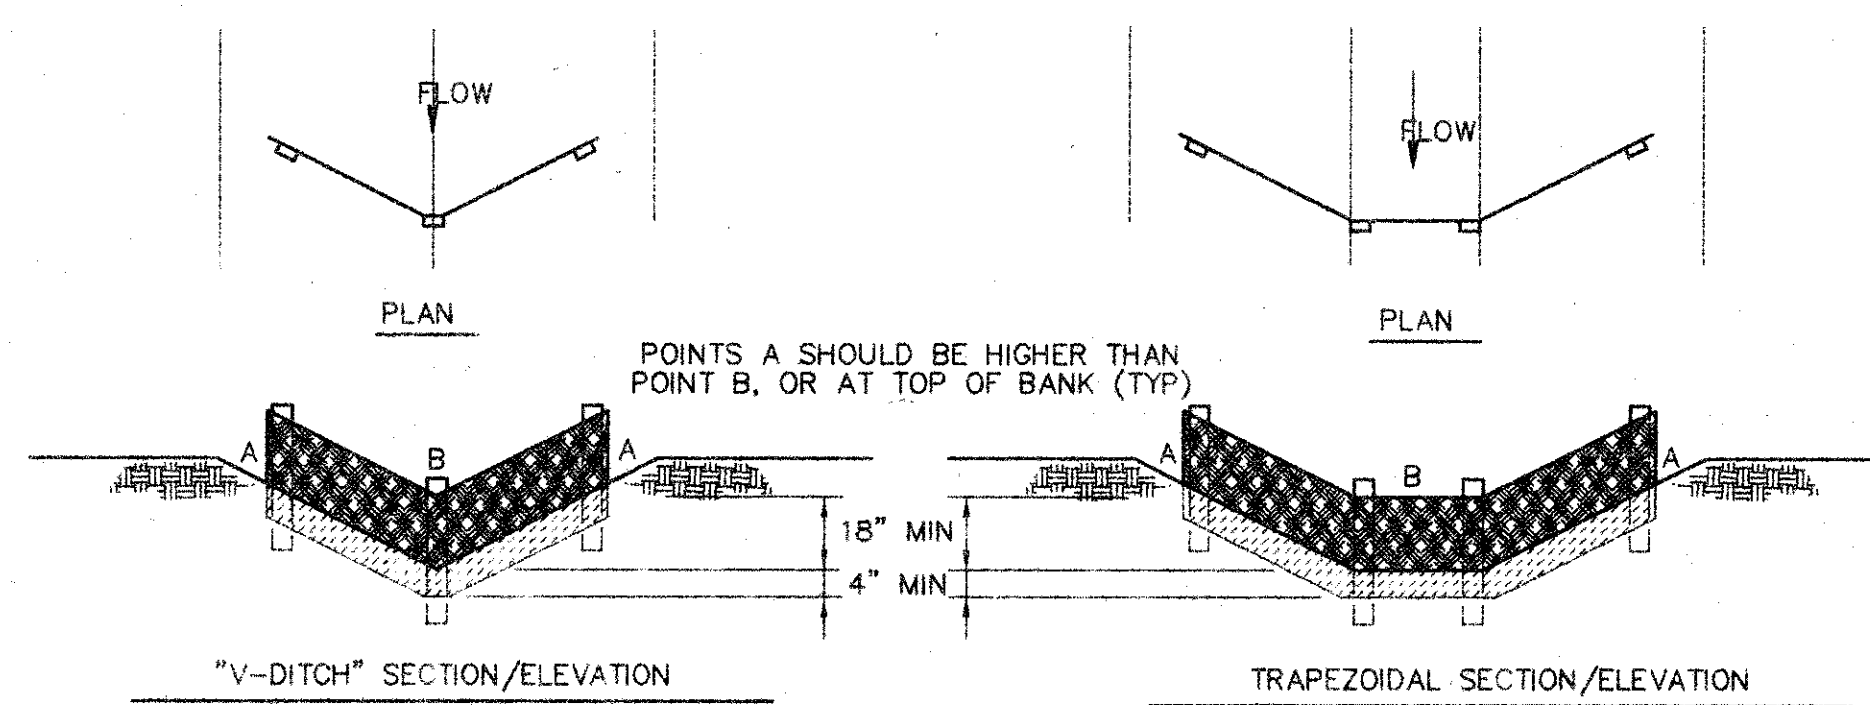


1. CONSTRUCTION ENTRANCE EXACT LOCATION TO BE DETERMINED BY THE CONTRACTOR.

01 STABILIZED CONSTRUCTION ENTRANCE
N.T.S.

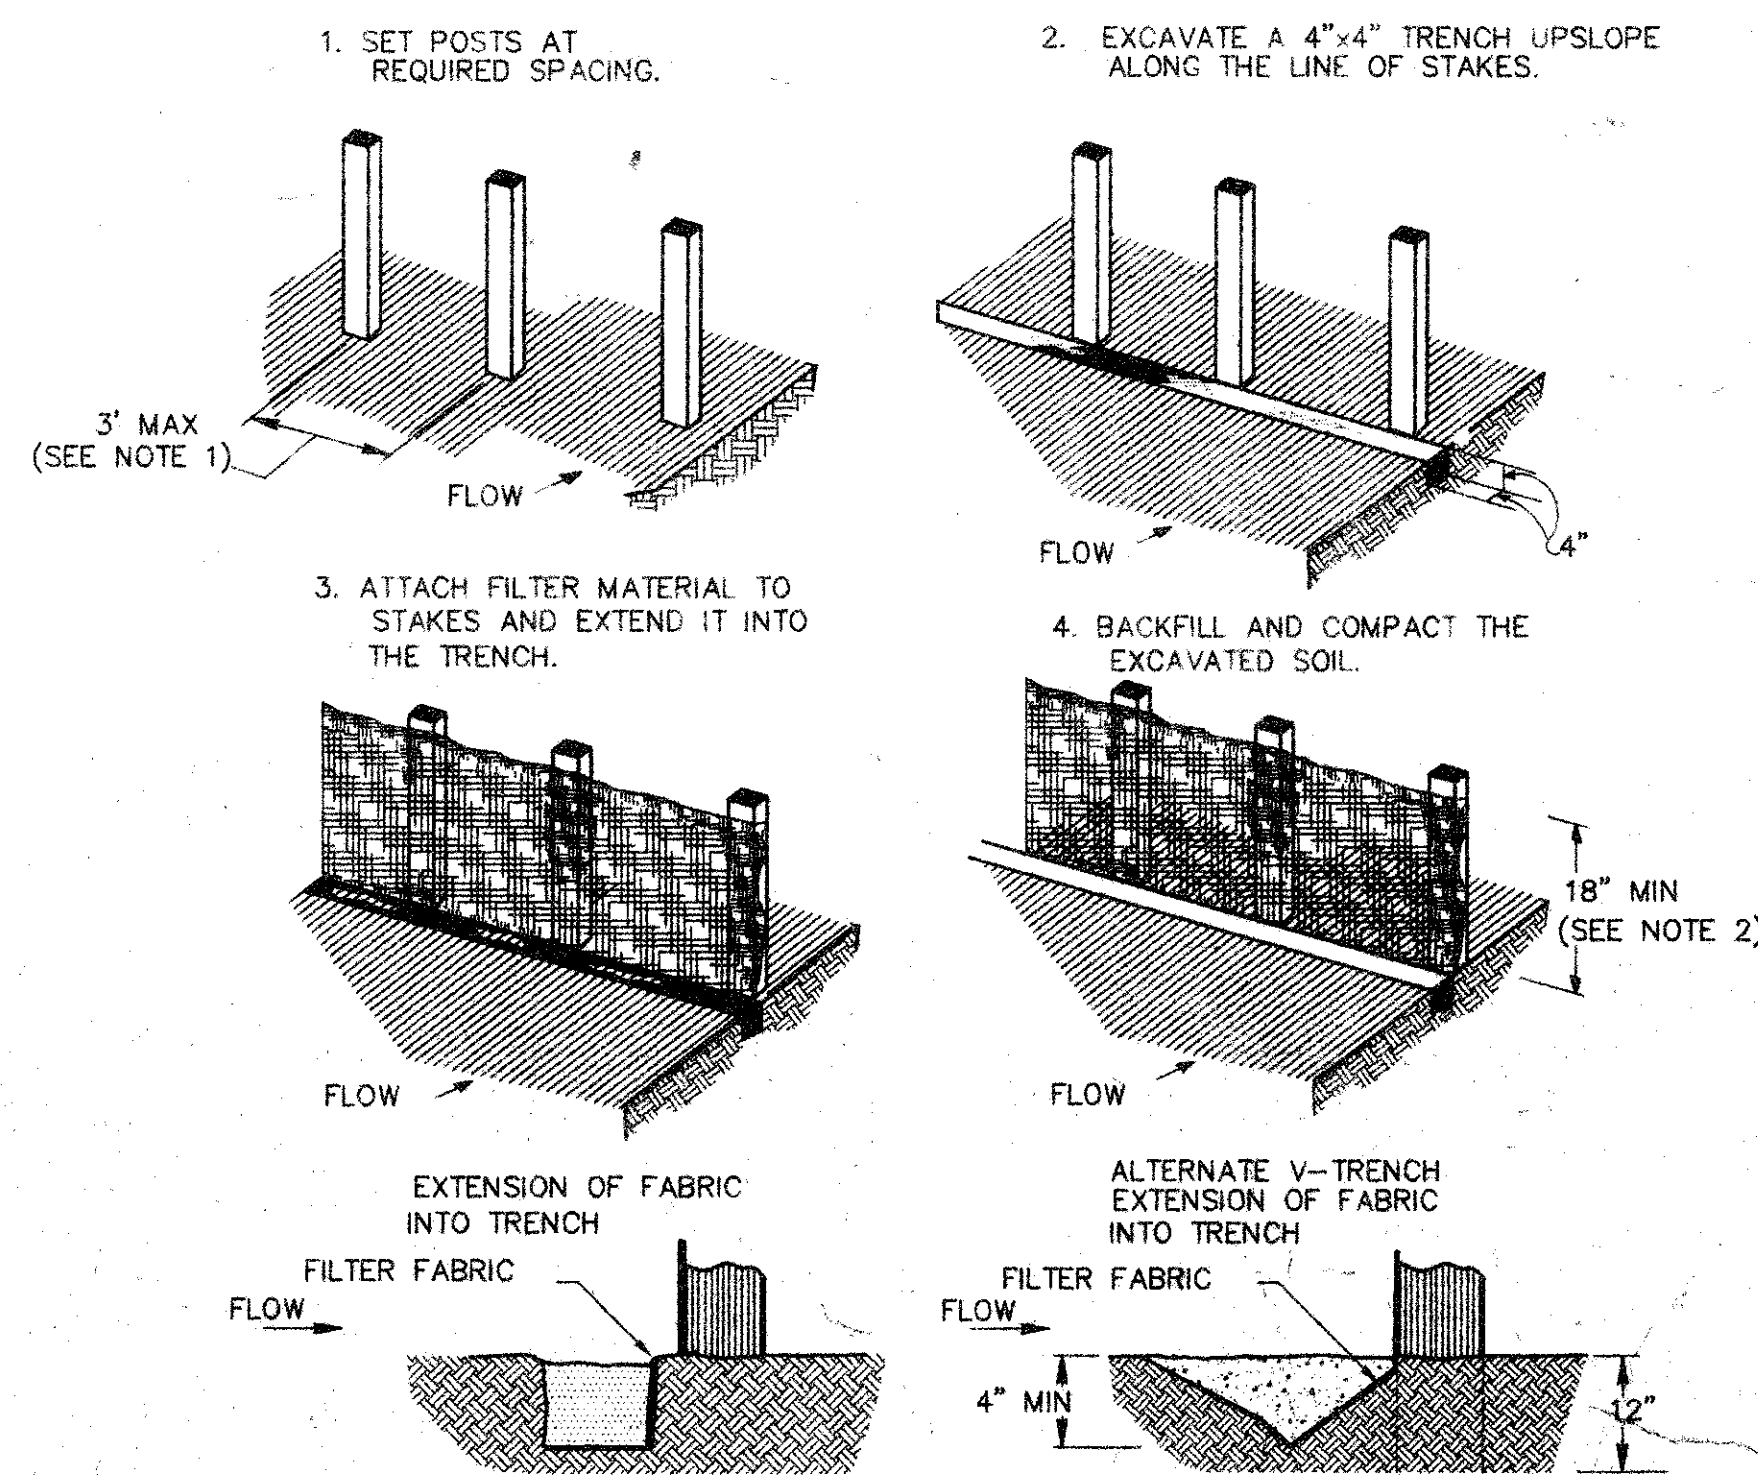


CONSTRUCTION NOTES:

1. 1 INCH THICK BY 2 INCH WOODEN STAKES TO BE SET AT MAX SPACING OF 3 FEET AND EMBEDDED A MIN OF 8 INCHES. IF PREASSEMBLED FENCE WITH SUPPORT NETTING IS USED, SPACING OF POST MAY BE INCREASED TO 8 FEET MAX.
2. ATTACH FILTER FABRIC TO WOODEN STAKES. FILTER FABRIC FENCE SHALL HAVE A MIN HEIGHT OF 18 INCHES AND MAX HEIGHT OF 36 INCHES ABOVE NATURAL GROUND.
3. WHEN TWO SECTIONS OF FILTER CLOTH ADJOIN EACH OTHER THEY SHALL BE OVERLAPPED 6 INCHES AT THE POSTS, AND FOLDED.

02 SEDIMENT CONTROL FENCE
N.T.S.


AS - BUILT DRAWING
DATE: 8-23-01
T.S. ORENDAIN ASSOC., INC.
Architects • Planning • Interior Design
16835 Addison Road, Suite 101
Addison, Texas 75002 972-250-0119

EROSION CONTROL LEGEND

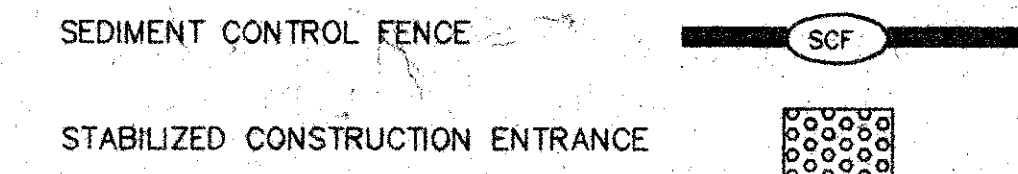

AMO
16835 ADDISON ROAD
SUITE 101
ADDISON, TEXAS 75248
TEL: 972-250-0119
FAX: 972-250-3157

OFFICE WAREHOUSE PHASE I
16835 ADDISON ROAD ADDISON, TEXAS

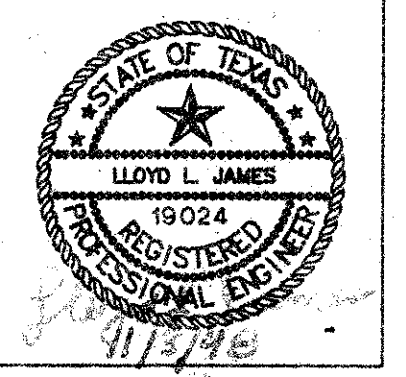

to
T.S. Orendain Associates Inc.
Architects • Planning • Interior Design

16835 Addison Road
Suite 101
Addison, Texas 75248
(972) 250-0119

JOB: 8396 DATE: 10-26-98
DRAWN: CHECKED:

Date	By	Issued For / Description
11-11-99	TDLR	100% ISSUED FOR CONSTRUCTION
2-22-00		

EROSION CONTROL PLAN