




UTILITY DETAIL SCALE: 1/4"=1'-0" 1.306

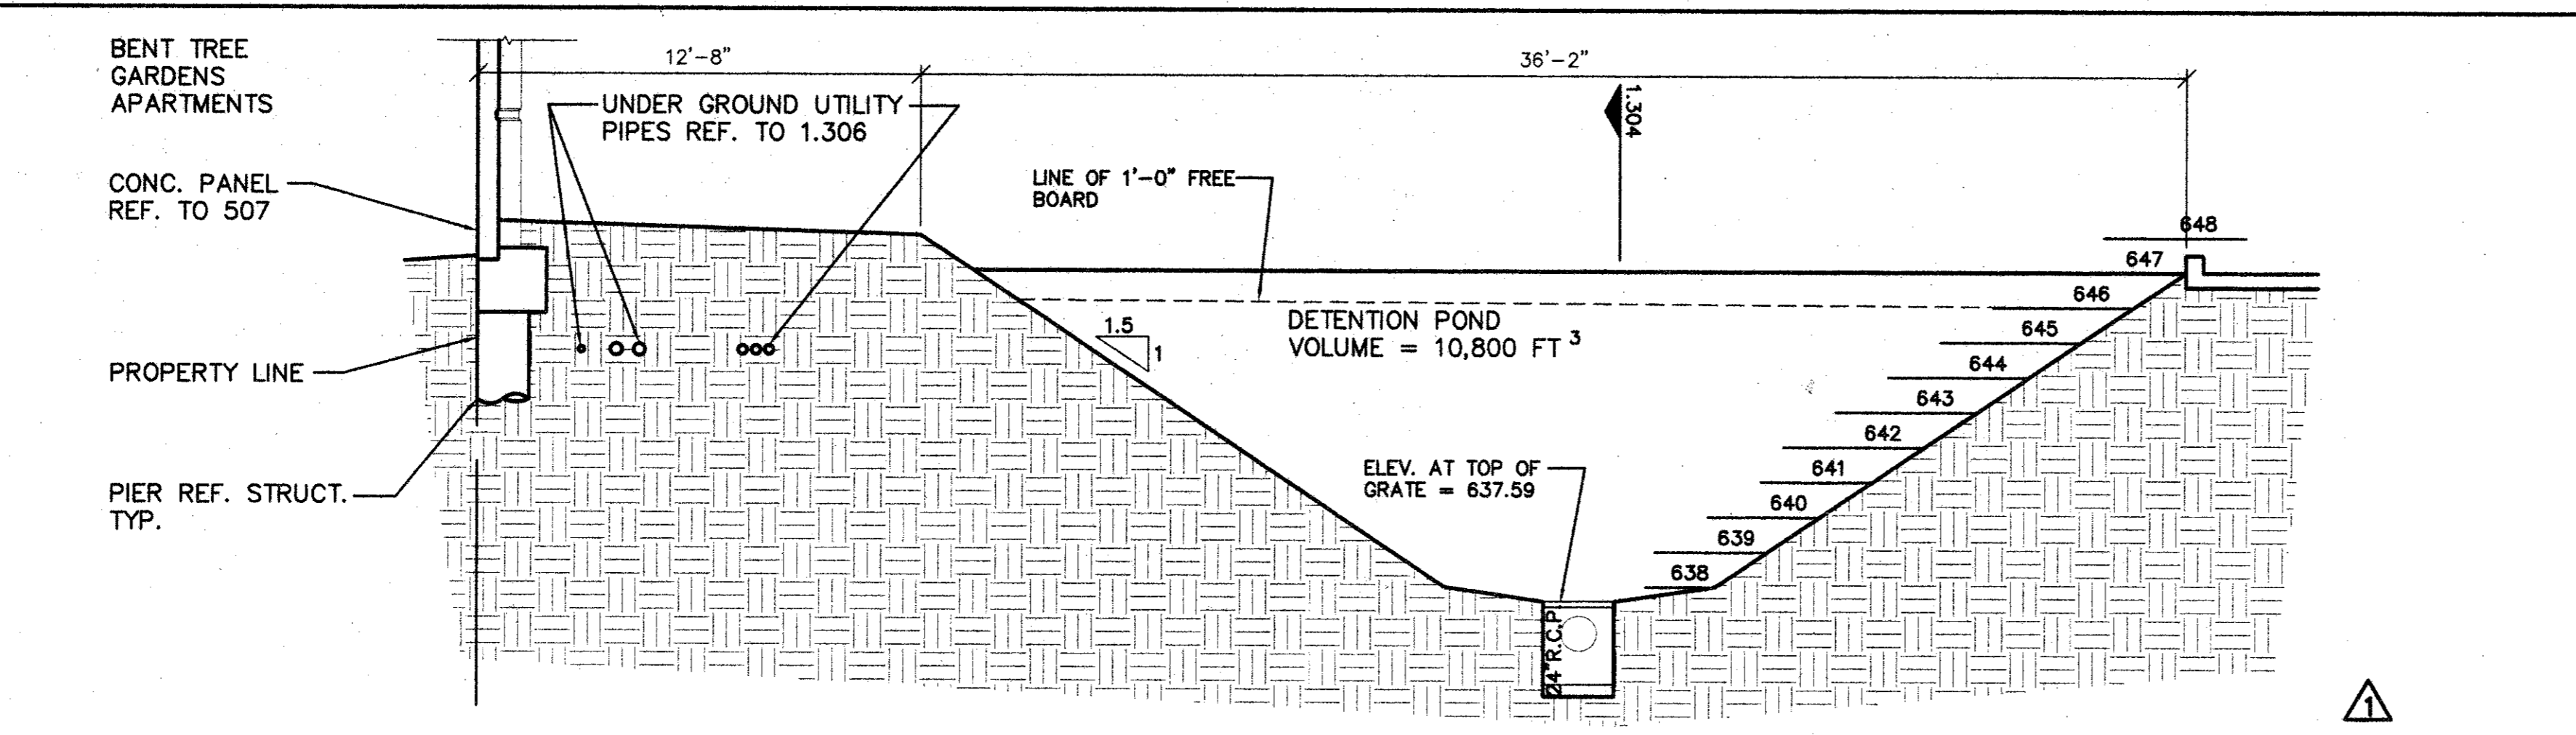


SECTION SCALE: 1/4"=1'-0" 1.305

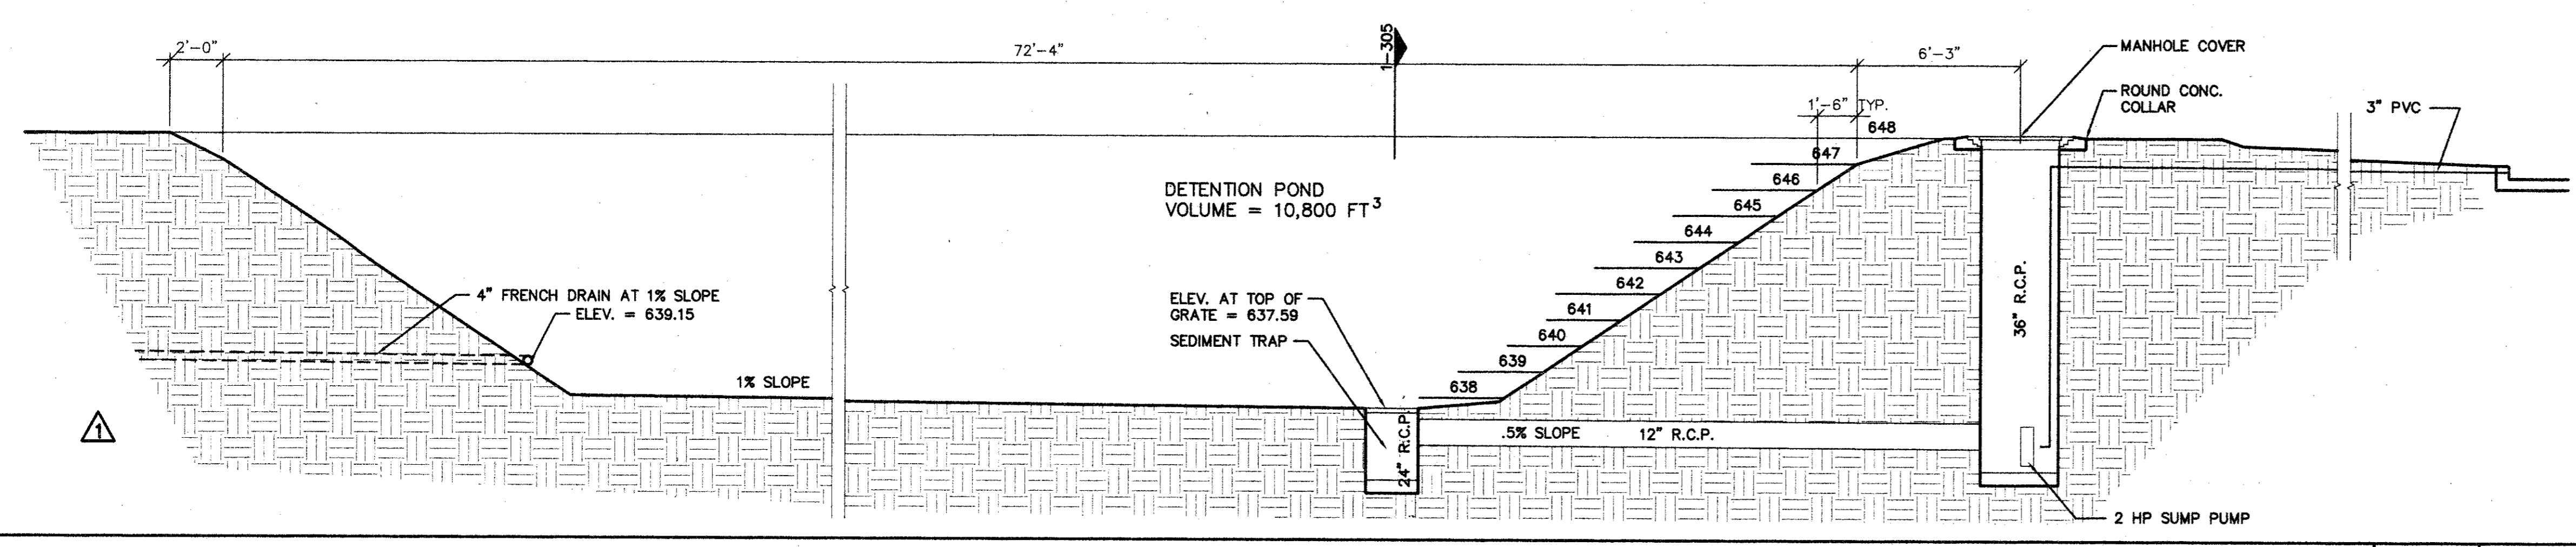


SECTION SCALE: 1/4"=1'-0" 1.304

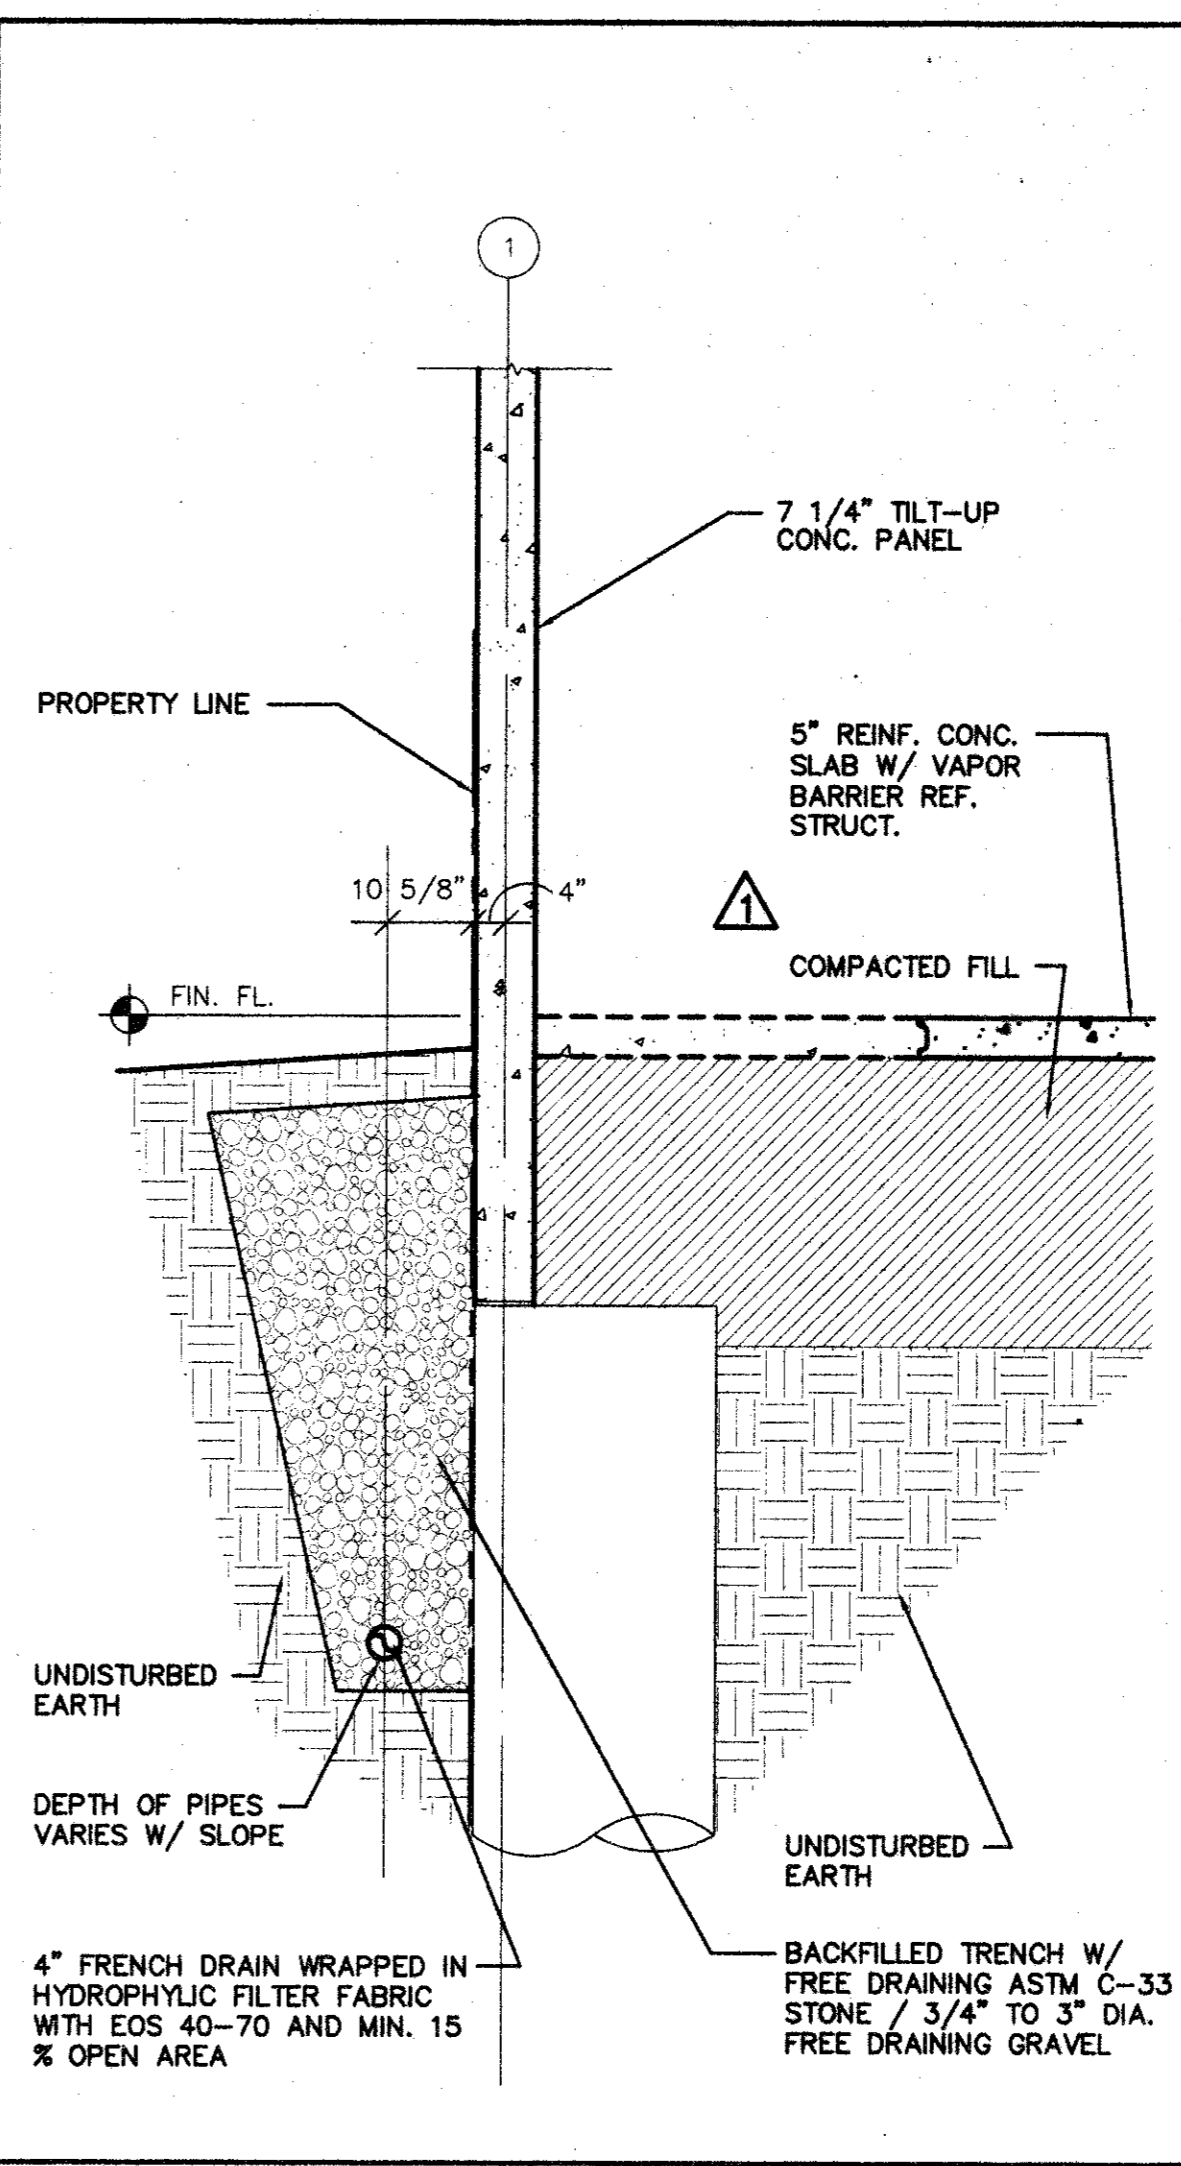

SECTION SCALE: 1/2"=1'-0" 1.303

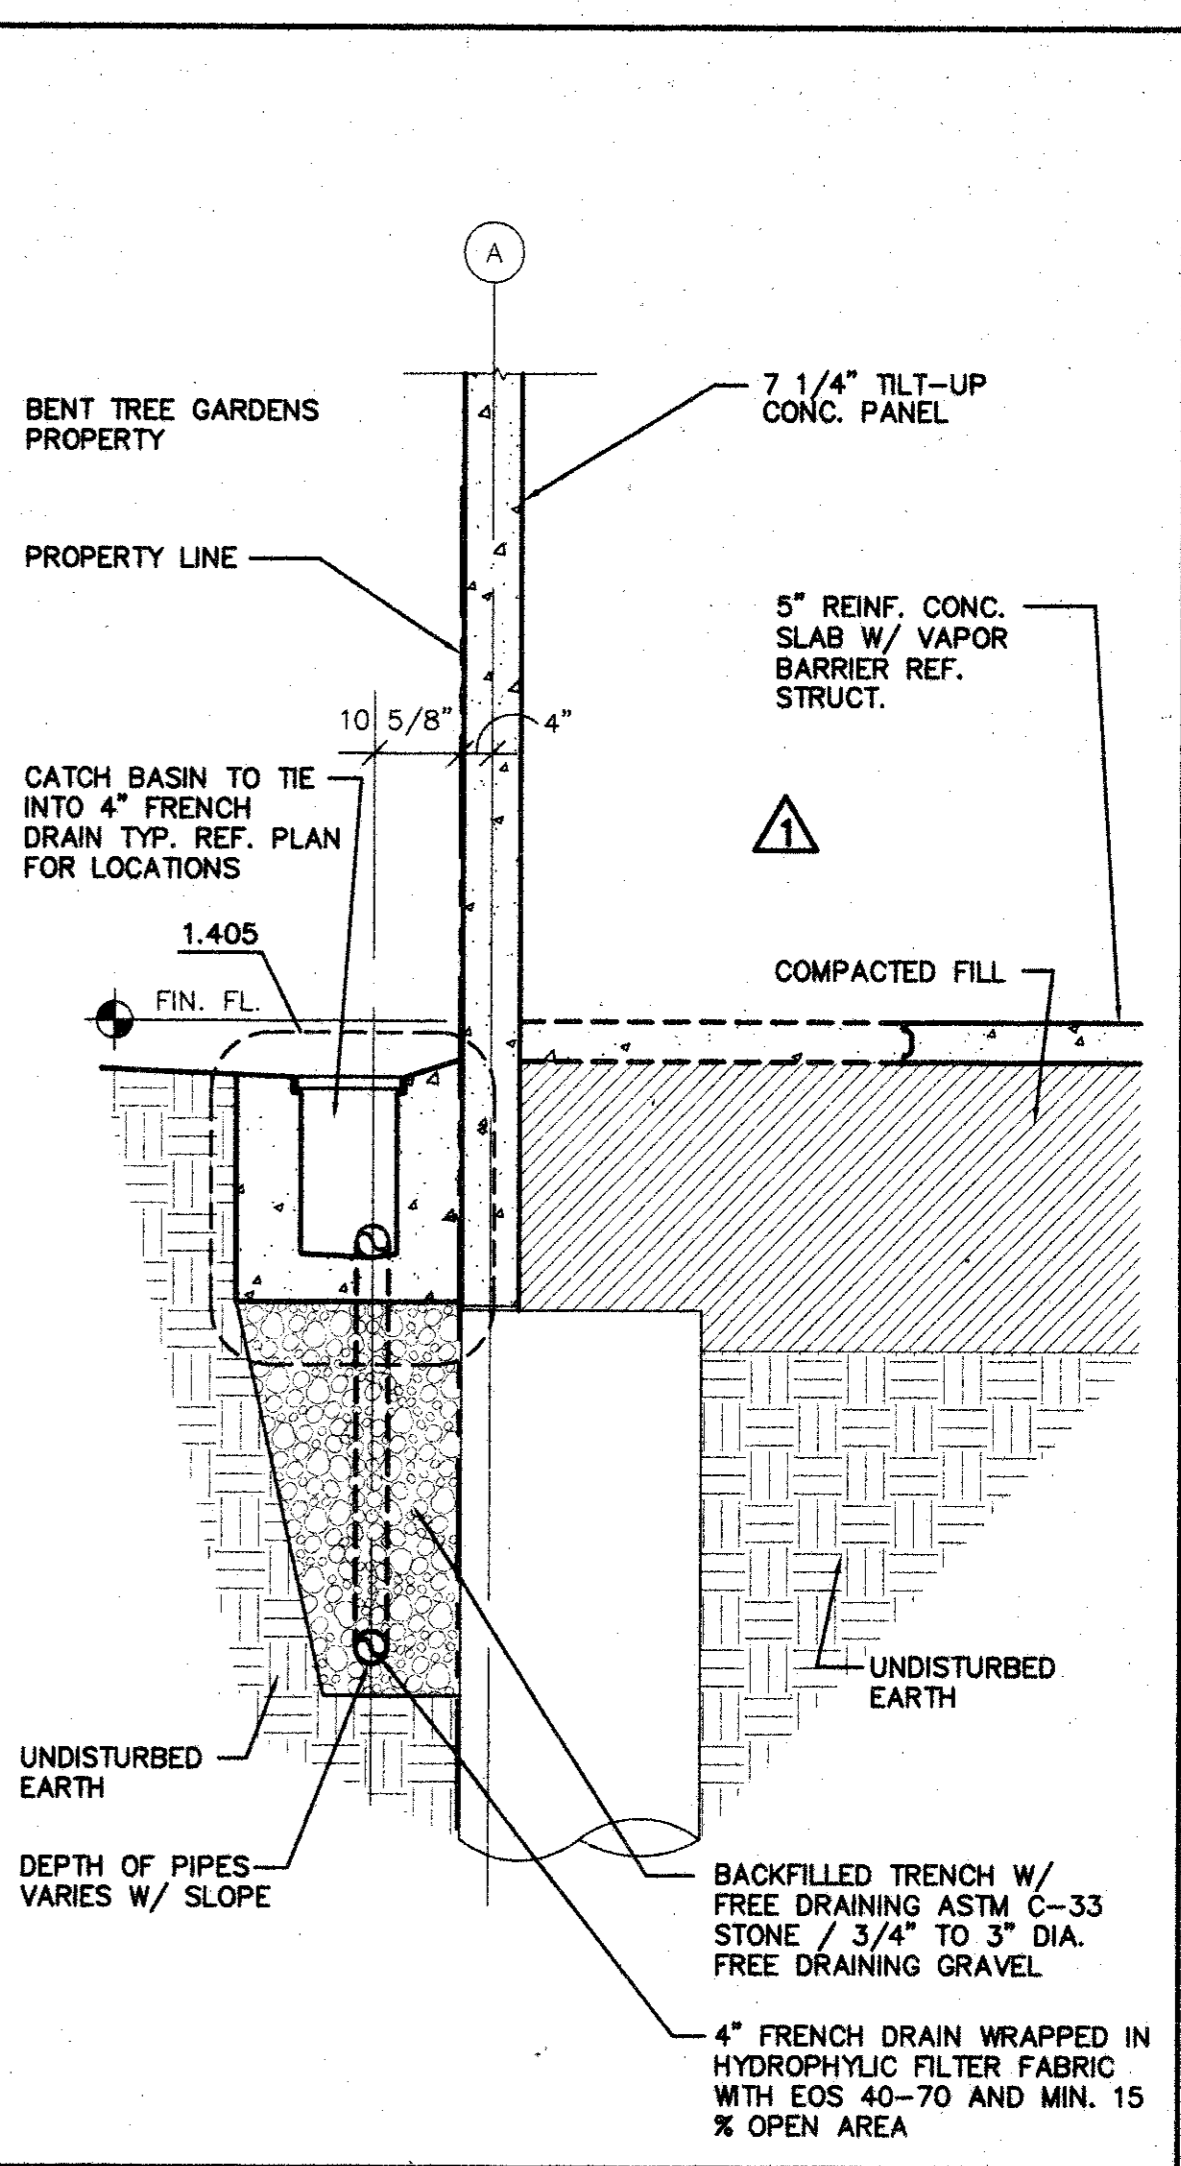

SECTION SCALE: 1/2"=1'-0" 1.302

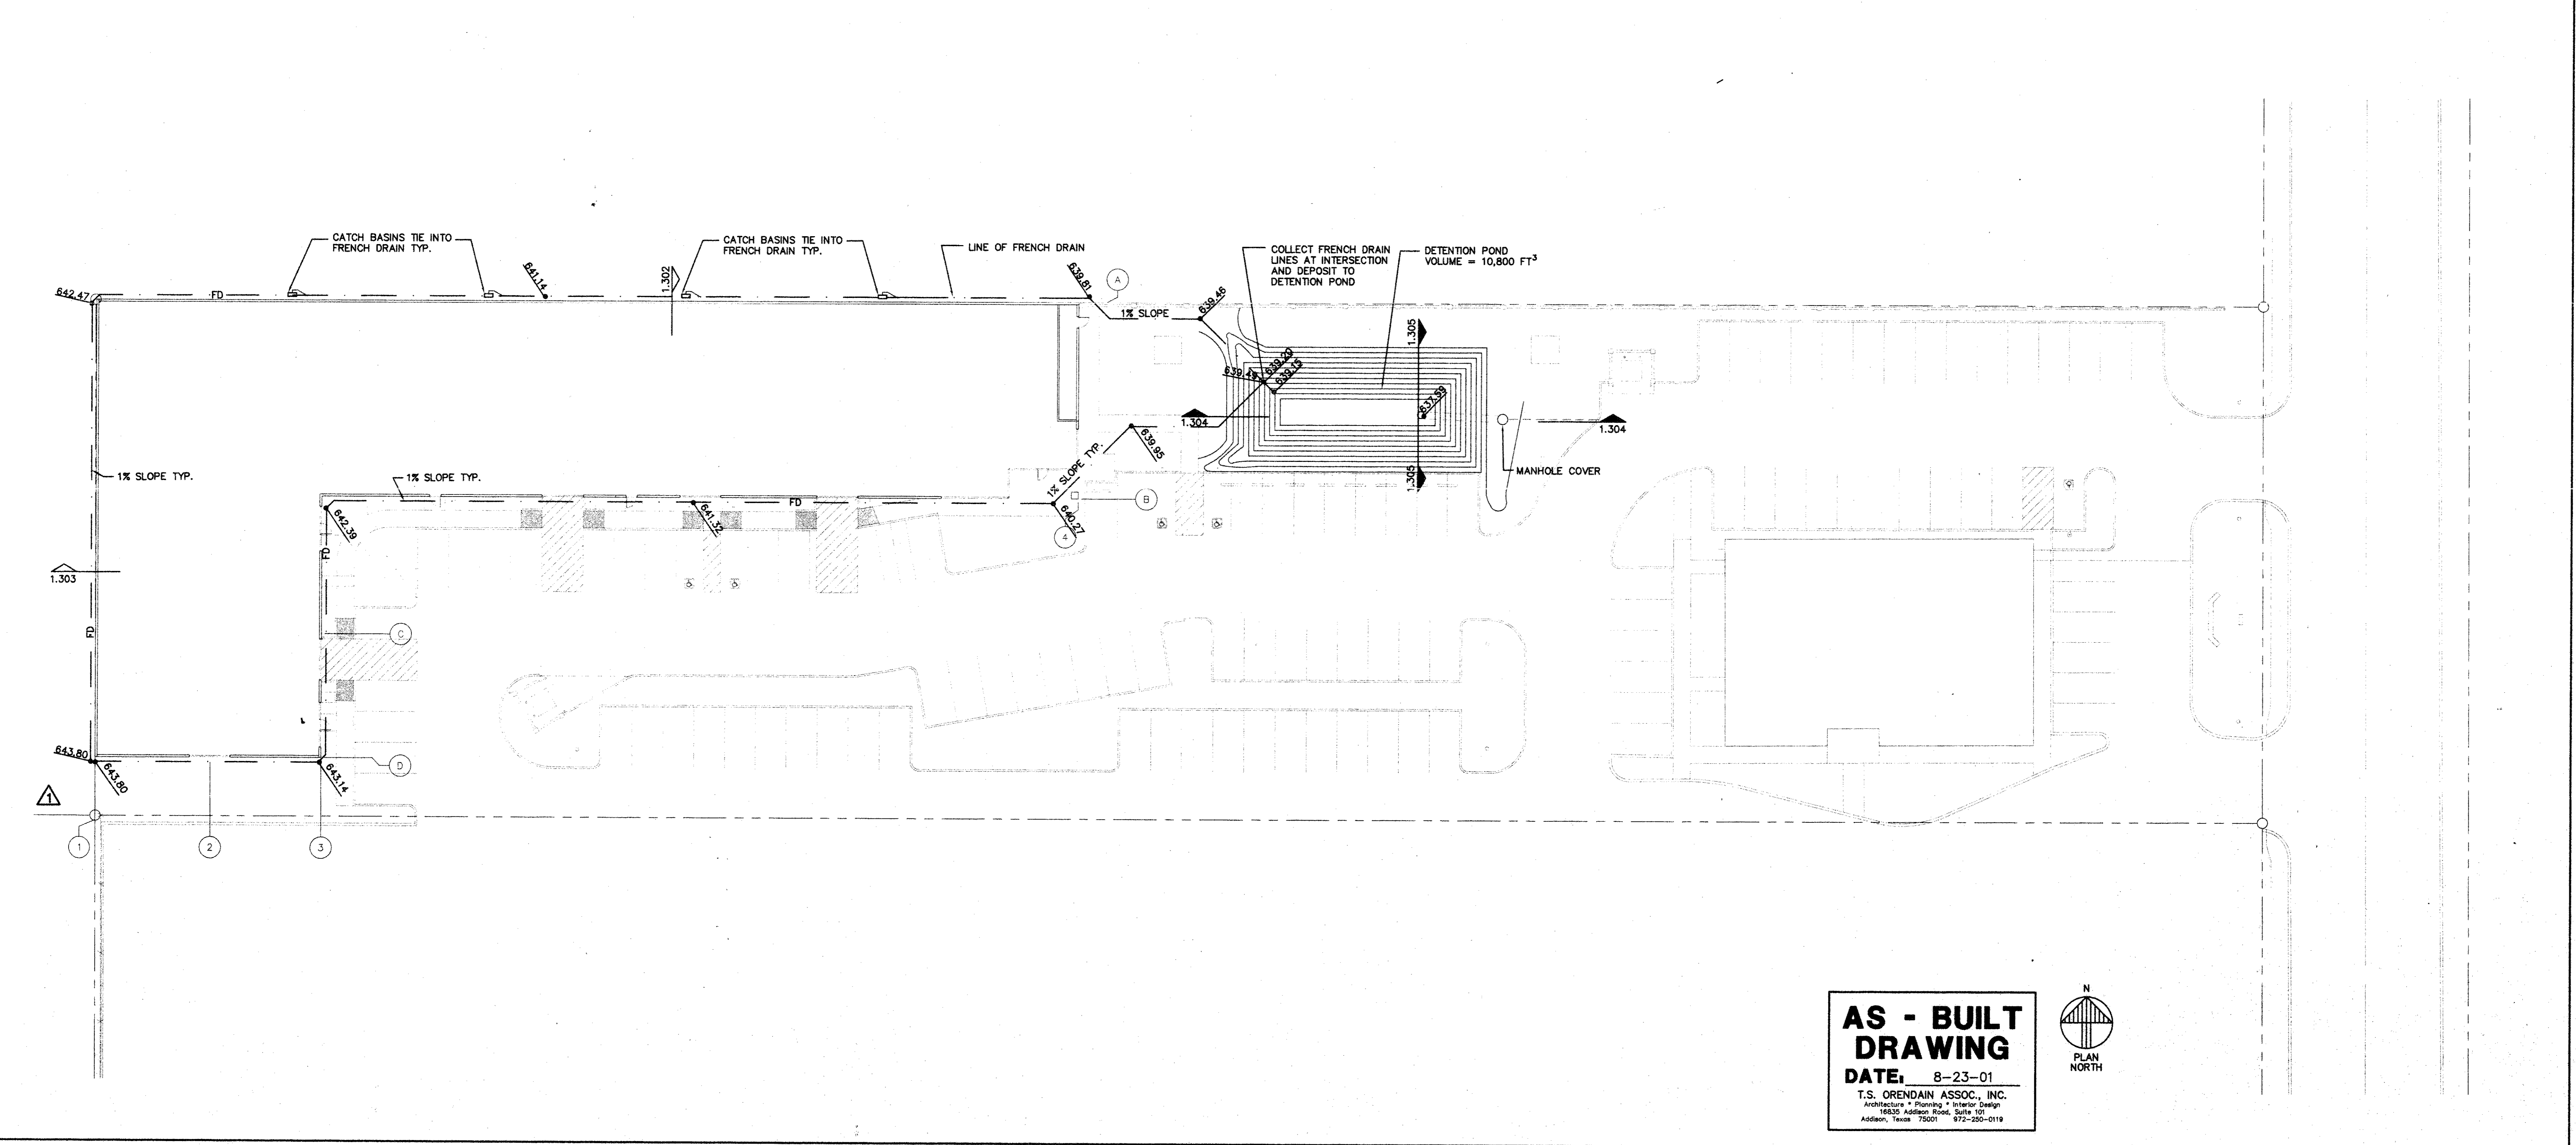


FRENCH DRAIN PLAN SCALE: 1"=20'-0" 1.301

AS - BUILT DRAWING
 DATE: 8-23-01
 T.S. ORENDAIN ASSOC., INC.
 Architecture • Planning • Interior Design
 16835 Addison Road, Suite 101
 Addison, Texas 75001 972-250-0119



AMO
 16835 ADDISON ROAD
 SUITE 101
 ADDISON, TX 75001
 PHONE: 972-250-3157
 FAX: 972-250-3157

ADDISON PARK CENTRE OFFICE/TECH./FLEX. PHASE 1
 16835 ADDISON ROAD ADDISON, TEXAS

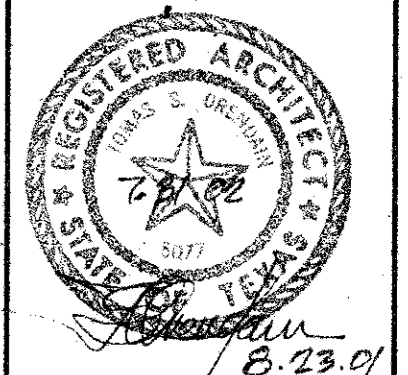

to
 T.S. Orendain Associates Inc.
 Architecture • Planning • Interior Design
 16835 Addison Road
 Suite 101
 Addison, Texas 75001
 (972) 250-0119
 JOB: 8396 DATE: 2-25-2000
 DRAWN: T.S.O. CHECKED: T.S.O.

Date	Issued For / Description
2-25-2000	100% ISSUED FOR CONSTRUCTION
6-9-2000	GENERAL REVISION

FRENCH DRAIN PLAN AND DETAILS