



1 SECTION THRU RETAINING WALL
SCALE: 3/4" = 1'-0"

NOTE:
RET. WALL FINISH: EXPOSED AGGREGATE CONCRETE

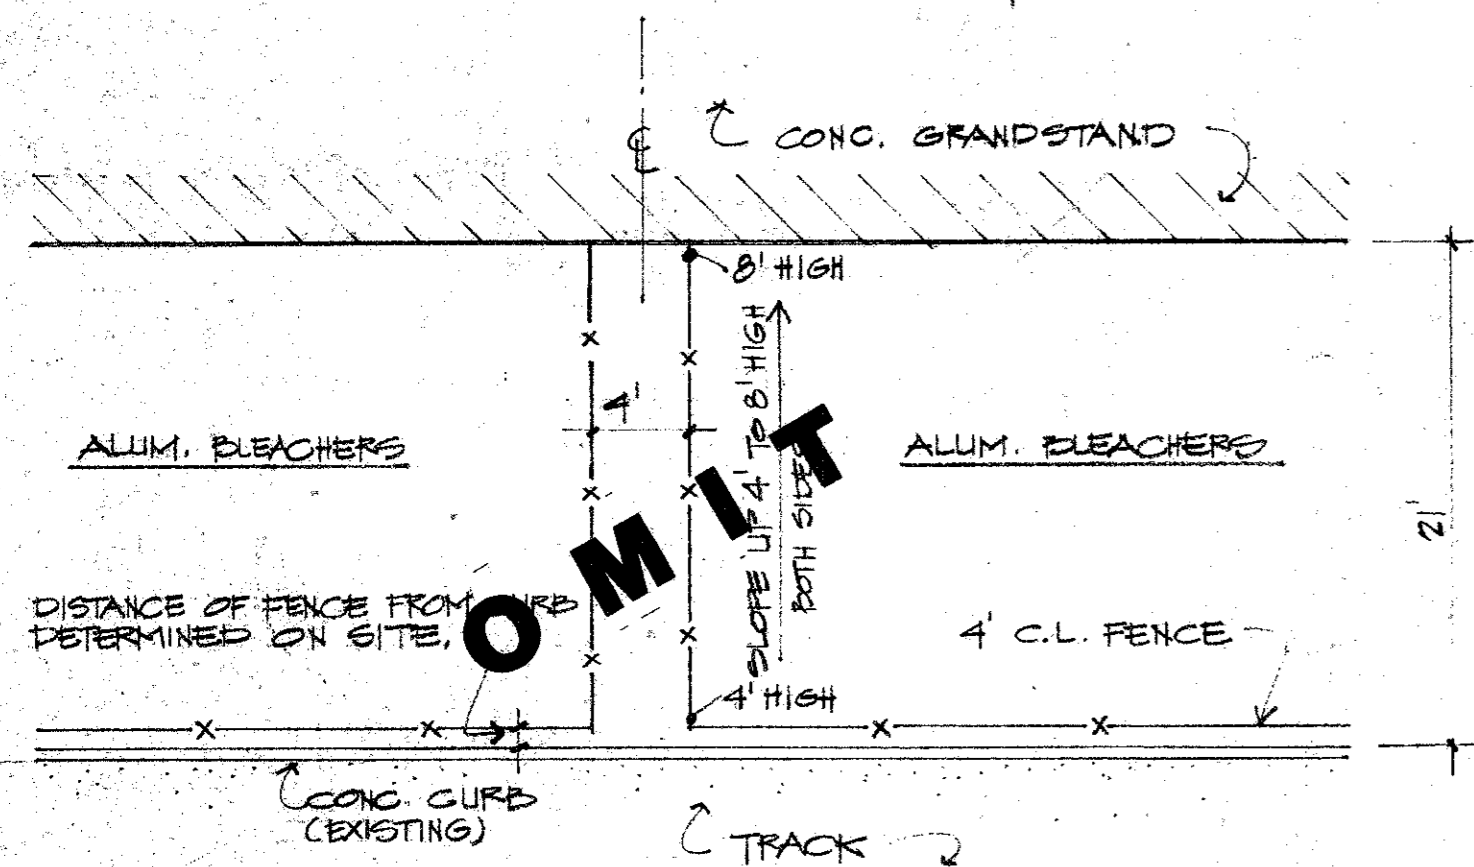


3 CHAIN LINK FENCE AT GRANDSTAND
SCALE: 1/8" = 1'-0"

COORD. EXACT DIMEN. WITH EXIST. BLEACHERS

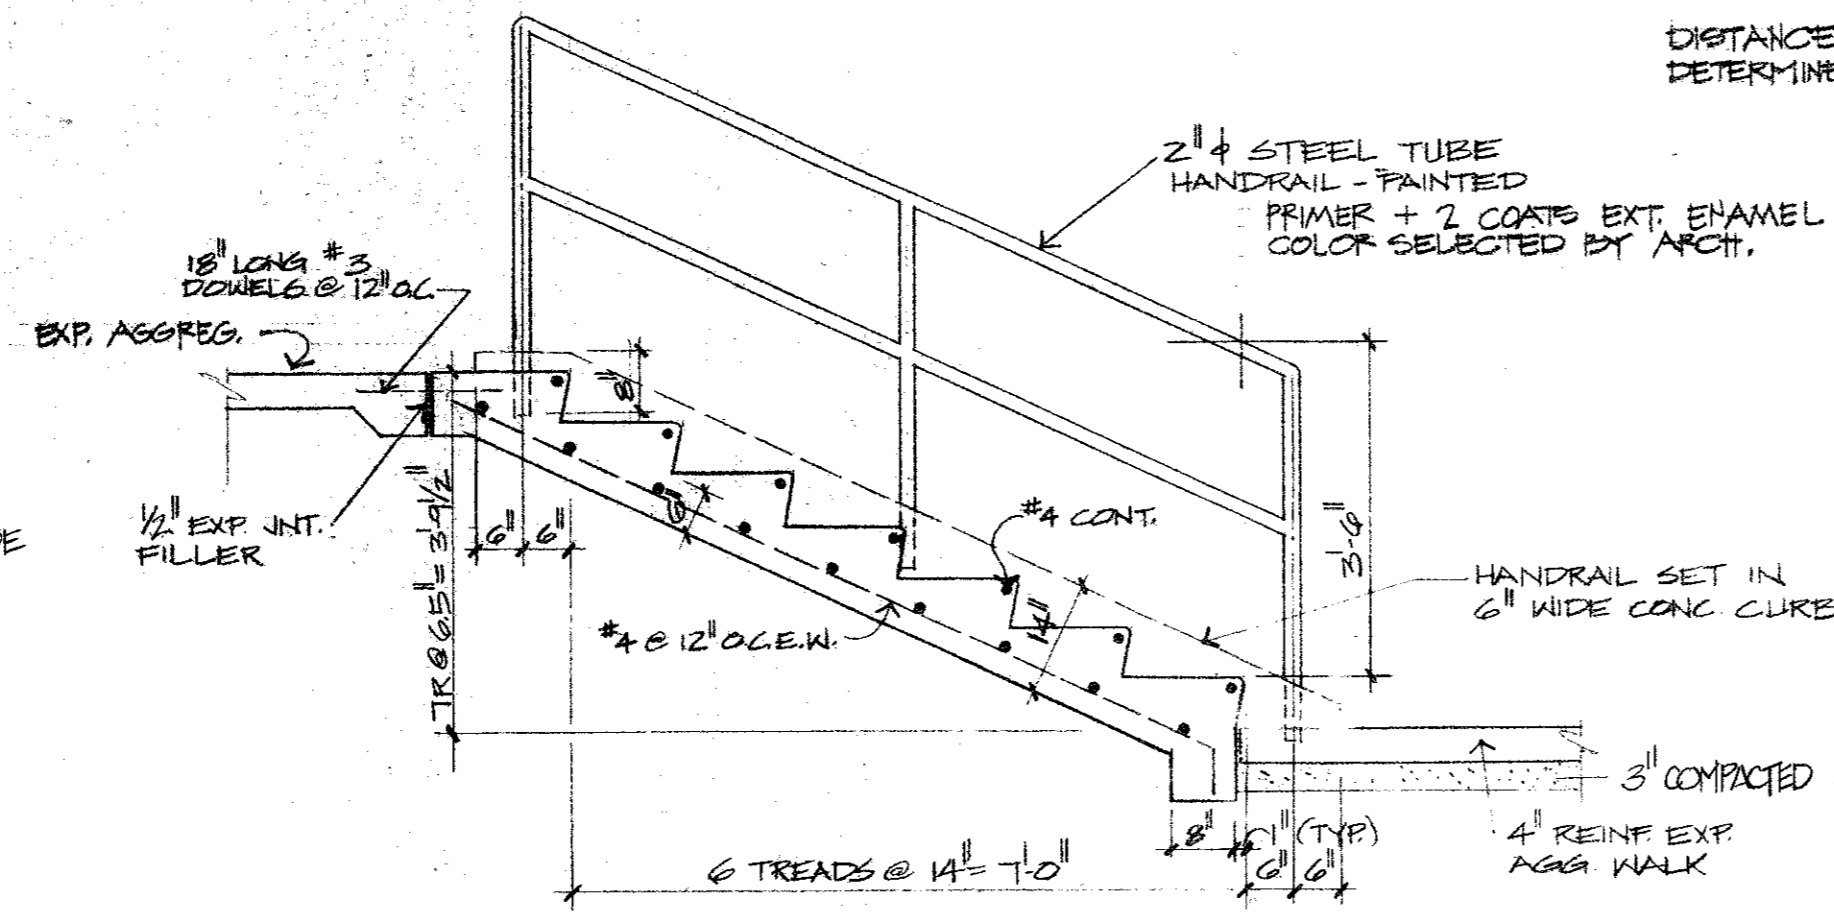


2 EXTERIOR STAIR DETAIL
SCALE: 1/2" = 1'-0"

NOTE:
EXT. STAIR FINISH: EXPOSED AGGREGATE CONCRETE
COORD. EXACT FIBER PER. AS PER ACTUAL SITE CONDITIONS.

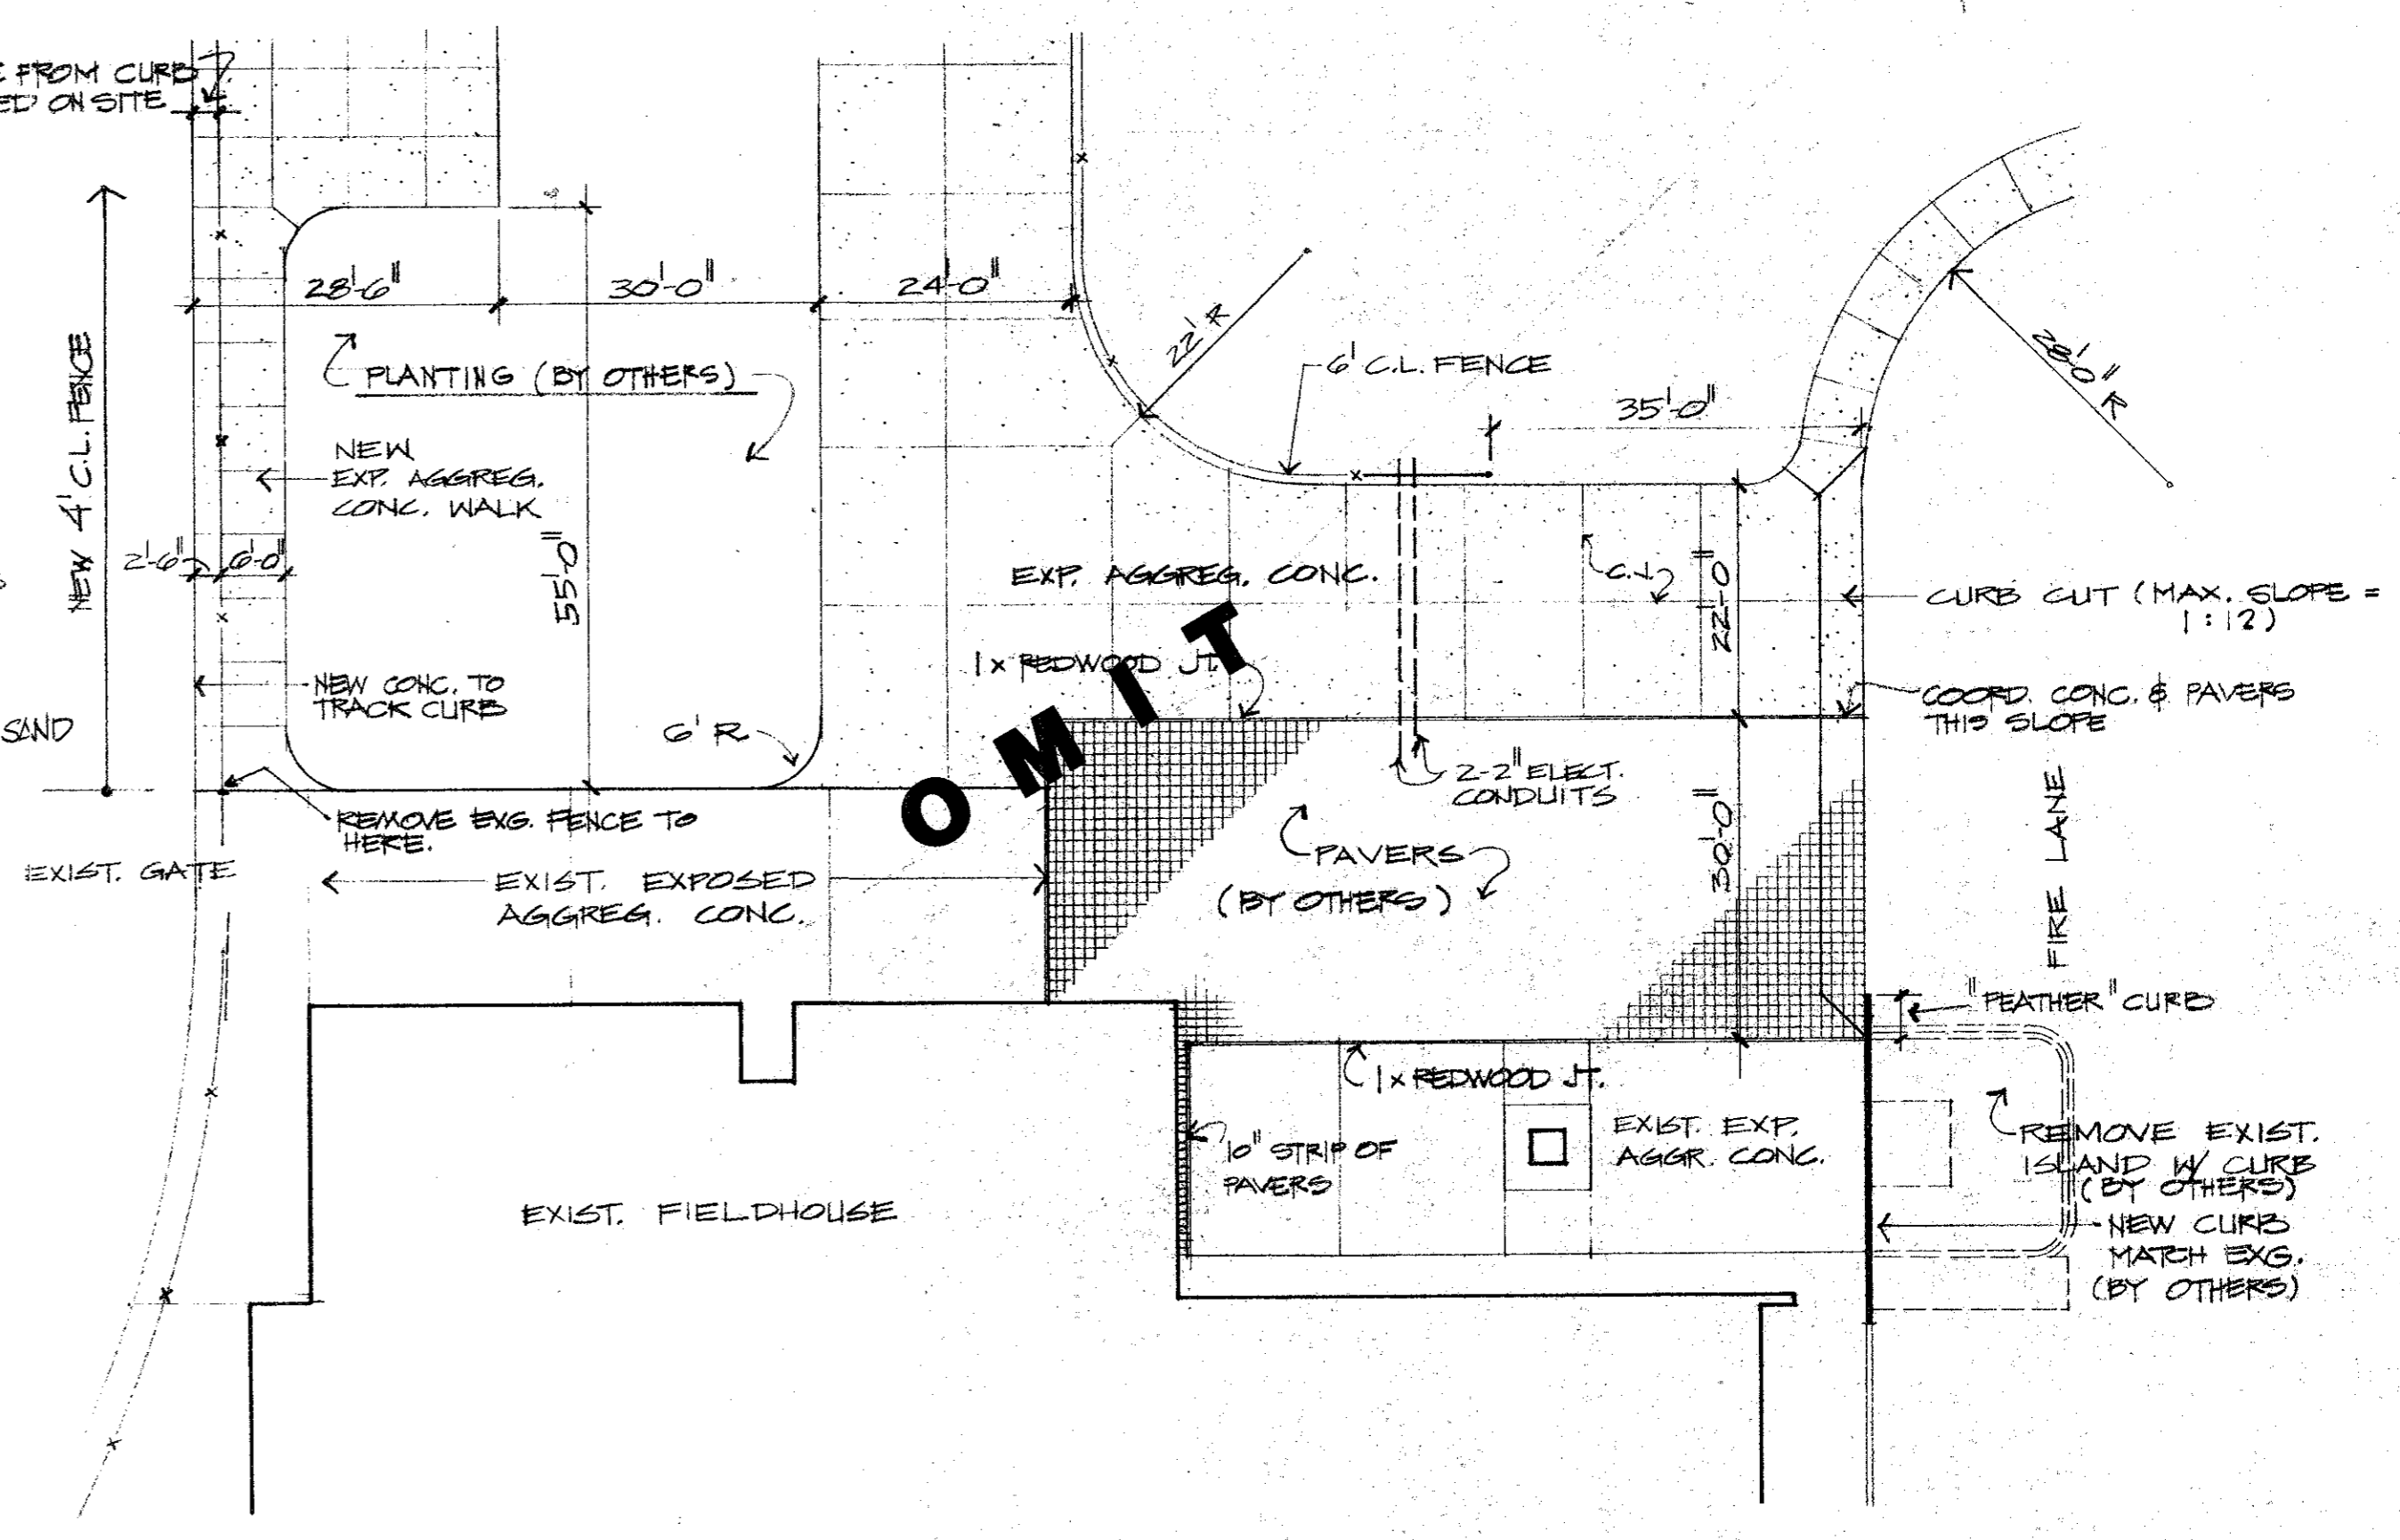


4 STADIUM ENTRANCE PLAZA
SCALE: 1/16" = 1'-0"

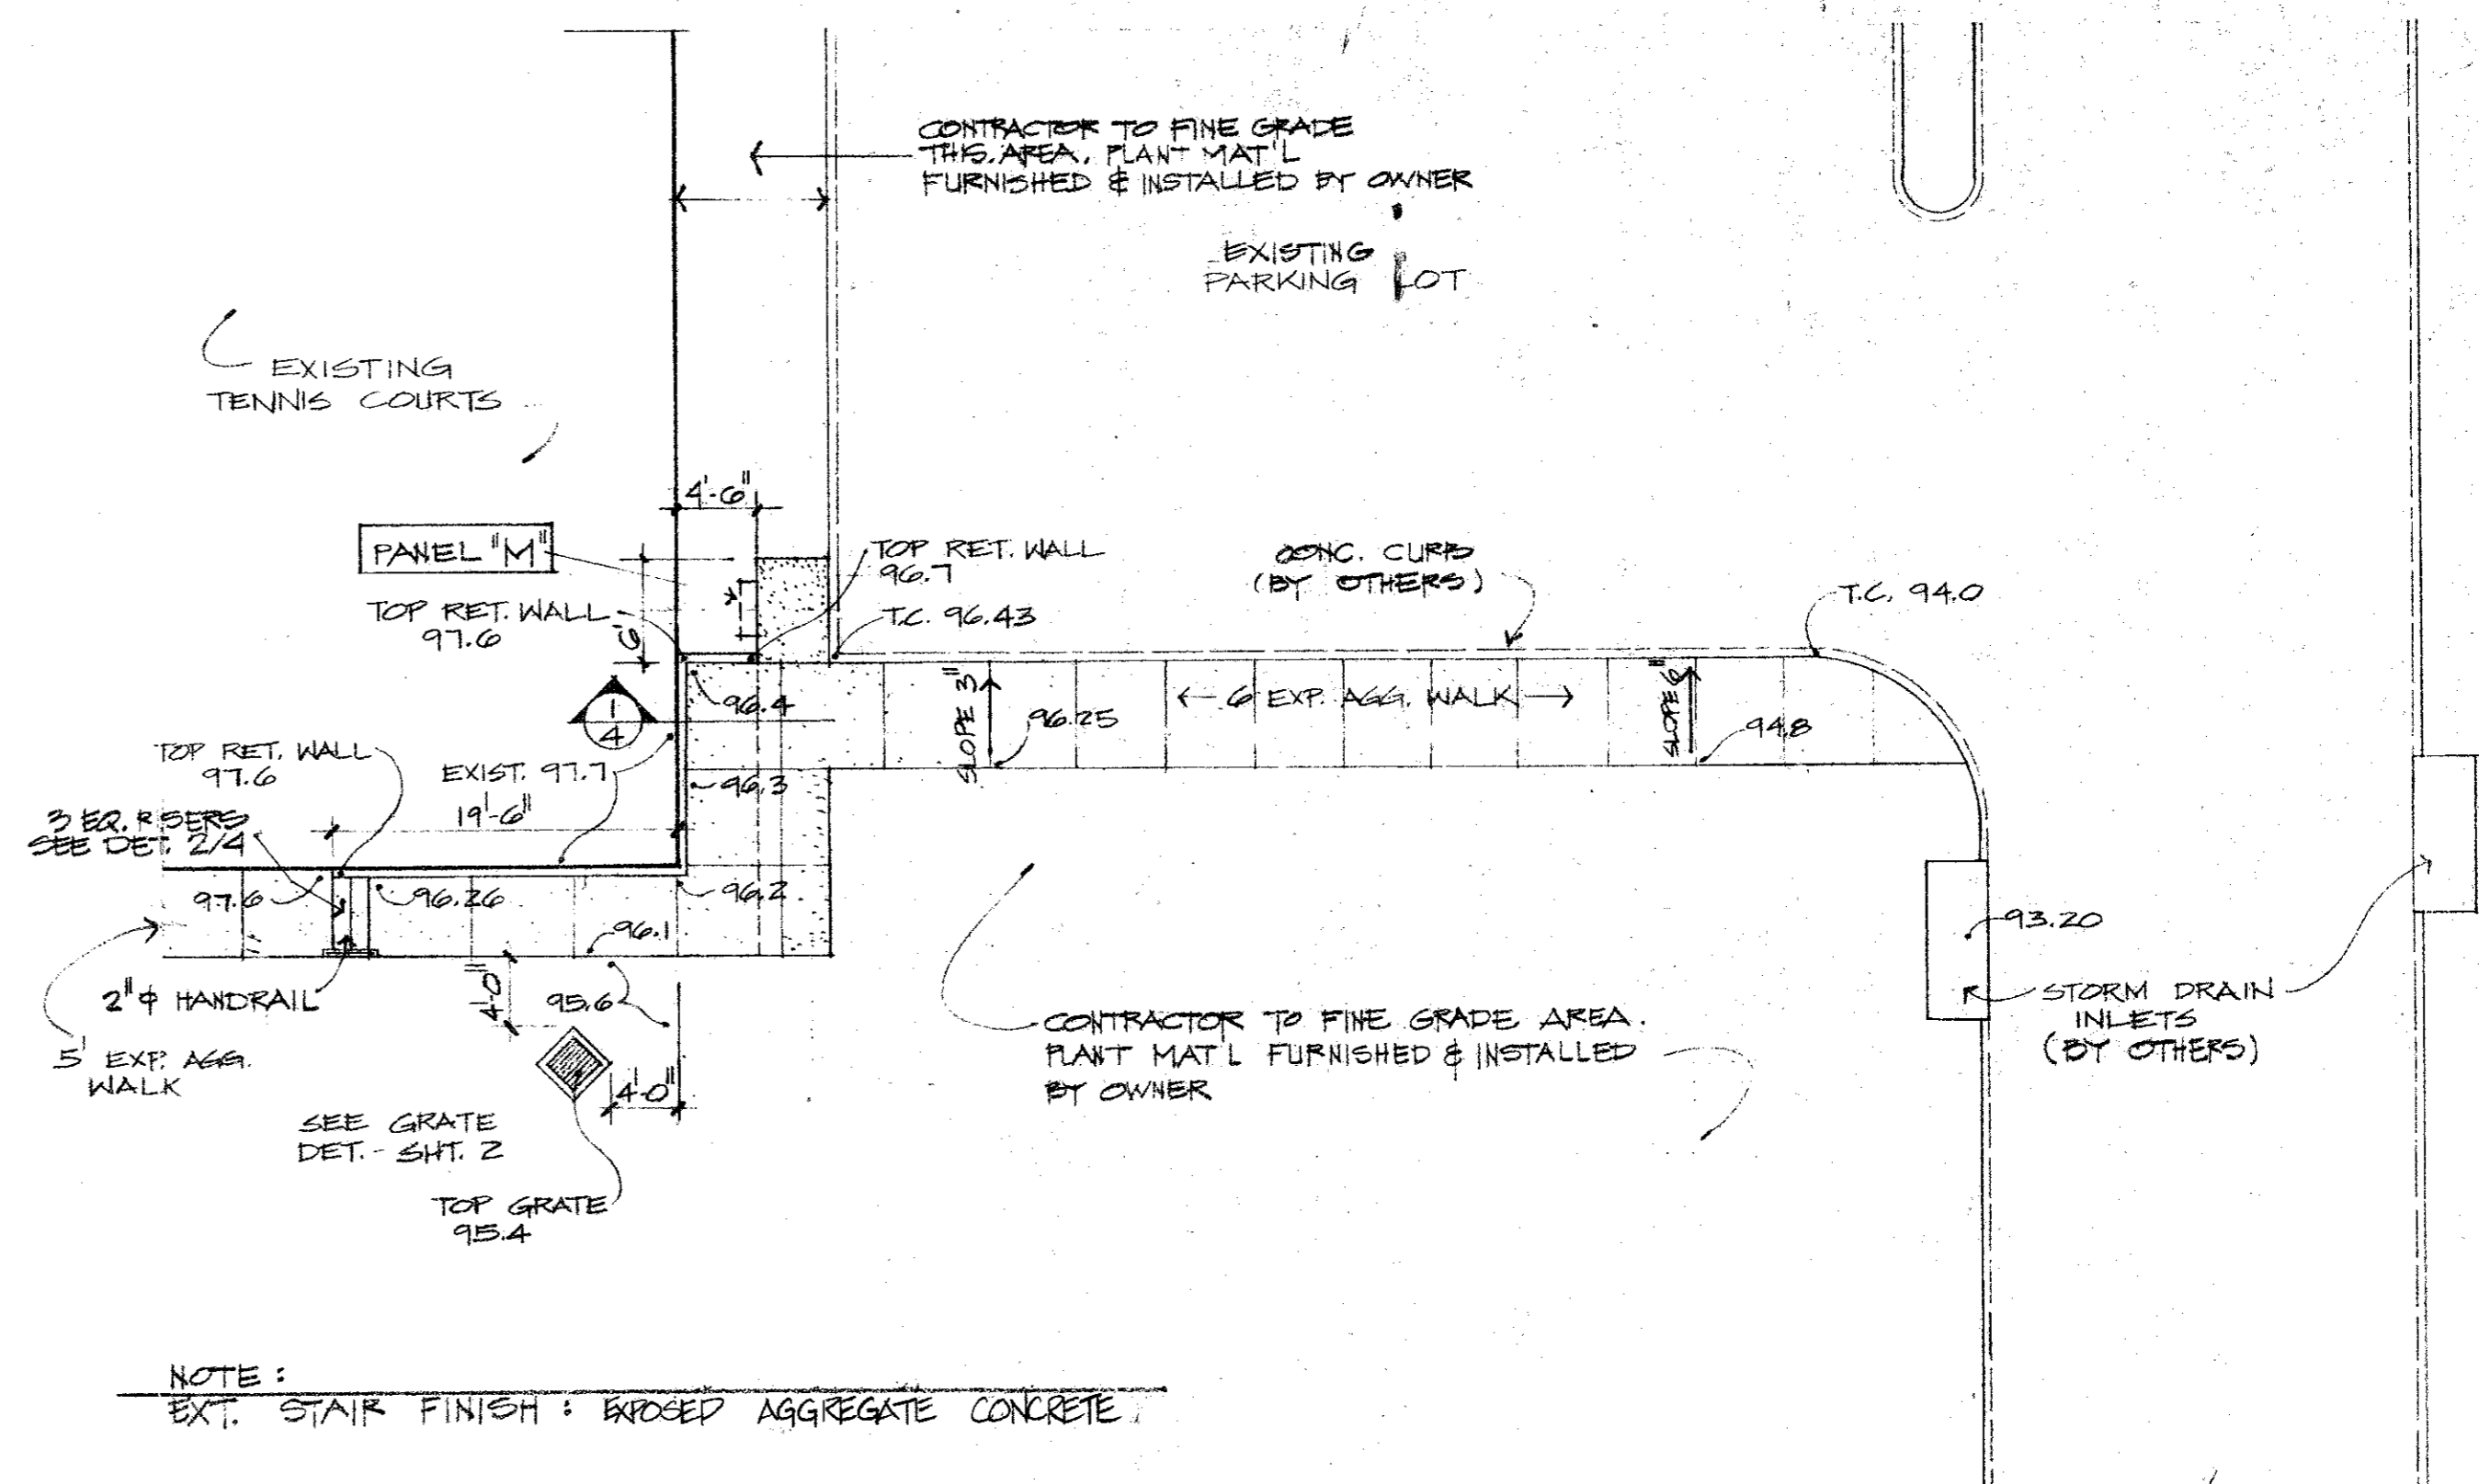

5 ENLARGED SITE PLAN
SCALE: 1" = 10'-0"

NOTE:
EXT. STAIR FINISH: EXPOSED AGGREGATE CONCRETE

DATE: 11-20-80
REVISION:

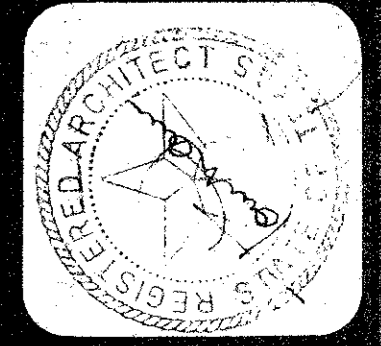

TOM F. DANCE & ASSOCIATES, INC.
ARCHITECTURE
8950 N. CENTRAL EXP. DALLAS, TEXAS 75231 214-691-4404
PLANNING

RECREATIONAL IMPROVEMENTS FOR
TRINITY PARK
TEXAS
ADDISON

SHEET NO.
4
OF 6