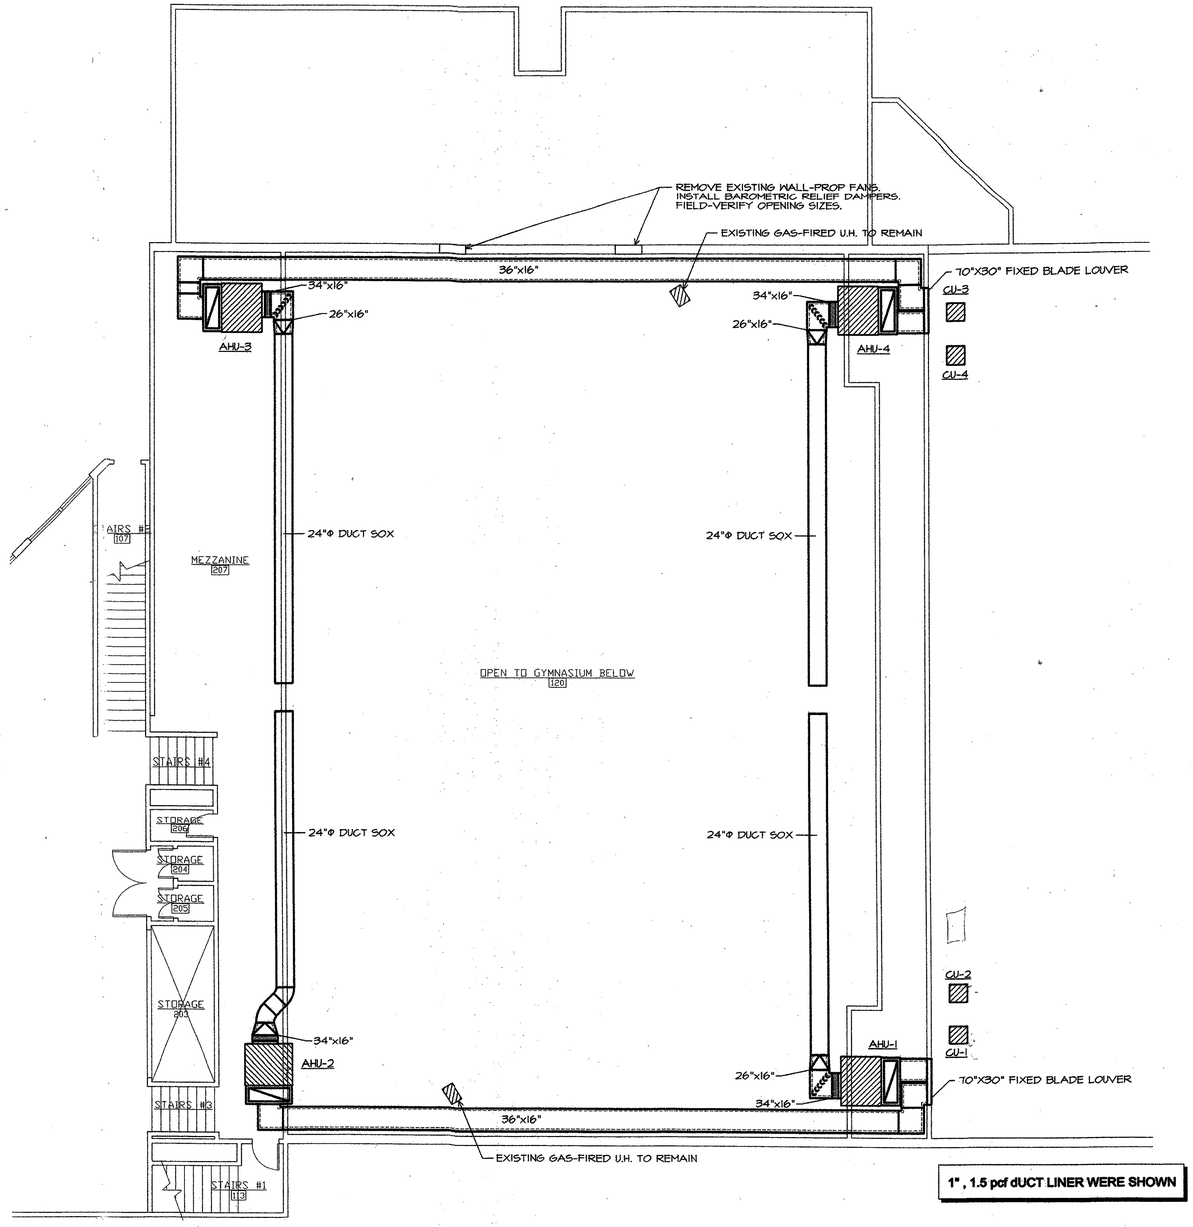

1" , 1.5 pcf dUCT LINER WERE SHOWN

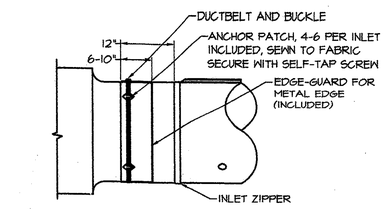

INLET ATTACHMENT DETAIL

DURATEX TYPE WITH ZIPPER AND OVERLAP

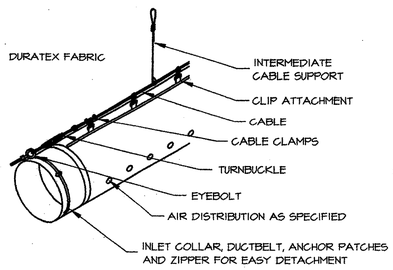

SUSPENSION DETAIL

1 ROW CABLE SUSPENSION AT 12 O'CLOCK

N

01 SECOND FLOOR PLAN - HVAC

SCALE:1/8"=1'-0"

REVISION	DESCRIPTION	DATE

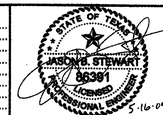

The seal appearing on this document was authorized by Jason B. Stewart, P.E. 86391 on 05-16-05.

VENTURE MECHANICAL, INC.

TRINITY ATHLETIC CENTER

ADDISON, TX

Drawn By: GCS | Checked By: | Date: 5-16-05

Job Number: ---

Sheet Number: M-1