
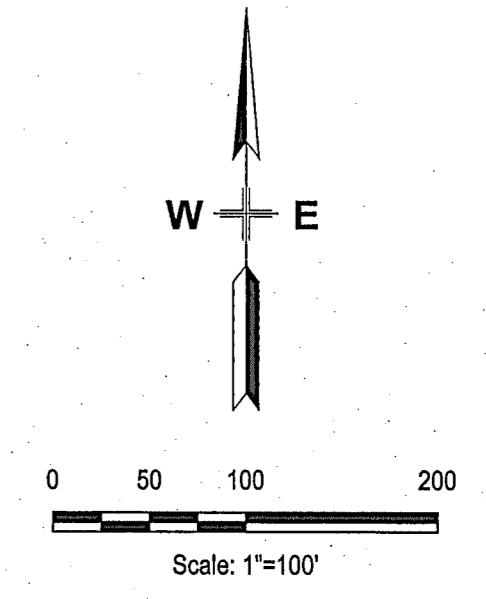
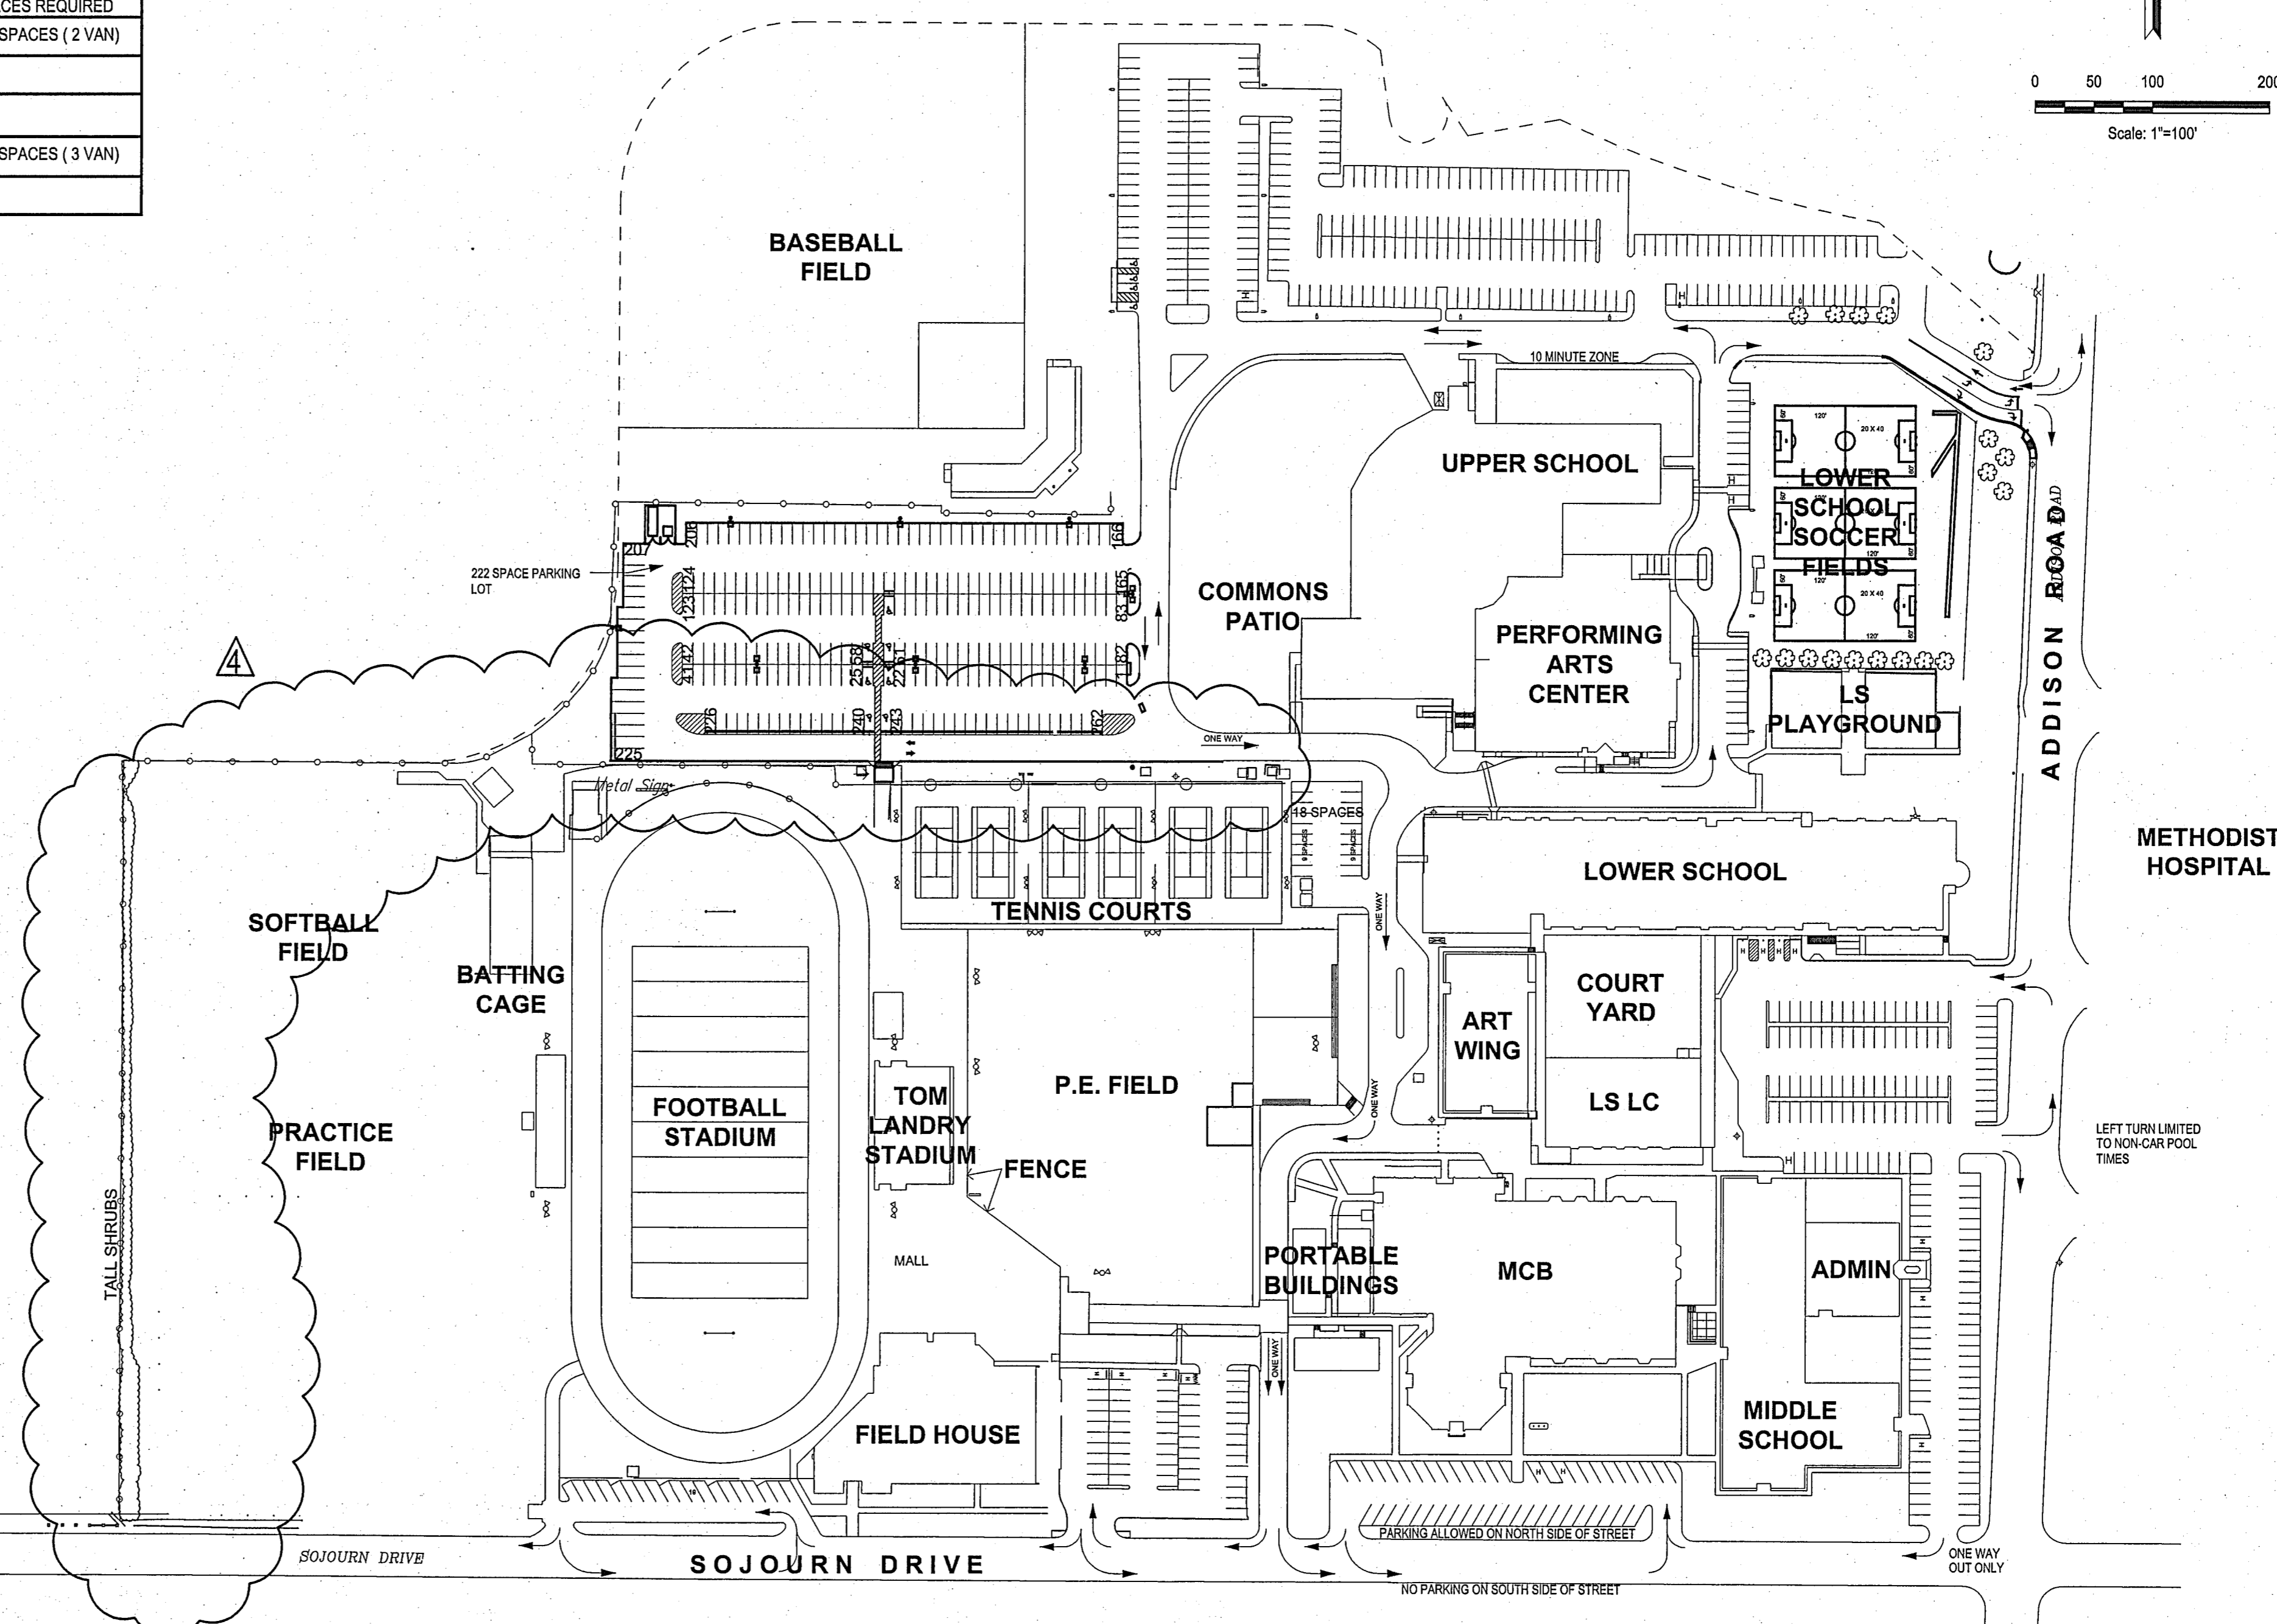



ADA PARKING SUMMARY			
	REGULAR SPACES	ADA HC ACCESSIBLE	ADA HC ACCESSIBLE SPACES REQUIRED
EXISTING SPACES ON CAMPUS	550 SPACES	18 SPACES (4 VAN)	11 SPACES (2 VAN)
TOTAL = 568 SPACES			
PROPOSED SPACES ON CAMPUS (262 NEW PARKING SPACES)	805 SPACES	25 SPACES (10 VAN)	17 SPACES (3 VAN)
TOTAL = 830 SPACES			

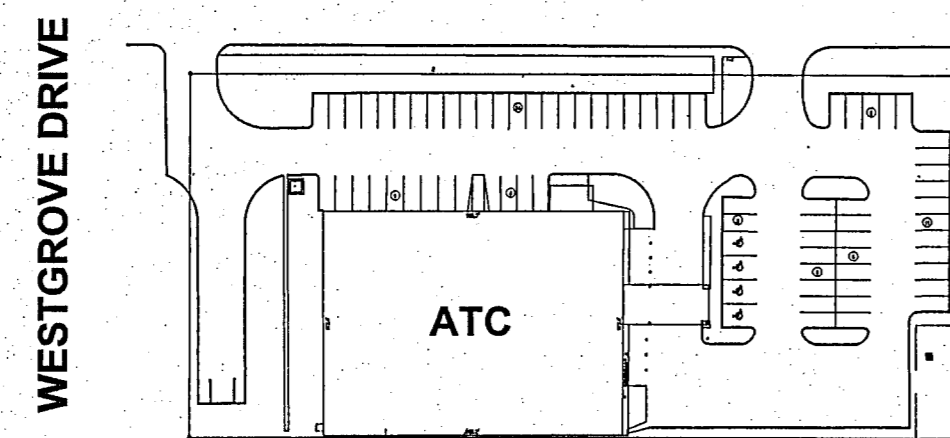

**GLENN ENGINEERING**  
 T.B.P.E. FIRM # F - 303  
 PHONE 972-717-5151  
 105 DECKER COURT, SUITE 910  
 IRVING, TEXAS 75062  
 FAX 972-717-2176

TRINITY CHRISTIAN ACADEMY  
 PARKING ADDITIONS

OVERALL SITE PLAN

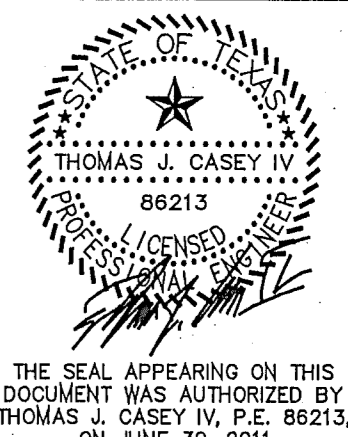

Issue Dates:  
 Review: Bid March 7, 2011  
 1 Revised Grading & HC Parking May 2, 2011  
 Re-Bid May 11, 2011  
 2 Town Comments, June 7, 2011  
 3 Town Comments #2, Removed Loop Road June 30, 2011  
 4

Construction:  
 Scale: AS NOTED  
 Drawn By: TJC  
 Checked By: CMA  
 Project No.: 10-599.150

Sheet 2  
 of 13