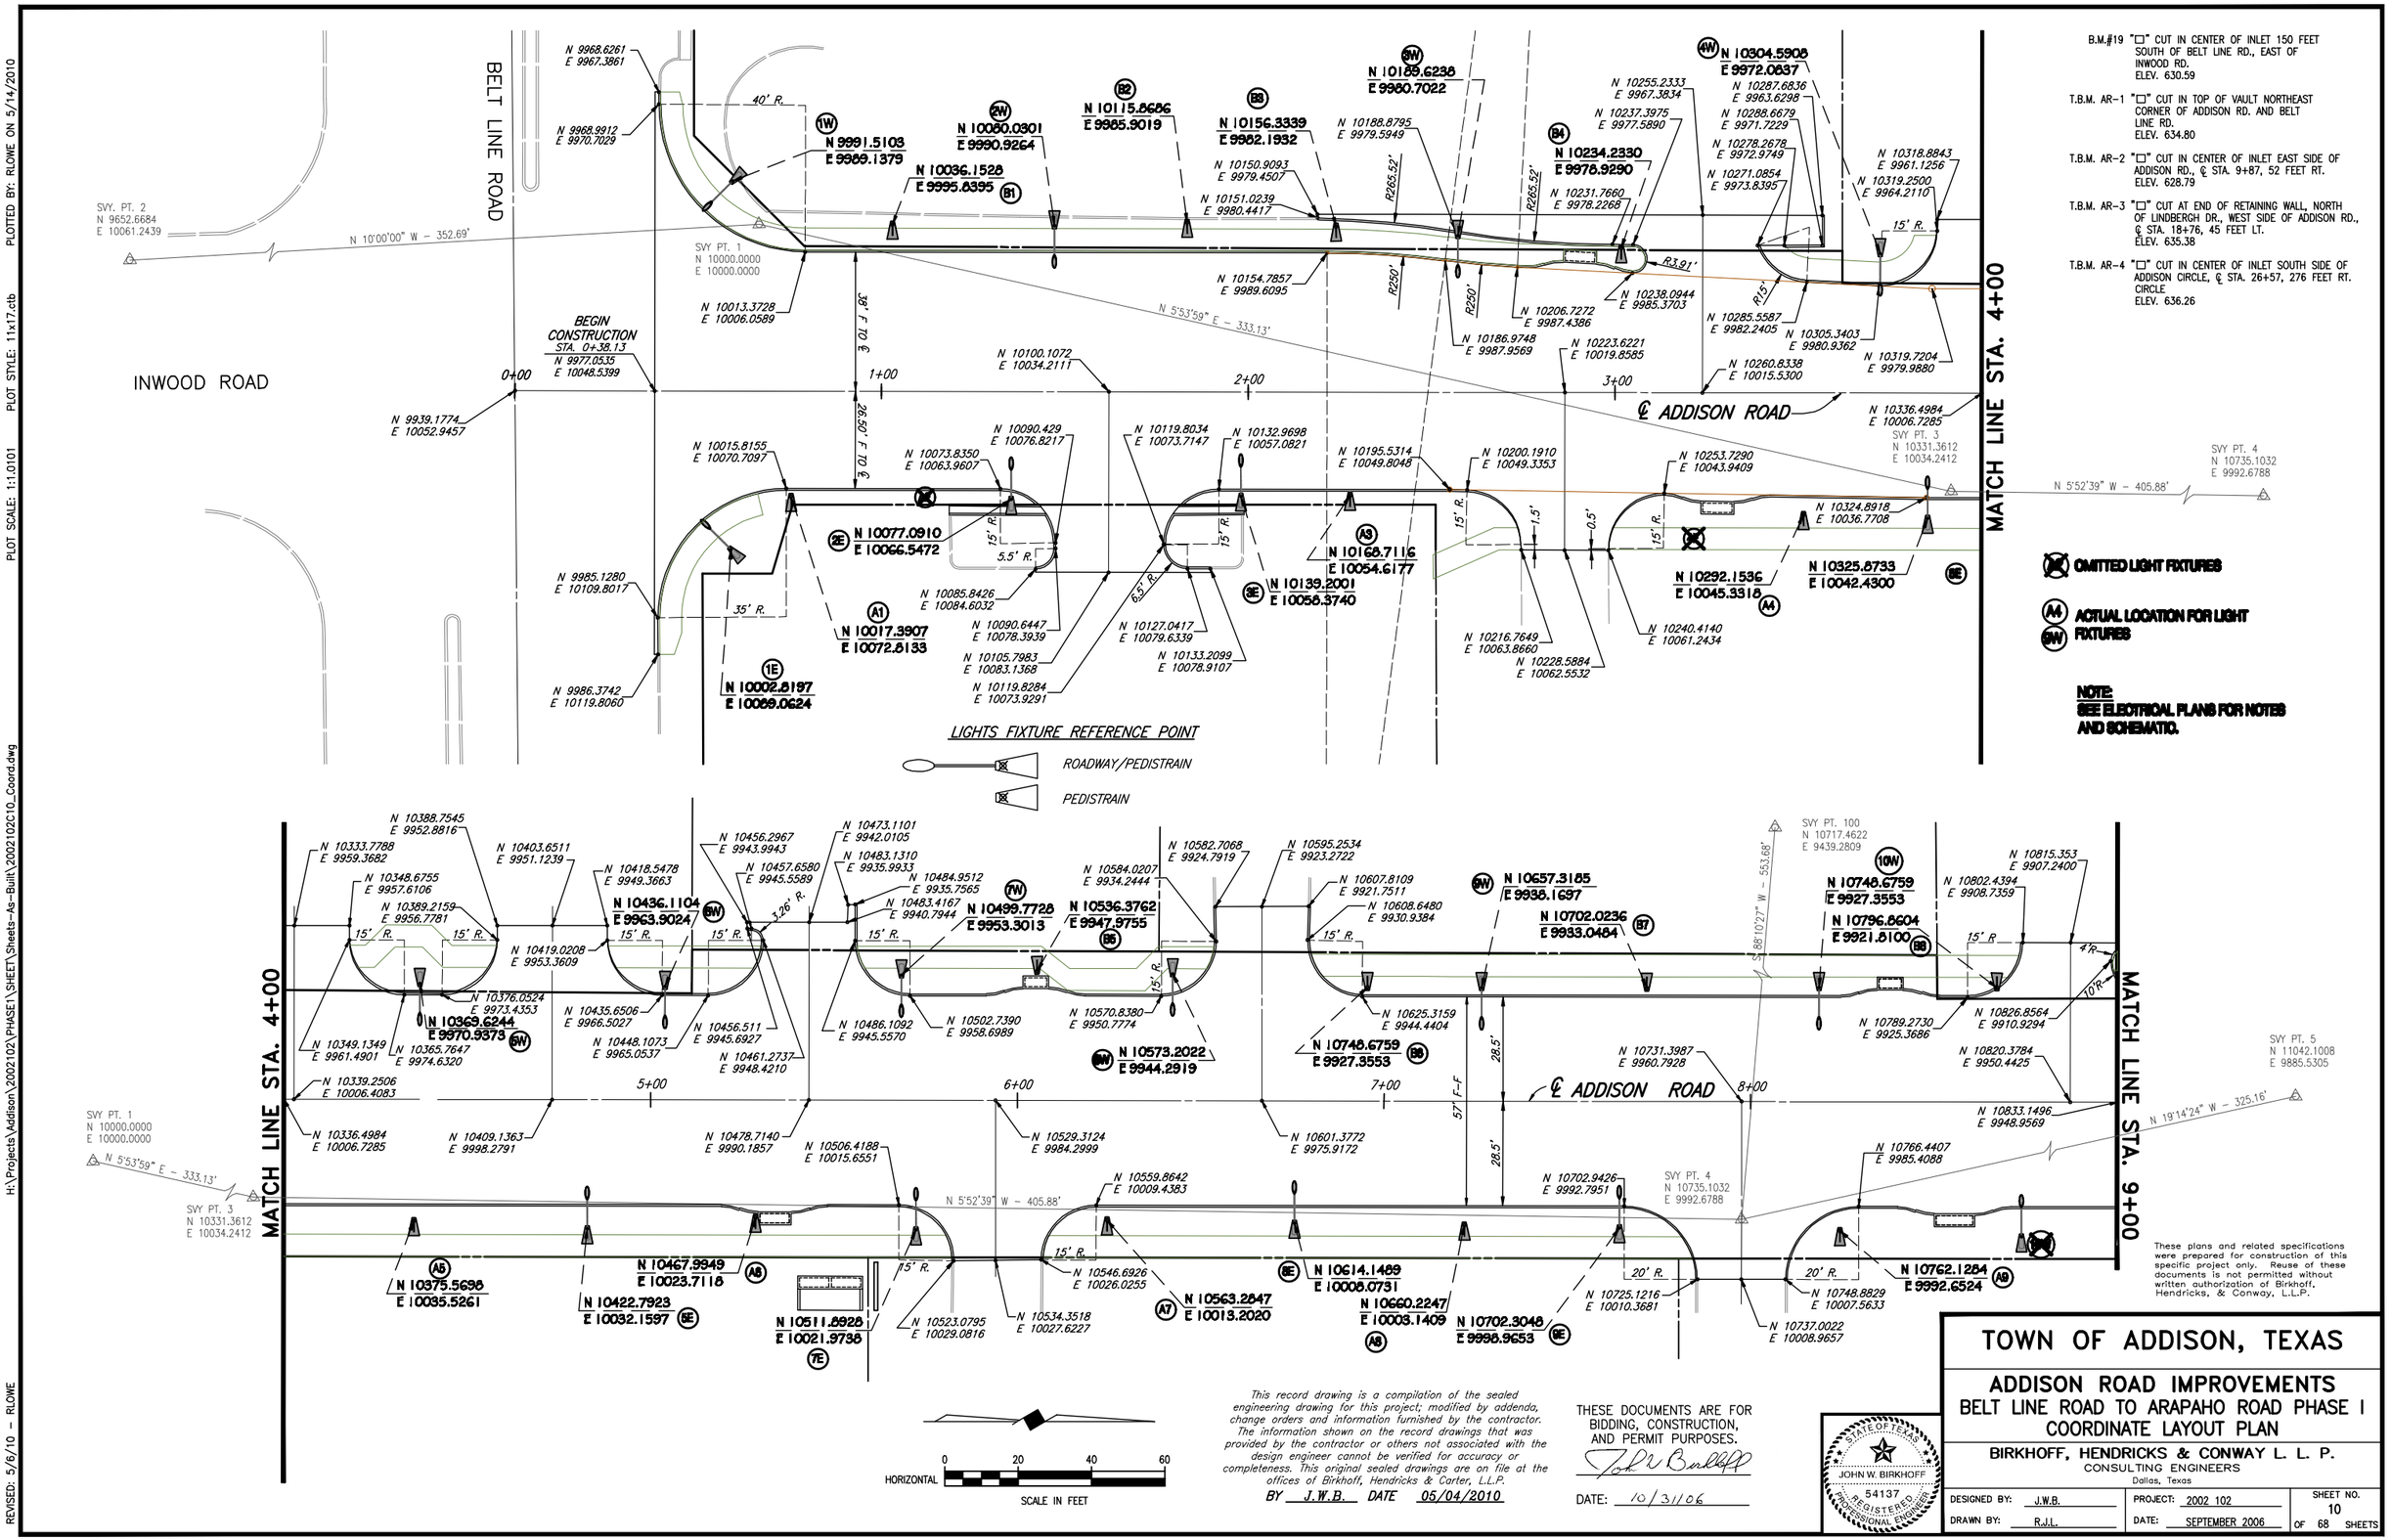

B.M.#19 "□" CUT IN CENTER OF INLET 150 FEET SOUTH OF BELT LINE RD., EAST OF INWOOD RD.
ELEV. 630.59

T.B.M. AR-1 "□" CUT IN TOP OF VAULT NORTHEAST CORNER OF ADDISON RD. AND BELT LINE RD.
ELEV. 634.80

T.B.M. AR-2 "□" CUT IN CENTER OF INLET EAST SIDE OF ADDISON RD., ℄ STA. 9+87, 52 FEET RT.
ELEV. 628.79

T.B.M. AR-3 "□" CUT AT END OF RETAINING WALL, NORTH OF LINDBERGH DR., WEST SIDE OF ADDISON RD., ℄ STA. 18+76, 45 FEET LT.
ELEV. 635.38

T.B.M. AR-4 "□" CUT IN CENTER OF INLET SOUTH SIDE OF ADDISON CIRCLE, ℄ STA. 26+57, 276 FEET RT. CIRCLE
ELEV. 636.26

OMITTED LIGHT FIXTURES

A4 ACTUAL LOCATION FOR LIGHT FIXTURES

NOTE:
SEE ELECTRICAL PLANS FOR NOTES AND SCHEMATIC.

This record drawing is a compilation of the sealed engineering drawing for this project, modified by addenda, change orders and information furnished by the contractor. The information shown on the record drawings that was provided by the contractor or others not associated with the design engineer cannot be verified for accuracy or completeness. This original sealed drawings are on file at the offices of Birkhoff, Hendricks & Carter, L.L.P.

BY J.W.B. *DATE* 05/04/2010

THESE DOCUMENTS ARE FOR BIDDING, CONSTRUCTION, AND PERMIT PURPOSES.

DATE: 10/31/06

STATE OF TEXAS
JOHN W. BIRKHOFF
54137
REGISTERED PROFESSIONAL ENGINEER

These plans and related specifications were prepared for construction of this specific project only. Reuse of these documents is not permitted without written authorization of Birkhoff, Hendricks, & Conway, L.L.P.

TOWN OF ADDISON, TEXAS

ADDISON ROAD IMPROVEMENTS
BELT LINE ROAD TO ARAPAHO ROAD PHASE I
COORDINATE LAYOUT PLAN

BIRKHOFF, HENDRICKS & CONWAY L. L. P.
CONSULTING ENGINEERS
Dallas, Texas

DESIGNED BY: J.W.B.	PROJECT: 2002 102	SHEET NO. 10 OF 68 SHEETS
DRAWN BY: R.J.L.	DATE: SEPTEMBER 2006	

PLOTTED BY: RLOWE ON 5/14/2010 PLOT STYLE: 11x17.ctb PLOT SCALE: 1:1.0101 H:\Projects\Addison\2002102\PHASE1\SHEET\Sheets-As-Built\20021020C10_Coord.dwg REVISED: 5/6/10 – RLOWE