


ESTIMATED QUANTITIES		UNIT	QUANTITY
32	18" R.C.P.	L.F.	70
30	30" R.C.P.	L.F.	209
17	Y-Type Inlet	EA	1
19	Recessed Curb-Type Inlet	EA	2
1	Remove Old Conc.	EA	5
35	Relocate W.L.	EA	3
36	Adjust Valve Boxes	EA	4
34	ADJUST M.H.	EA	1

LEGEND

- Bench Mark
- Hub and Tack
- Iron Pin
- Monument
- Gas Meter
- Gas Valve
- Gas Line
- Power Pole (typical pole symbol)
- Power Line
- Guy Wire and Anchor
- Telephone Cable Box or Meter
- Telephone Line
- Water Meter
- Water Valve
- Water Line
- Fire Hydrant
- Water Spigot
- Manhole
- Drainage Inlet
- Sanitary Sewer Line
- Storm Sewer Line
- Fence Line
- Flow Direction Indication
- Property or Right-of-Way Line
- Easement Line

Note: If Slope of New Storm Sewer Is Not Show On These Plans It Shall Be Placed At -0.5%

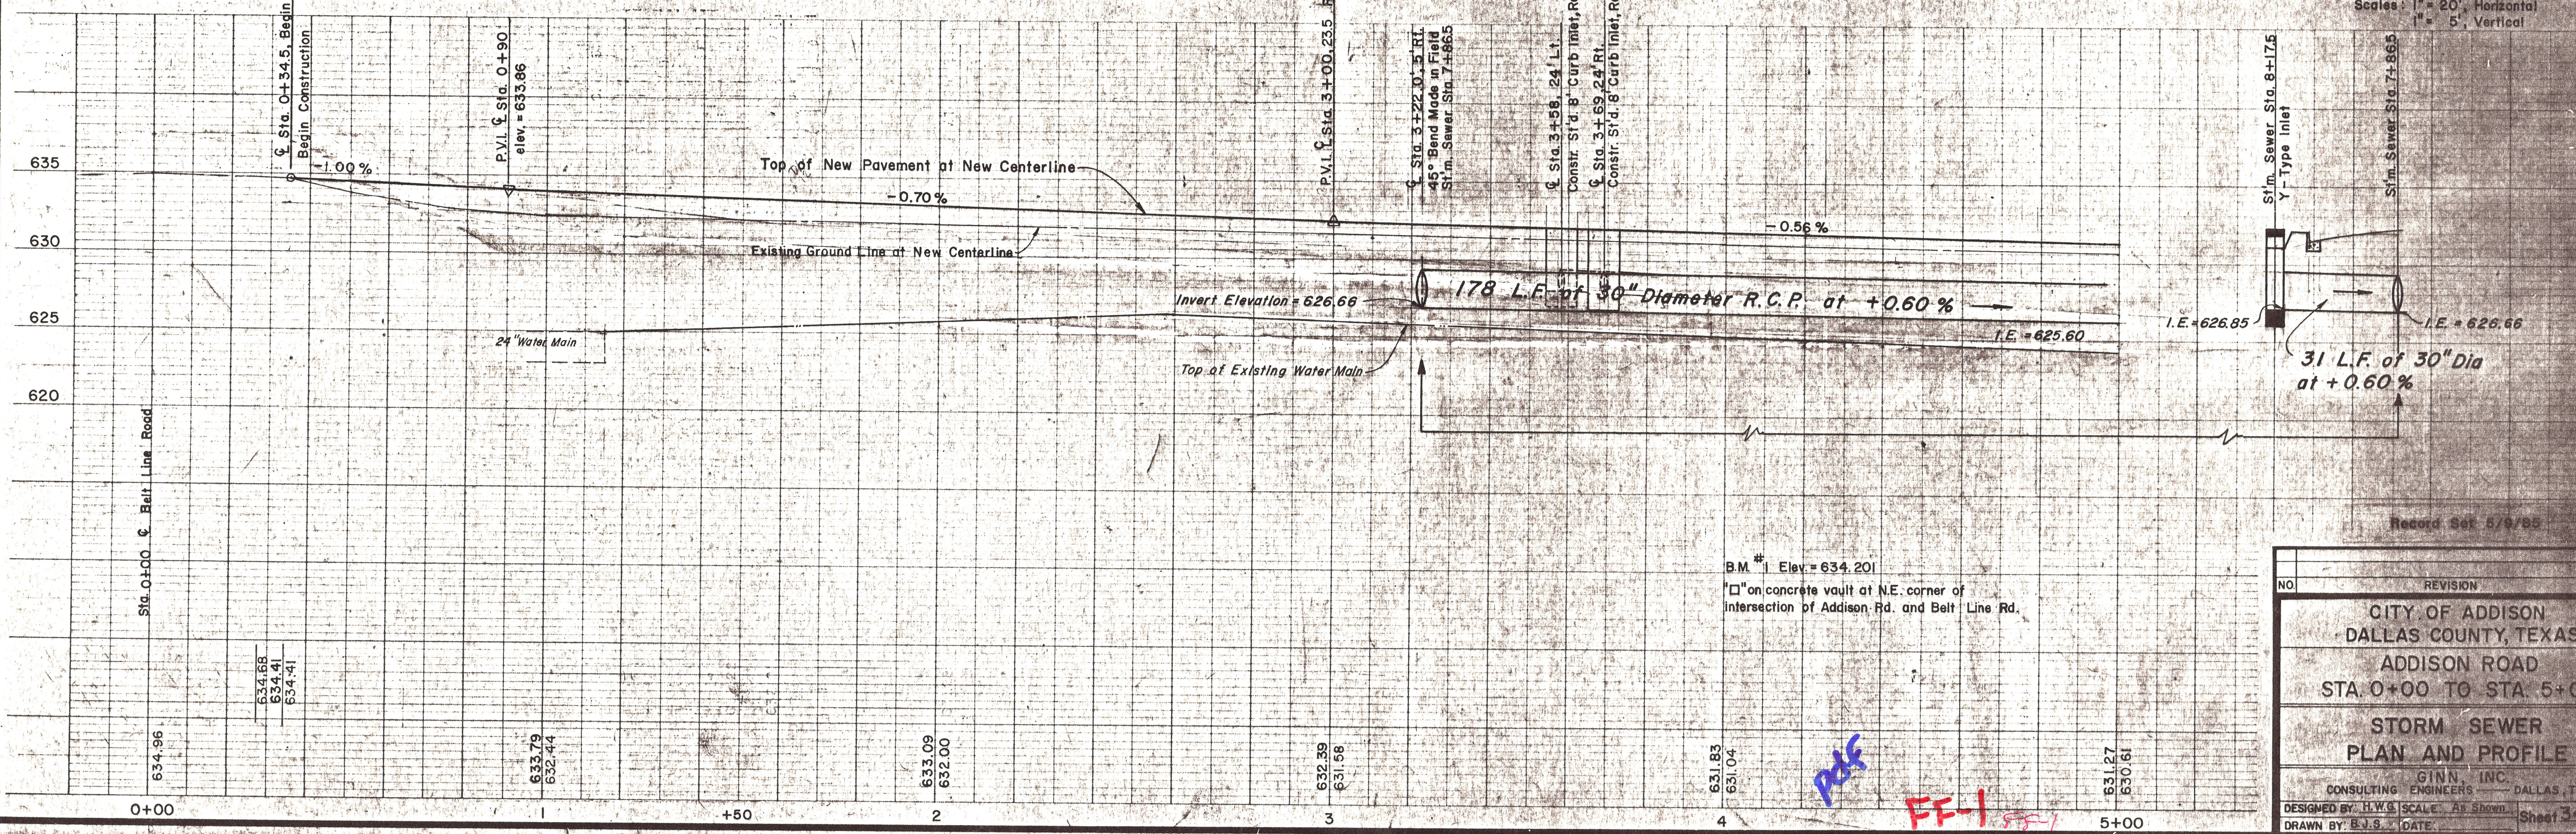

NO.	REVISION	BY	DATE
CITY OF ADDISON DALLAS COUNTY, TEXAS ADDISON ROAD STA 0+00 TO STA 5+00 STORM SEWER PLAN AND PROFILE GINN, INC. CONSULTING ENGINEERS - DALLAS, TEXAS DESIGNED BY: H.W.G. SCALE: As Shown DRAWN BY: B.J.S. DATE:			

Sheet 34 of