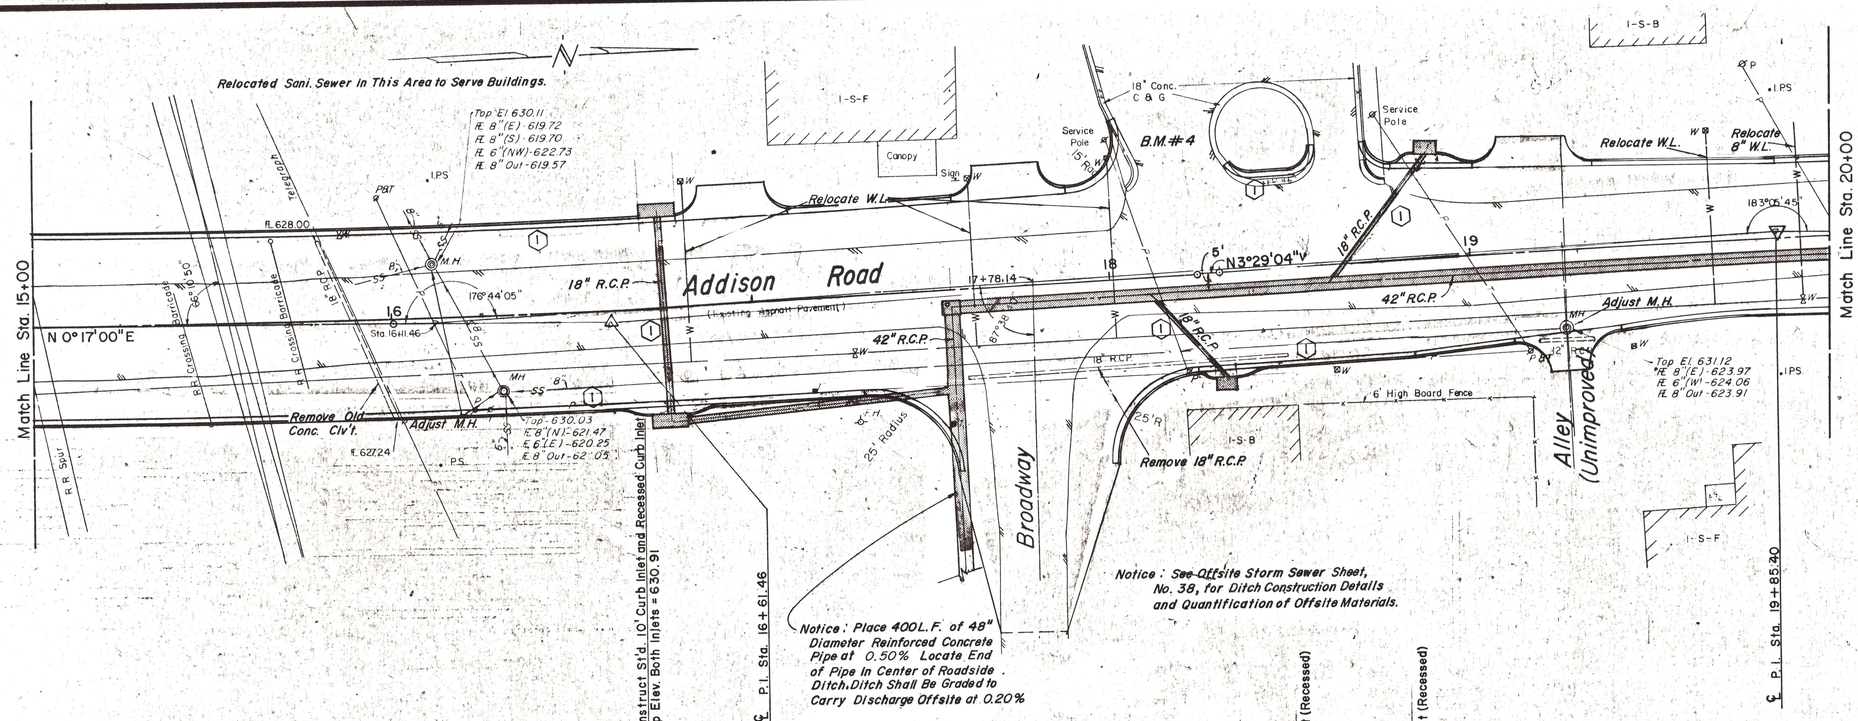

ESTIMATED QUANTITIES			
ITEM	DESCRIPTION	UNIT	QUANTITY
32	18" R.C.P.	L.F.	288 (1)
28	42" R.C.P.	L.F.	245
18	Std. Curb-Type Inlet	EA.	1
19	Recessed Curb-Type Inlet	EA.	3
21	" " Junction Box	EA.	
27	48" R.C.P.	L.F.	50
34	MANHOLE — Adjustments	EA.	3
1	Remove Old Conc.		4
33	Sewer Line Relocation (6")	L.F.	400
38	8" W.L.	L.F.	50
36	Adjust Valve Boxes	EA.	2
35	Adjust Water Lines	EA.	4
17	"Y" TYPE INLET	EA.	1

LEGEND

- Bench Mark
- Hub and Tack
- Iron Pin
- Monument
- Gas Meter
- Gas Valve
- Gas Line
- Power Pole (typical pole symbol)
- Power Line
- Guy Wire and Anchor
- Telephone Cable Box, or Riser
- Telephone Line
- Water Meter
- Water Valve
- Water Line
- Fire Hydrant
- Water Spigot
- Manhole
- Cleanout
- Drainage Inlet
- Sanitary Sewer Line
- Storm Sewer Line
- Fence Line
- Flow Direction Indicator
- Property or Right-of-Way Line
- Easement Line

Scales: 1" = 20', Horizontal
1" = 5', Vertical

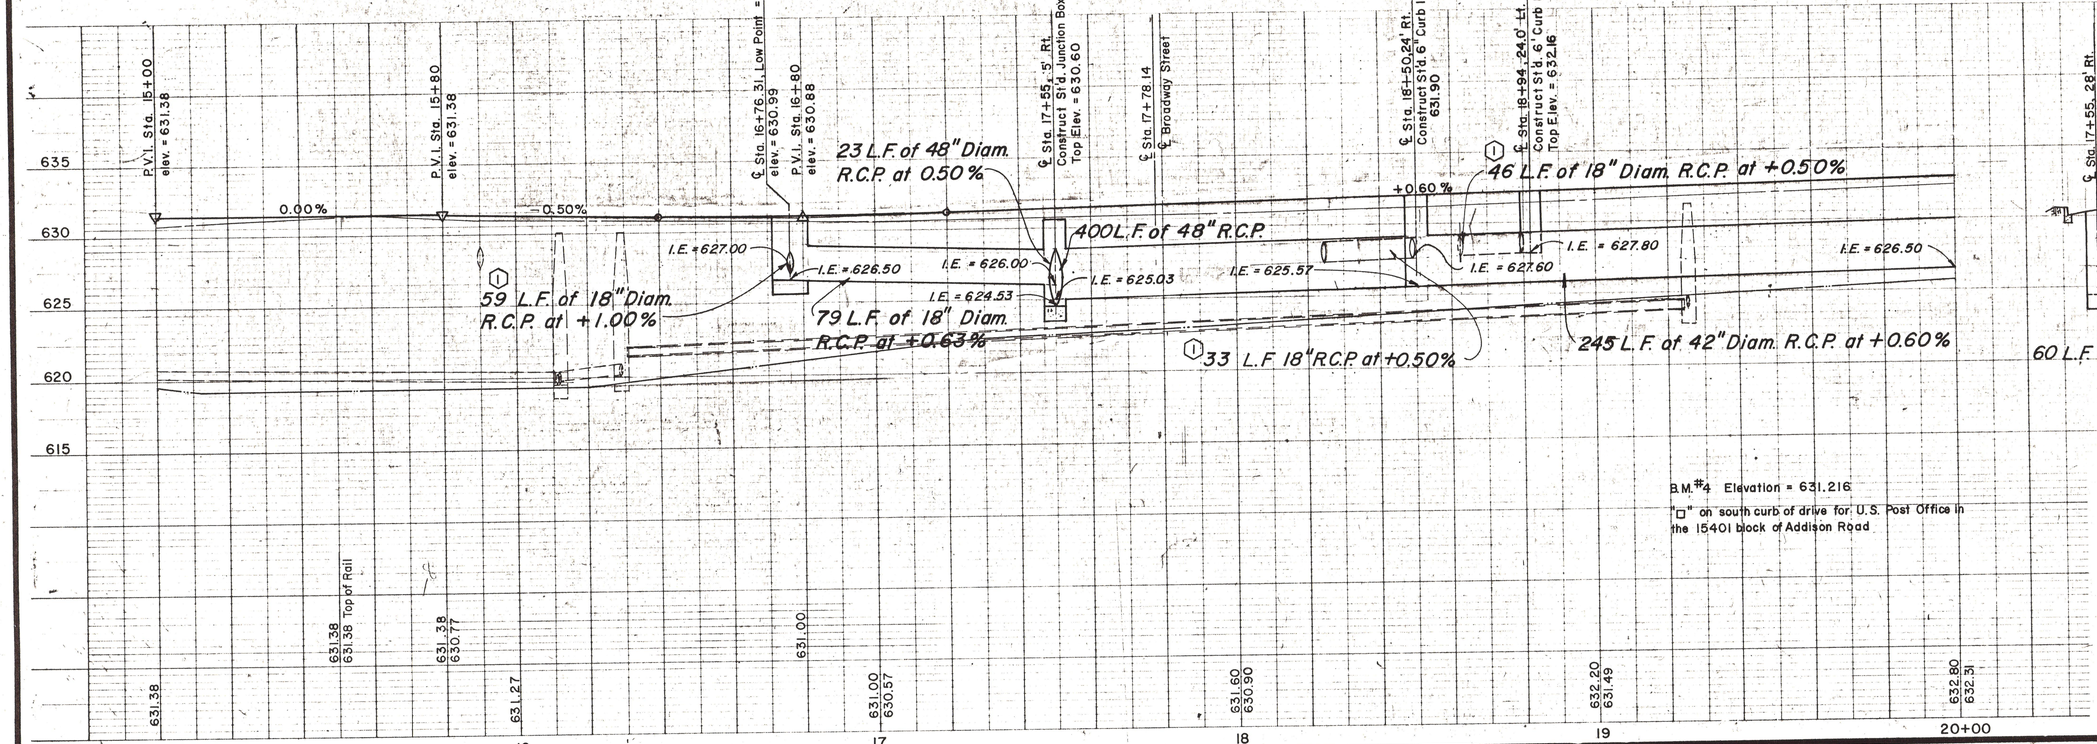

Record Set 5/9/85

B.M.#4 Elevation = 631.216
"□" on south curb of drive for U.S. Post Office in the 15401 block of Addison Road

NO	REVISION	BY	DATE
(1)	Changed Pipe Lengths, Slopes; Widened Pvm't.; J.B.	B.S.	12-14-79

CITY OF ADDISON
DALLAS COUNTY, TEXAS

ADDISON ROAD
STA. 15+00 TO STA. 20+00

STORM SEWER
PLAN AND PROFILE

GINN, INC.
CONSULTING ENGINEERS — DALLAS, TEXAS

DESIGNED BY: H.W.G. SCALE: As Shown
DRAWN BY: B.J.S. DATE:
Sheet 37 of
Job No. 157