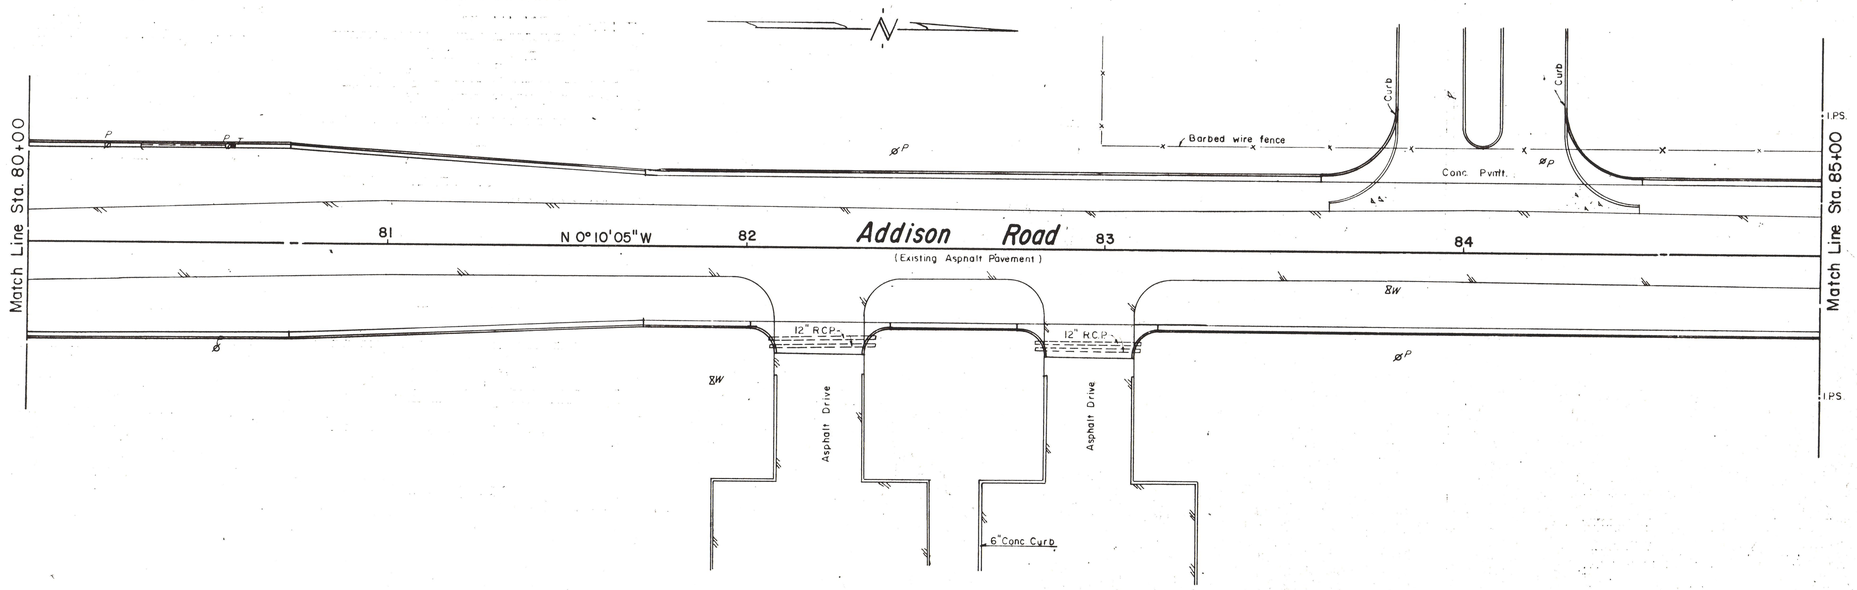

ESTIMATED QUANTITIES

ITEM	DESCRIPTION	UNIT	QUANTITY
1	Remove Old Conc.	Ea.	5
36	Adjust Valve Box	Ea.	1

LEGEND

- Bench Mark
- Hub and Tack
- I.P. Iron Pin
- MON. Monument
- Gas Meter
- Gas Valve
- Gas Line
- Power Pole (typical pole symbol)
- Power Line
- Guy Wire and Anchor
- Telephone Cable Box, or Riser
- Telephone Line
- Water Meter
- Water Valve
- Water Line
- Fire Hydrant
- Water Spigot
- MH Manhole
- CO Cleanout
- DI Drainage Inlet
- SS Sanitary Sewer Line
- SD Storm Sewer Line
- Fence Line
- Flow Direction Indicator
- Property or Right-of-Way Line
- Easement Line

Scales: 1" = 20', Horizontal
1" = 5', Vertical

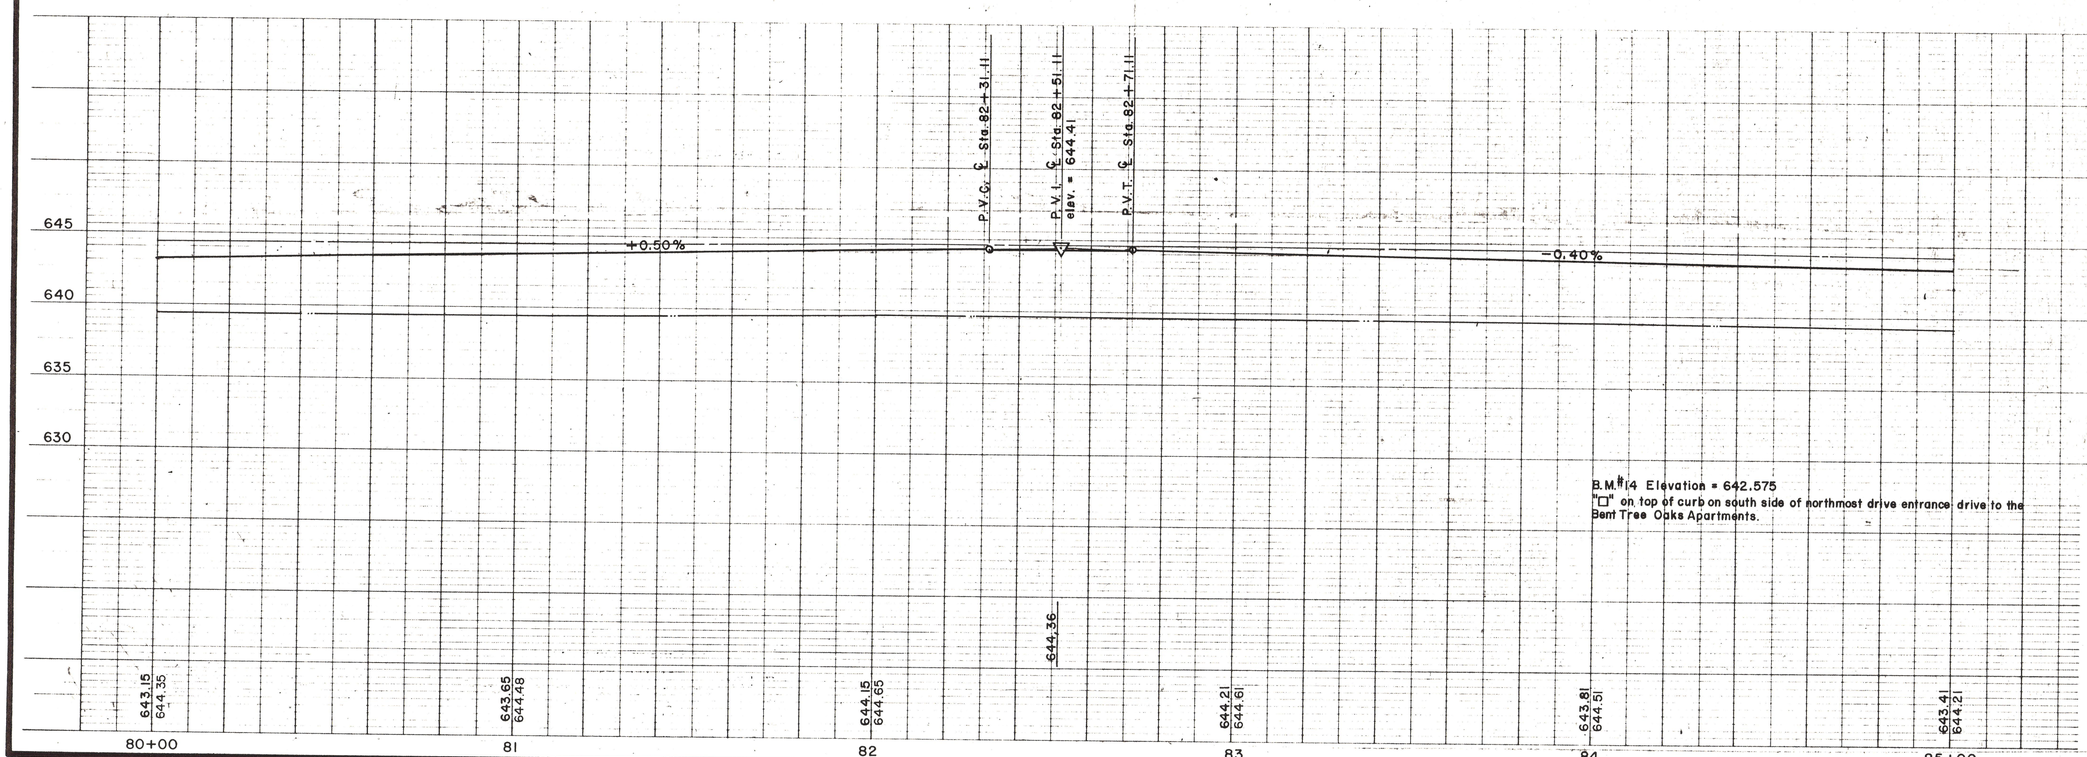

B.M.#4 Elevation = 642.575
"□" on top of curb on south side of northmost drive entrance drive to the Bent Tree Oaks Apartments.

Record Set 5/9/85

NO.	REVISION	BY	DATE

CITY OF ADDISON
DALLAS COUNTY, TEXAS

ADDISON ROAD
STA. 80+00 TO STA. 85+00

STORM SEWER
PLAN AND PROFILE

GINN, INC.
CONSULTING ENGINEERS — DALLAS, TEXAS

DESIGNED BY: H.W.G. | SCALE: As Shown
DRAWN BY: B.J.S. | DATE:

Sheet 51 of ____