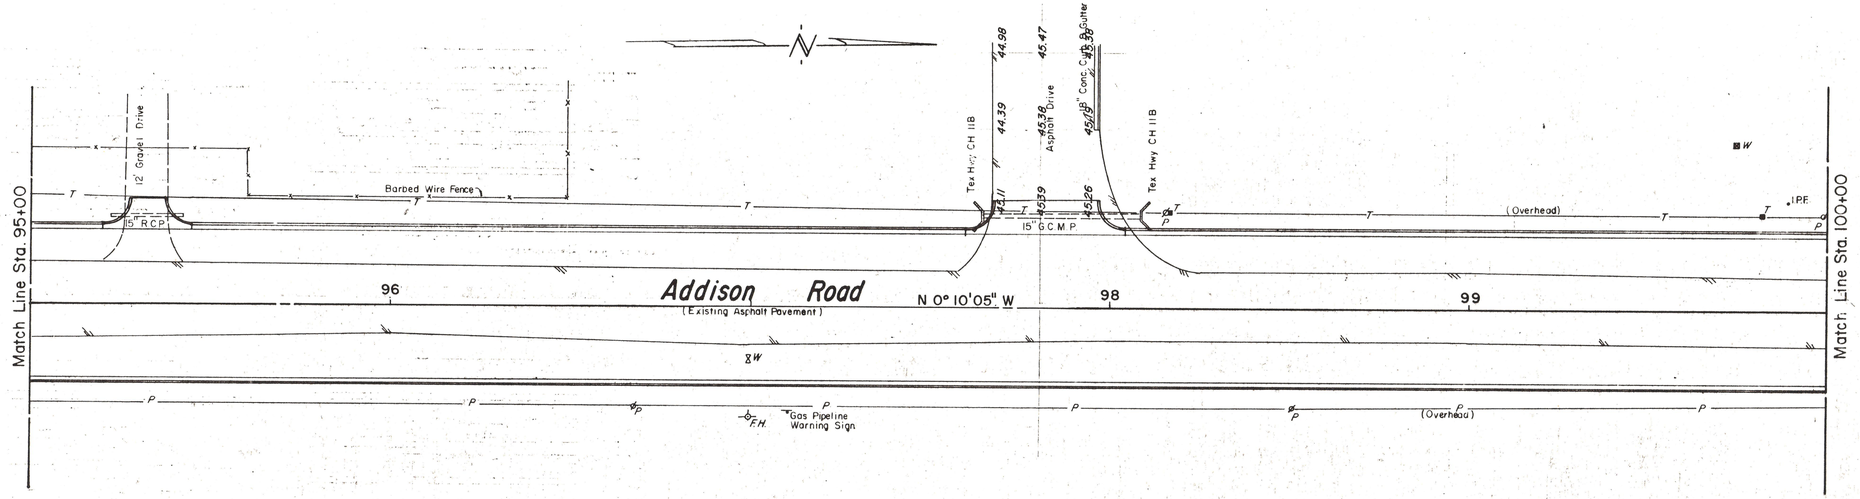

ESTIMATED QUANTITIES			
ITEM	DESCRIPTION	UNIT	QUANTITY
1	Remove Old Conc.	Ea.	2
36	Adjust Valve Box	Ea.	1

LEGEND

- Bench Mark
- Hub and Tack
- I.R.P. Iron Pin
- Monument
- Gas Meter
- Gas Valve
- Gas Line
- Power Pole (typical pole symbol)
- Power Line
- Guy Wire and Anchor
- Telephone Cable Box, or Riser
- Telephone Line
- Water Meter
- Water Valve
- Water Line
- Fire Hydrant
- Water Spigot
- Manhole
- Cleanout
- Drainage Inlet
- Sanitary Sewer Line
- Storm Sewer Line
- Fence Line
- Flow Direction Indicator
- Property or Right-of-Way Line
- Easement Line

Scales : 1" = 20', Horizontal
1" = 5', Vertical

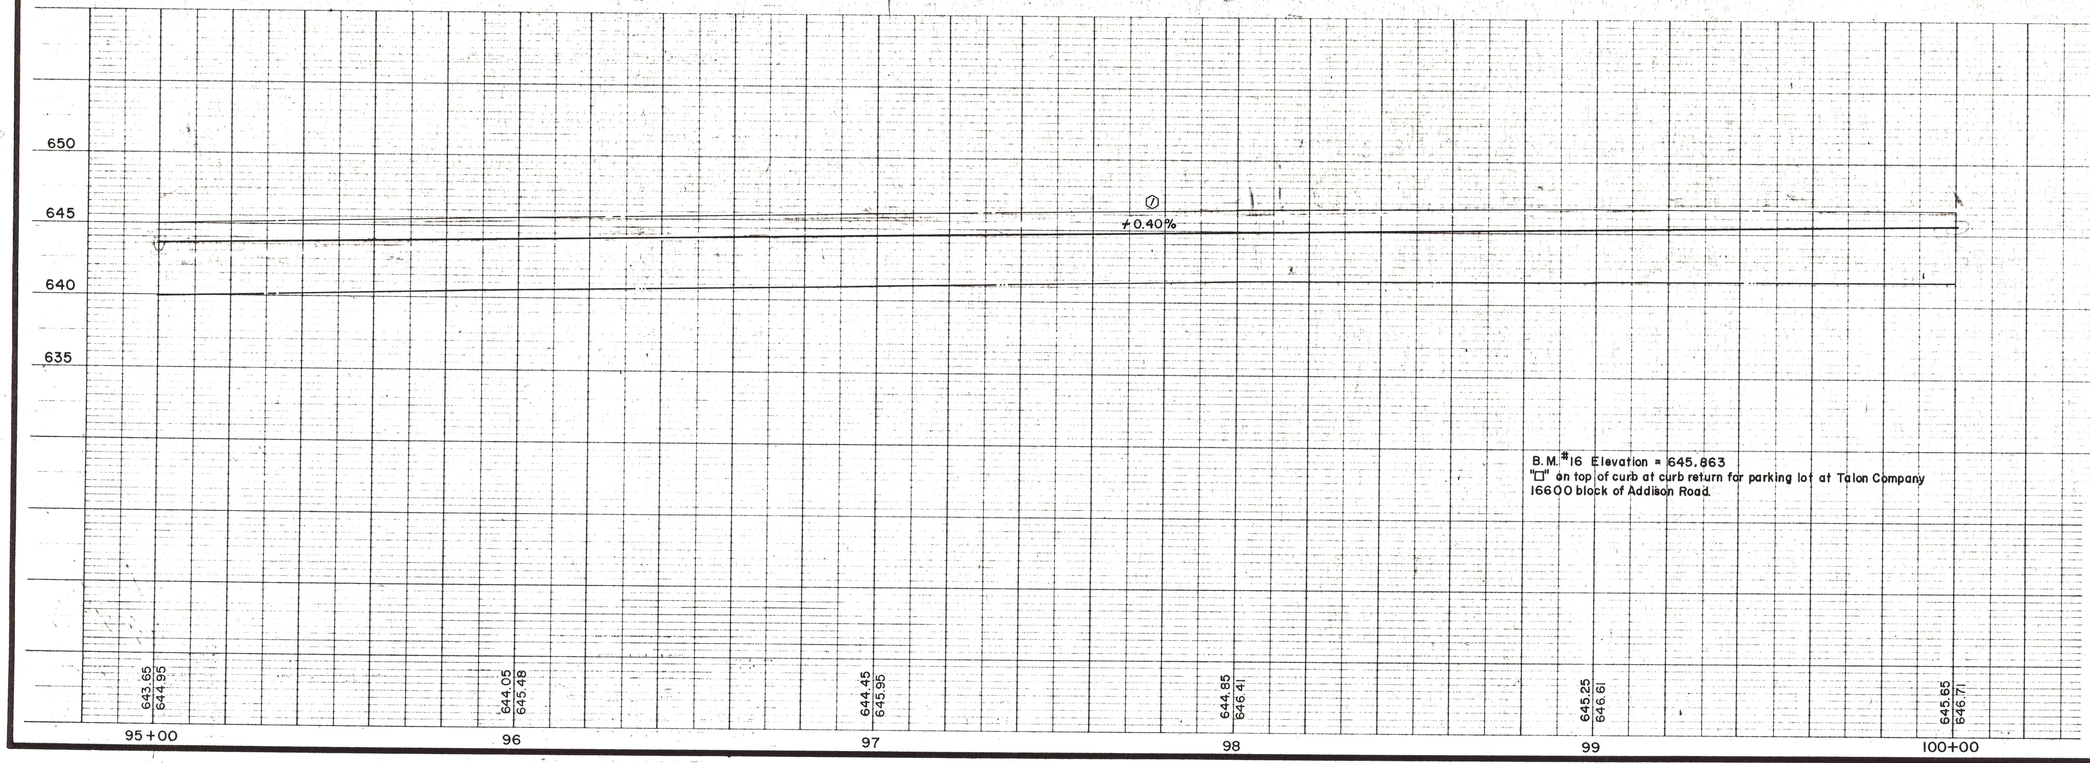

B.M. #16 Elevation = 645.863
"□" on top of curb at curb return for parking lot at Talon Company 16600 block of Addison Road.

Record Set 5/9/85

NO	REVISION	BY	DATE
①	Grade Chg	S.M.	8-1479

CITY OF ADDISON
DALLAS COUNTY, TEXAS

ADDISON ROAD
STA. 95+00 TO STA. 100+00

STORM SEWER
PLAN AND PROFILE

GINN, INC.
CONSULTING ENGINEERS — DALLAS, TEXAS

DESIGNED BY: H.W.G. SCALE: As Shown
DRAWN BY: B.J.S. DATE:

Sheet 55 of ____