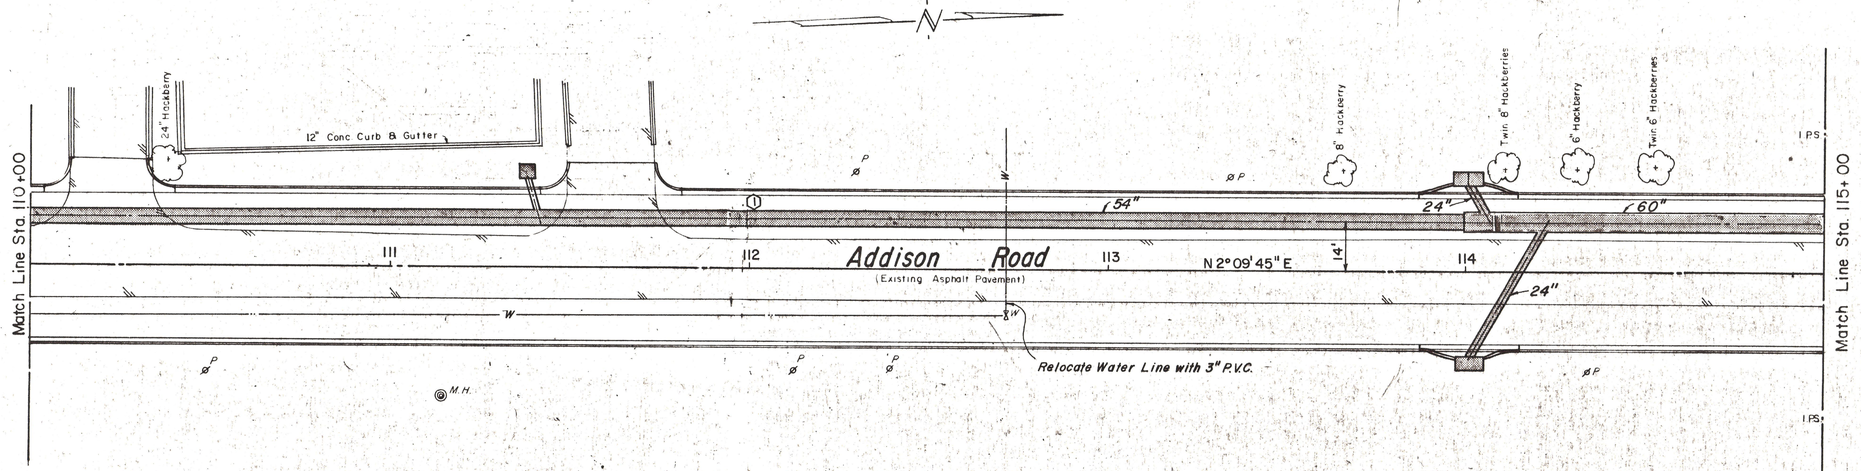

ESTIMATED QUANTITIES			
ITEM	DESCRIPTION	UNIT	QUANTITY
31	24" R.C.P.	L.F.	75
26	54" R.C.P.	L.F.	400
	60" R.C.P.	L.F.	100
20	Grated Inlet	EA.	1
19	Recessed Curb Inlet	EA.	2
37	6" P.V.C. SDR18 W.L.	L.F.	30
36	Adjust Valve Boxes	EA.	1

LEGEND

- Bench Mark
- Hub and Tack
- Iron Pin
- Monument
- Gas Meter
- Gas Valve
- Gas Line
- Power Pole (typical pole symbol)
- Power Line
- Guy Wire and Anchor
- Telephone Cable Box, or Riser
- Telephone Line
- Water Meter
- Water Valve
- Water Line
- Fire Hydrant
- Water Spigot
- Manhole
- Cleanout
- Drainage Inlet
- Sanitary Sewer Line
- Storm Sewer Line
- Fence Line
- Flow Direction Indicator
- Property or Right-of-Way Line
- Easement Line

Scales: 1" = 20', Horizontal
1" = 5', Vertical

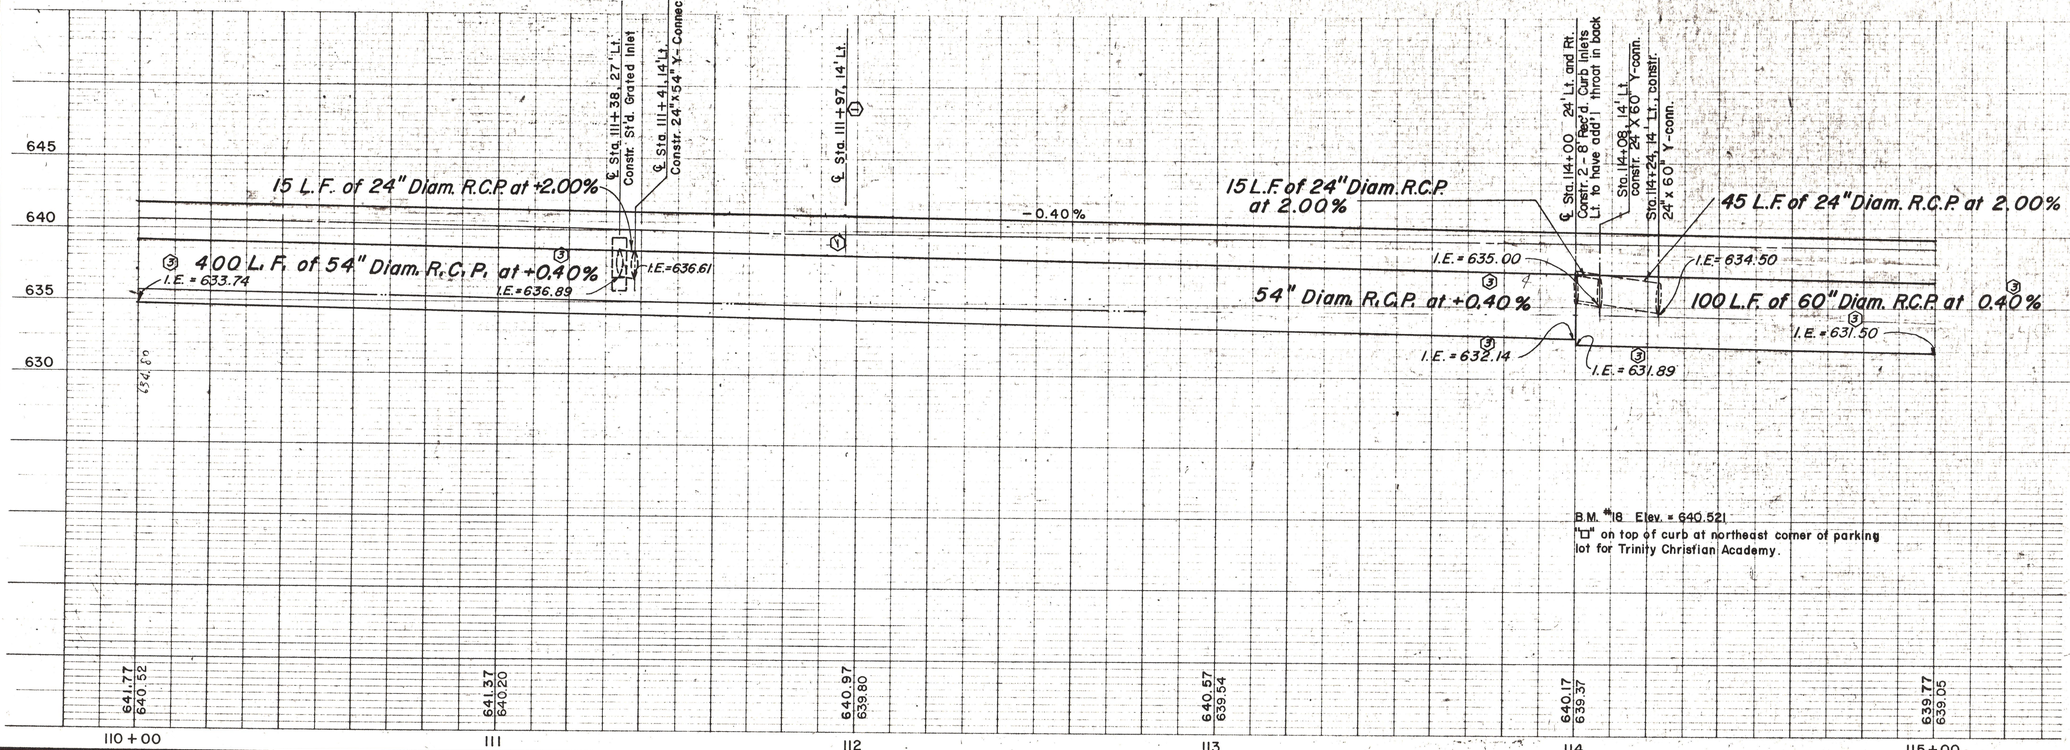

B.M. #18 Elev. = 640.521
"□" on top of curb at northeast corner of parking lot for Trinity Christian Academy.

Record Set 5/9/88

NO.	REVISION	BY	DATE
3	Corrected Elevations & Slope		D.D. 6-19-79
2	Drainage Change		G.F. 5-27-79
1	Delete Junction Box		B.S. 2-14-79

CITY OF ADDISON
DALLAS COUNTY, TEXAS

ADDISON ROAD
STA. 110+00 TO STA. 115+00

STORM SEWER
PLAN AND PROFILE

GINN, INC.
CONSULTING ENGINEERS — DALLAS, TEXAS

DESIGNED BY: H.W.G. SCALE: As Shown
DRAWN BY: B.J.S. DATE:

Sheet 58 of