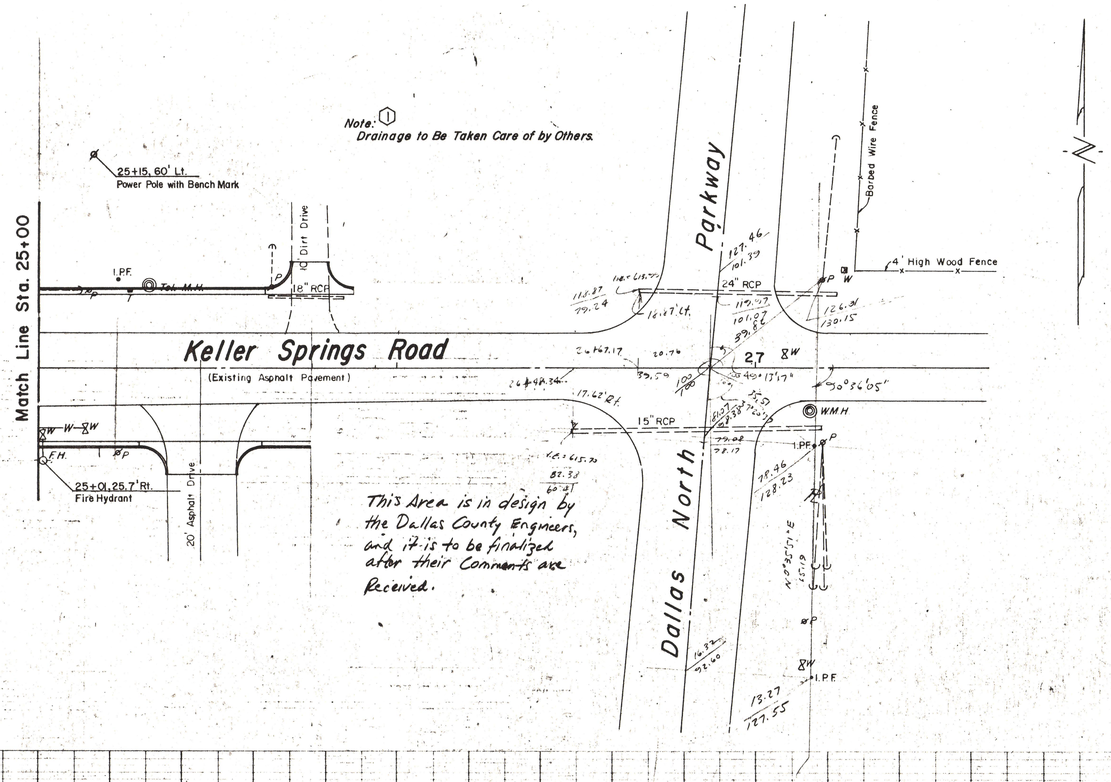

ESTIMATED QUANTITIES			
ITEM	DESCRIPTION	UNIT	QUANTITY
34	Adjust M.H.	Ea.	1
36	Adjust Valve Box	Ea.	1

Scales: 1" = 20', Horizontal
1" = 5', Vertical

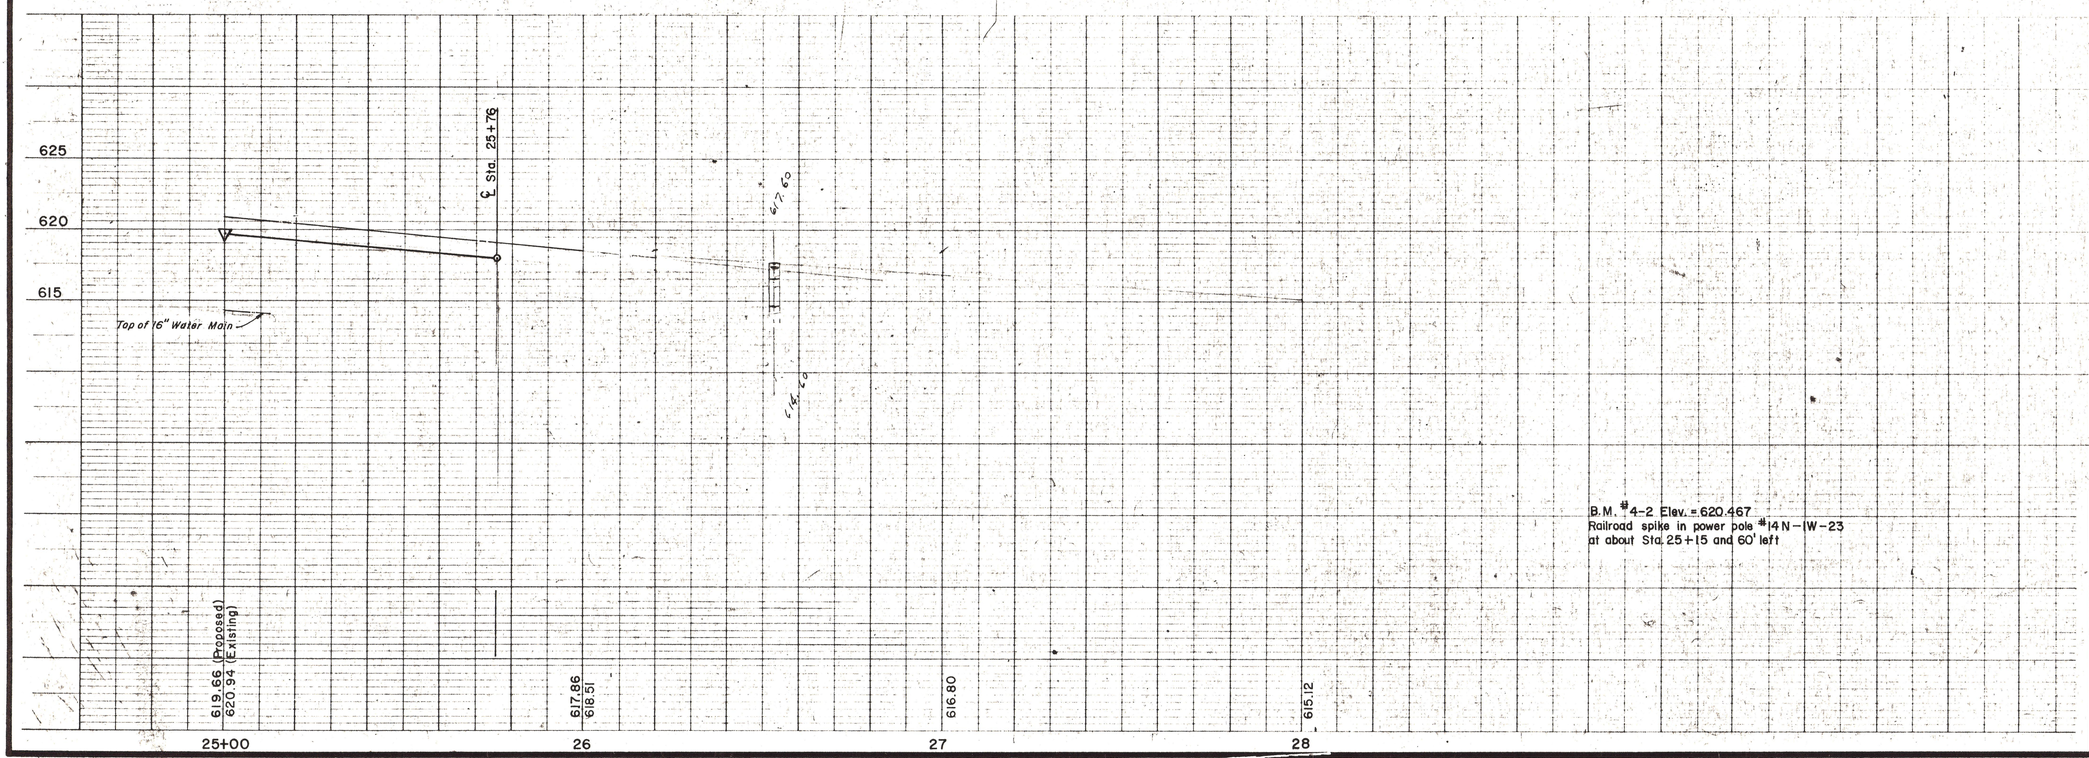

B.M. #4-2 Elev. = 620.467
Railroad spike in power pole #14N-1W-23
at about Sta. 25+15 and 60' left

Record Set 5/9/85

NO.	REVISION	BY	DATE
1	Note Added	B.S.	12-14-78

CITY OF ADDISON
DALLAS COUNTY, TEXAS

KELLER SPRINGS ROAD
STA. 25+00 TO STA. 27+00

STORM SEWER
PLAN AND PROFILE

GINN, INC.
CONSULTING ENGINEERS — DALLAS, TEXAS

DESIGNED BY: H.W.G. SCALE: As Shown
DRAWN BY: B.J.S. DATE:
Sheet 66 of