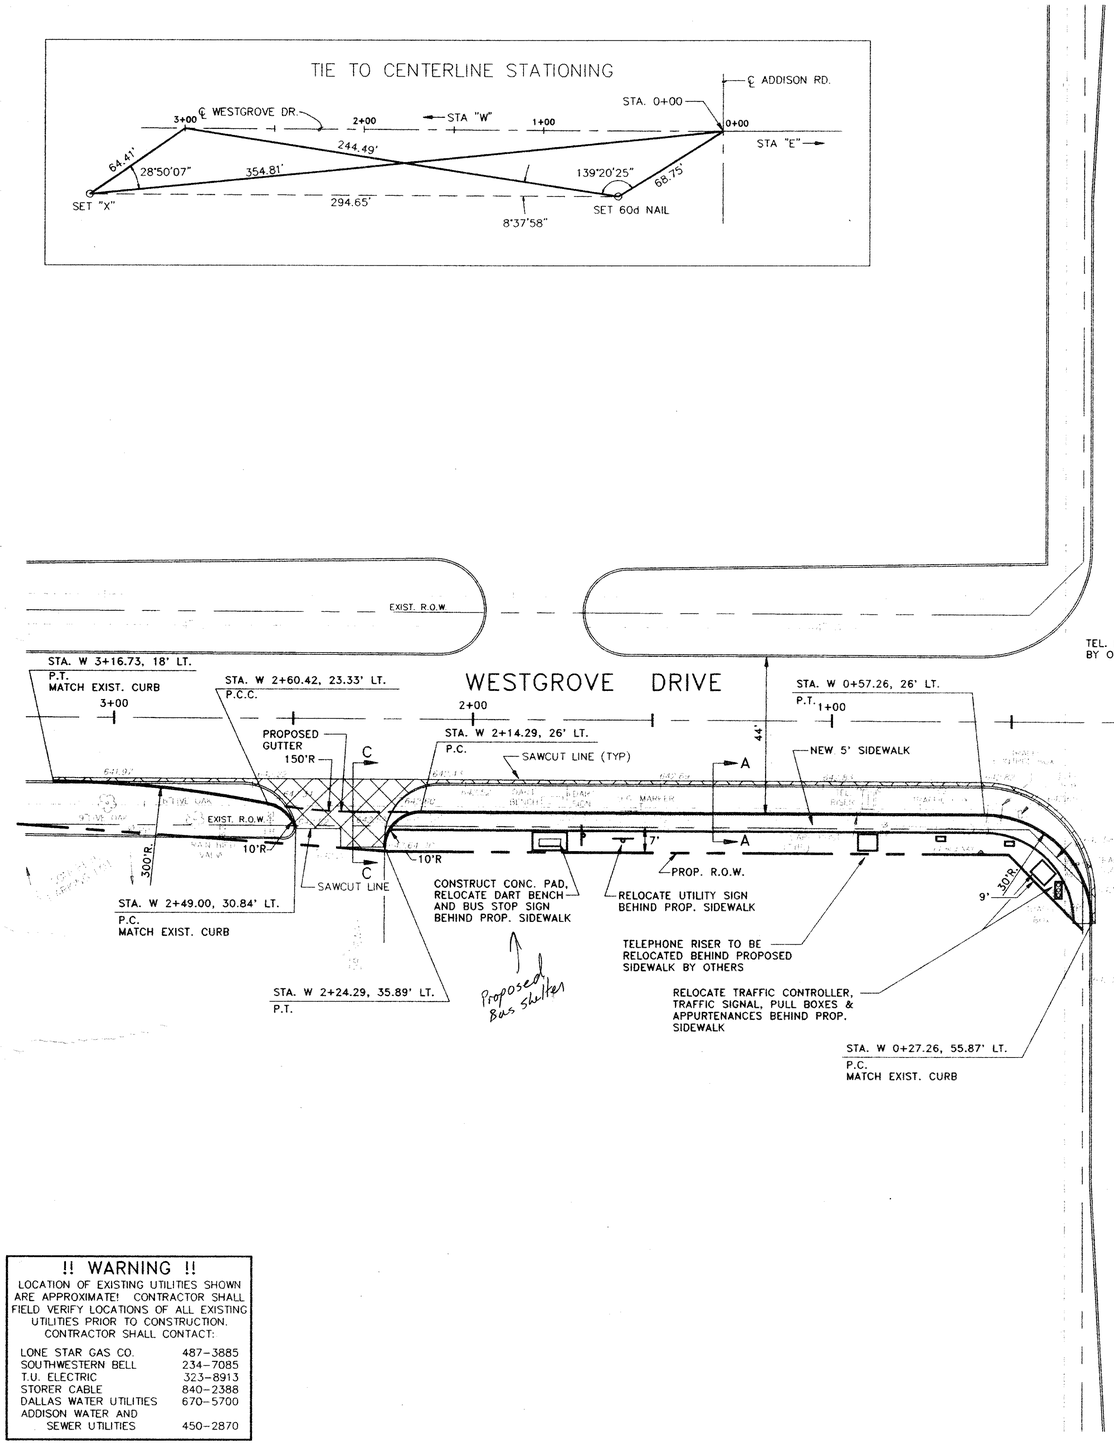

20 0 20 40
scale 1" = 20' feet

BENCHMARK

FOUND "□" CUT AT THE NORTHEAST CORNER OF ADDISON ROAD AND WESTGROVE DRIVE ±60' EAST OF CENTERLINE OF ADDISON ROAD.
ELEV. 641.96

!! WARNING !!

LOCATION OF EXISTING UTILITIES SHOWN ARE APPROXIMATE! CONTRACTOR SHALL FIELD VERIFY LOCATIONS OF ALL EXISTING UTILITIES PRIOR TO CONSTRUCTION. CONTRACTOR SHALL CONTACT:

LONE STAR GAS CO.	487-3885
SOUTHWESTERN BELL	234-7085
T.U. ELECTRIC	323-8913
STORER CABLE	840-2388
DALLAS WATER UTILITIES	670-5700
ADDISON WATER AND SEWER UTILITIES	450-2870

NOTES

1. CONTRACTOR SHALL DETERMINE THE LOCATION OF, AND REMOVE AND/OR RELOCATE, ALL AFFECTED SPRINKLER SYSTEMS INCLUDING HEADS, METERS, LINES AND OTHER APPURTENANCES AS DIRECTED BY THE TOWN OF ADDISON. (NO SEPARATE PAY ITEM)
2. CONTRACTOR SHALL REMOVE AND/OR RELOCATE ALL EXISTING LANDSCAPING IMPROVEMENTS INCLUDING TREES, SHRUBS, BOULDERS AND STEEL EDGING AS DIRECTED BY THE TOWN OF ADDISON. (NO SEPARATE PAY ITEM)
3. CONTRACTOR SHALL MATCH EXISTING PAVEMENT ELEVATION AT SAWCUT LINE.
4. ALL DIMENSIONS ARE TO FACE OF CURB UNLESS OTHERWISE NOTED.

LEGEND

- REMOVE EXISTING PAVEMENT AND SIDEWALK
- CONSTRUCT NEW PAVEMENT
- CONSTRUCT NEW SIDEWALK
- EXISTING CURB
- PROPOSED CURB
- +636.23 PROPOSED ELEVATION
- +636.23 EXISTING ELEVATION
- 12"W — WATER LINE (SIZE)
- 8"SS — MH — SANITARY SEWER LINE AND MANHOLE (SIZE)
- T — SOUTHWESTERN BELL TELEPHONE CABLE
- 4"G — LONE STAR GAS LINE
- OH — PP — OVERHEAD POWER LINE AND POLE
- CATV — UNDERGROUND CABLE TV
- ELEC — TU ELECTRIC UNDERGROUND CABLE

NO.	REVISION	BY	DATE

DESIGNED BY: J WALDBAUER
DRAWN BY: EH&A
CHECKED BY: B GRANTHAM
SCALE: 1" = 20'
DATE: DECEMBER, 1993
FILE: \ADDISON\PROJECT3\ADDWEST

Espey, Huston & Associates, Inc.
Engineering & Environmental Consultants
13800 Montfort Drive, Suite 230
Dallas, Texas 75240 (214) 387-0771

PAVING PLAN

INTERSECTION IMPROVEMENTS
ADDISON ROAD AT WESTGROVE DRIVE
for
THE TOWN OF ADDISON

SHEET NO. 5 OF 31 SHEETS
JOB NO. 13921