

MATCH MARK "A" SEE SHEET 5710-01A

22 L.F. 18" Cor. Iron (146a) in boring
 52 L.F. 18" Cor. Iron (146a) in boring

Tie to Pump Sta. Discharge
 at Property Line

Tie to Existing 8" C.I.P.
 on Addison Airport ROAD

2-5" Tee
 1-8" Plug
 1-8" x 2" Red.
 1-2" G.K.

1-8" x 6" Tee
 1-6" G.K.
 2-8" G.V.

1-8" x 6" Tee
 1-8" x 2" Red.
 1-2" G.K.

6" x 6" Cross
 2-8" x 2" Red.
 1-2" G.K.


Scale: 1" = 100'

H.H.F.A. PROJECT NO. PFL-V-4
 SHEET 1A of 4
 ADDISON, TEXAS
 WATER DISTRIBUTION SYSTEM

HOMER A. HUNTER ASSOCIATES
 CONSULTING ENGINEERS
 DALLAS, TEXAS

DESIGNED: E.M.R.	APPROVED: H.A.
---------------------	-------------------

5710-01A REV
 AS B

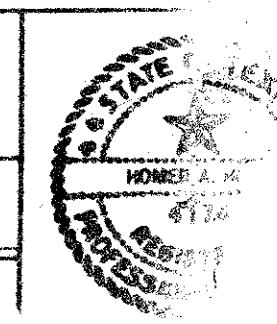

SEE SHEET 5710-01B
 FOR LEGEND

5710-01A REV 11/24/88