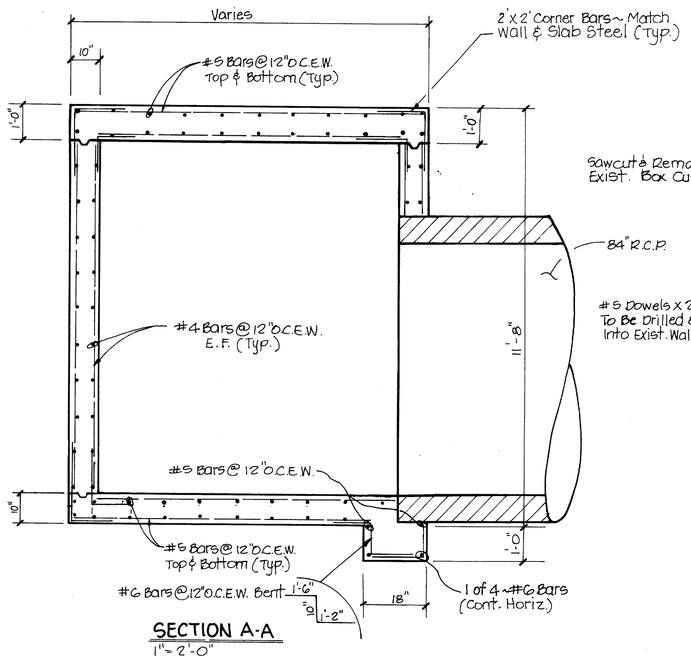

SECTION A-A
1"=2'-0"

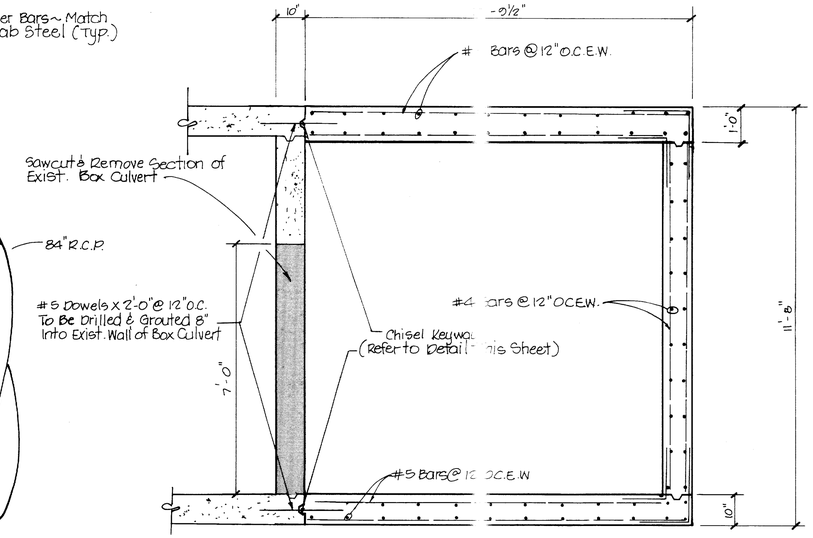

SECTION B-B
1"=2'-0"

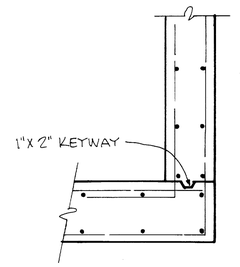

TYPICAL KEYWAY DETAIL
NTS

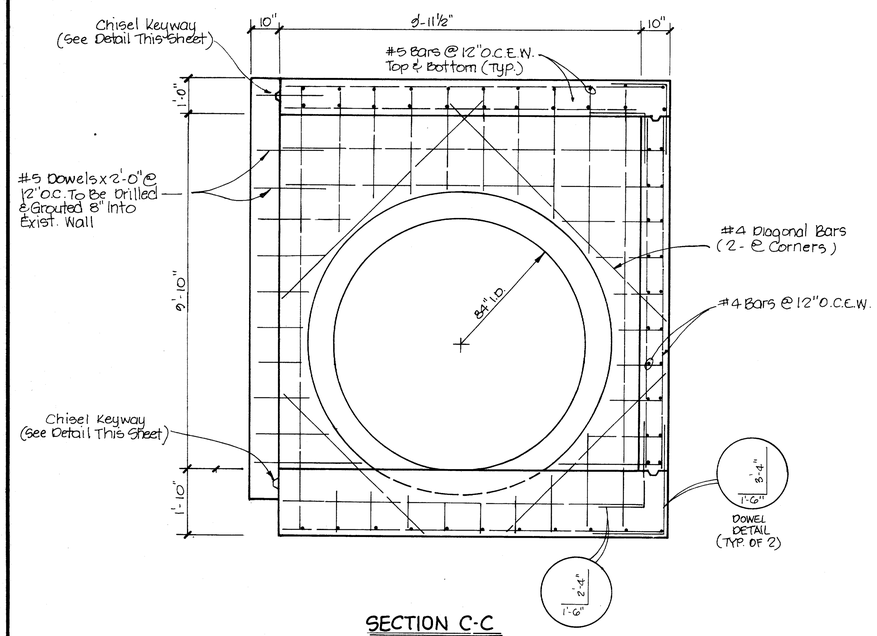

SECTION C-C
1"=2'-0"

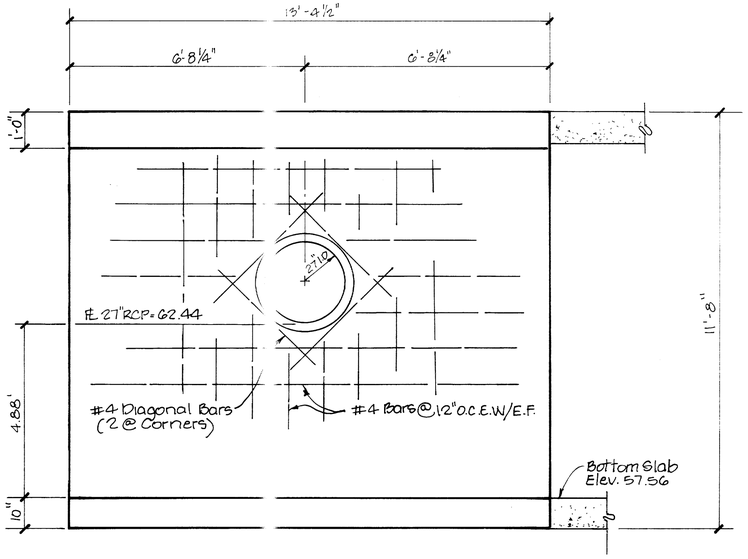

SECTION D-D
1"=2'-0"

AS-BUILTS

I CERTIFY THIS PROJECT WAS CONSTRUCTED IN GENERAL CONFORMANCE WITH THESE CONSTRUCTION PLANS AND WILL FUNCTION AS DESIGNED.

6-4-93

DENOTES CONCRETE REMOVAL

Rev: 6-10-93 Added 27" RCP To Junc. Box

84" RCP JUNCTION BOX DETAILS

KMART NO. 4885

BELTLINE AND MARSH

ADDISON, TEXAS

LAWRENCE A. CATES & ASSOC. CONSULTING ENGINEERS DALLAS, TEXAS

DESIGN	DRAWN	DATE	SCALE	NOTES	FILE	NO.
LAC	LAC	6-4-93	1"=2'-0"		91012	C-17A