


- NOTES:
- Water meters, water mains shall installed by the Contractor, and a part of the General Contract.
 - All water 1 1/2" side of the water furnished and installed by the Plumbing Contractor.
 - Sanitary sewer main, Line "A", including its manholes and taps, shall be installed by the Site Contractor, and are not a part of the General Contract.
 - All sanitary sewer line "building side" of the sewer shall be furnished and installed by the Plumbing Contractor.

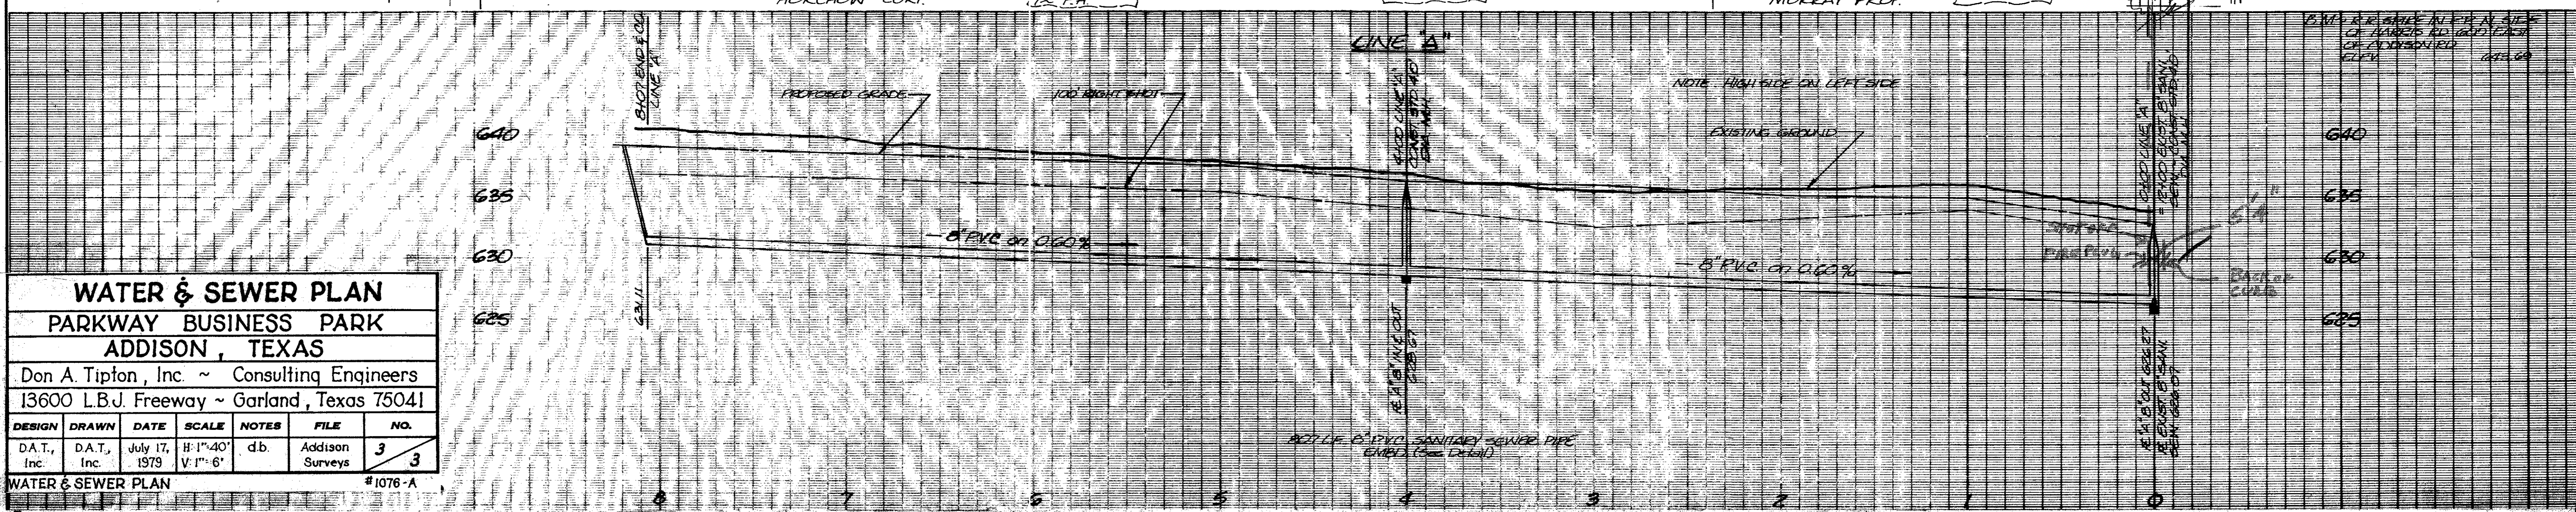

WATER & SEWER PLAN
PARKWAY BUSINESS PARK
ADDISON, TEXAS
 Don A. Tipton, Inc. ~ Consulting Engineers
 13600 L.B.J. Freeway ~ Garland, Texas 75041

DESIGN	DRAWN	DATE	SCALE	NOTES	FILE	NO.
D.A.T., Inc.	D.A.T., Inc.	July 17, 1979	H: 1" = 40' V: 1" = 6'	d.b.	Addison Surveys	3 / 3

WATER & SEWER PLAN #1076-A