


ITEM NO.	DESCRIPTION	UNIT	EST. QTY.	
ROADWAY IMPROVEMENTS				
101	MOBILIZATION	L.S.	1	
102	PREPARE RIGHT-OF-WAY	L.S.	1	
103	FULL DEPTH SAWCUT EXISTING PAVEMENT	L.F.	755	△
104	REMOVE AND DISPOSE OF EXISTING PAVEMENT, INCLUDING CURB	S.Y.	1,650	△
105	UNCLASSIFIED STREET EXCAVATION	C.Y.	500	△
106	EMBANKMENT	C.Y.	100	
107	10" THICK REINFORCED CONCRETE PAVEMENT, 4000 PSI @ 28 DAYS	S.Y.	2,800	△
108	FURNISH, INSTALL 10' RECESSED CURB INLET	EA	2	
109	CLASS III 18" RCP STORM DRAIN PIPE, INCLUDING FITTINGS	L.F.	108	△
110	REMOVE AND RELOCATE ROADSIDE SIGN	EA.	0	△
111	15 MPH SPEED LIMIT SIGN (R2-1)	EA.	2	△
112	FIRE LANE STRIPING	L.F.	1,100	△
113	SOLID SODDING	S.Y.	900	△
114	FURNISH, INSTALL, MAINTAIN AND REMOVE SILT FENCE	L.F.	300	
115	INLET PROTECTION (DROP)	EA	2	
116	IRRIGATION CONDUIT, 4" SCH 40 PVC	L.F.	114	△
117	FURNISH, INSTALL, SECURITY GATE WITH ACCESS CONTROL PANEL	LS	1	
118	AOA SECURITY FENCE	LF	300	△
119	REMOVE AND DISPOSE OF TEMPORARY ROAD	LS	1	△
120	REMOVE AND DISPOSE OF SECURITY FENCE	LF	195	△
121	CLASS III 12" RCP STORM DRAIN PIPE	LF	95	△
122	FURNISH, INSTALL MAINTAIN AND REMOVE 20-FT SECURITY GATE	EA	1	△
123	CONDUIT, 2" SCH 40 PVC	LF	600	△
124	FOUNDATION, 30' STREET LIGHT POLE	EA	4	△
125	GROUND MOUNTED PULL BOX, TYPE A	EA	3	△
126	CABLE INSULATED, #8 AWG	LF	660	△
127	CABLE, BARE #8 AWG	LF	330	△

19-OCT-2003 21:07
 H:\39020\Road\Sheets\opq01.dgn

NO.	DATE	REVISION	APPROV.	NO.	DATE	REVISION	APPROV.
1	10/10/03	ADDED LINE ITEMS, MODIFIED QUANTITIES	JSN				

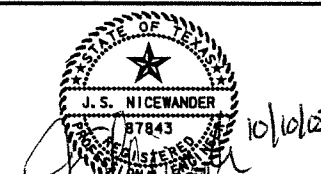

HNTB ARCHITECTS ENGINEERS PLANNERS
The HNTB Companies

DESIGN CHECK	JSN	PROJECT NO.	39020
	JDH		
DRAWN CHECK	GFS		
	JSN		
DATE	SEPTEMBER 2003		
SCALE			



TOWN OF ADDISON		SHEET
AIRPORT PARKWAY REALIGNMENT		
QUANTITIES		
TOWN OF ADDISON TEXAS		0-1