


BUILDING LEGEND

#	TENANT OR OWNER	TOP ELEVATION	#	TENANT OR OWNER	TOP ELEVATION	#	TENANT OR OWNER	TOP ELEVATION	#	TENANT OR OWNER	TOP ELEVATION	#	TENANT OR OWNER	TOP ELEVATION	#	TENANT OR OWNER	TOP ELEVATION

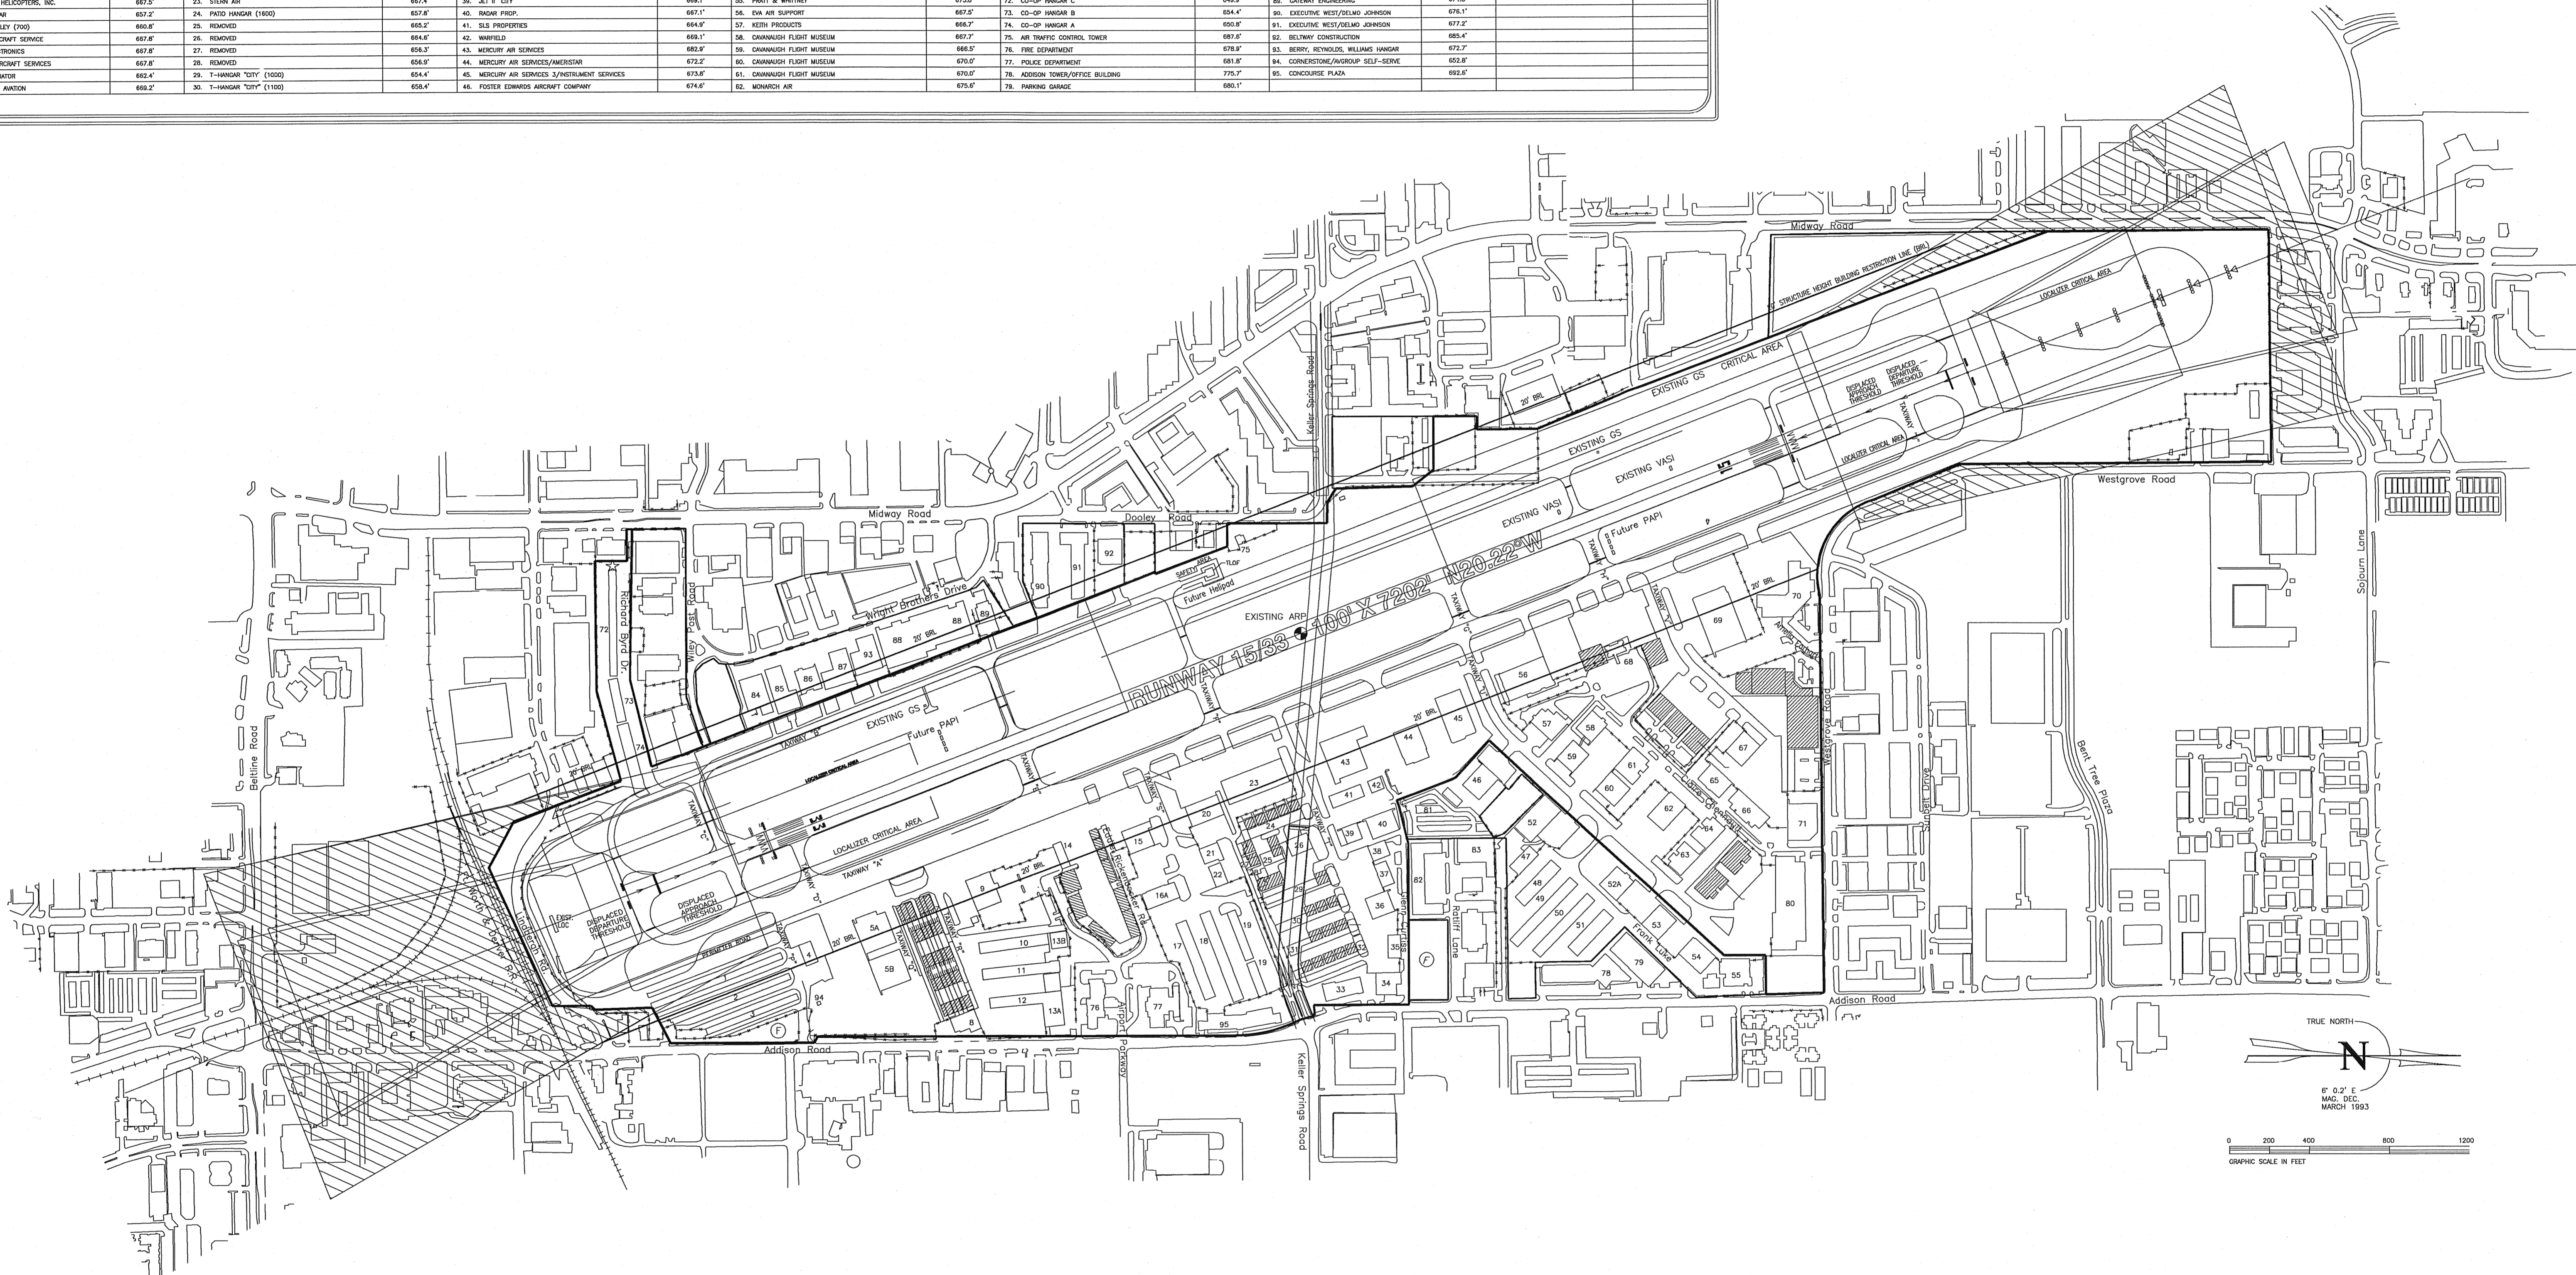


ADDISON AIRPORT
ADDISON, TEXAS

AIRPORT LAYOUT PLAN


ADDISON AIRPORT PLAN (PARCELS)

BUILDING LEGEND

#	TENANT OR OWNER	TOP ELEVATION	#	TENANT OR OWNER	TOP ELEVATION	#	TENANT OR OWNER	TOP ELEVATION	#	TENANT OR OWNER	TOP ELEVATION	#	TENANT OR OWNER	TOP ELEVATION

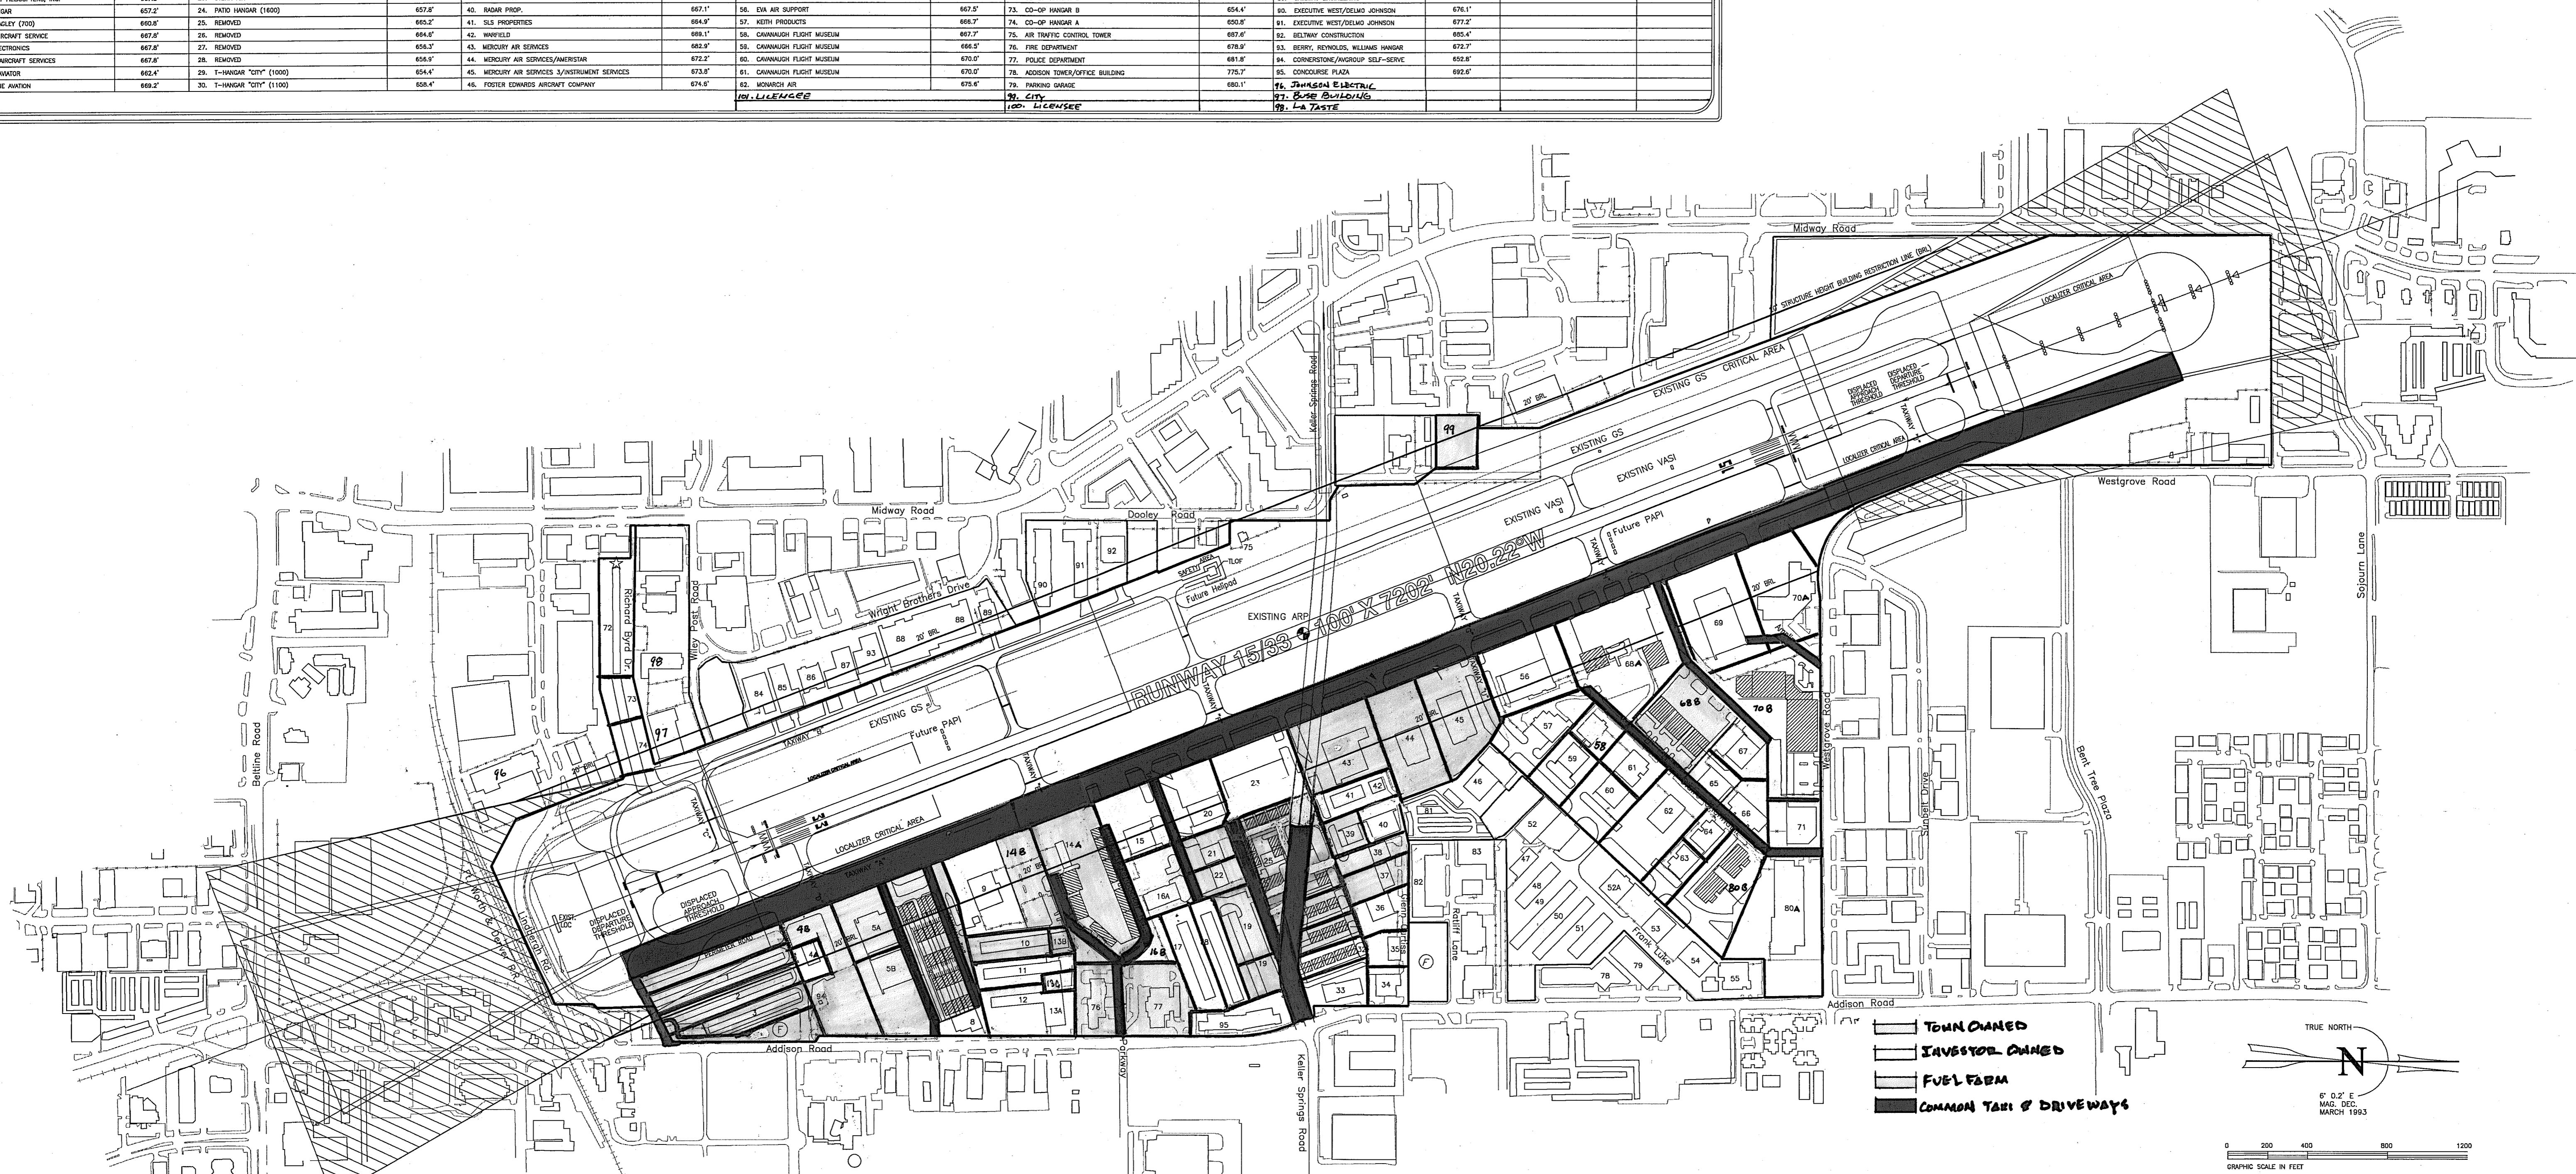

[White Box] TOWN OWNED
 [Light Gray Box] INVESTOR OWNED
 [Dark Gray Box] FUEL FARM
 [Black Box] COMMON TAXI & DRIVEWAYS

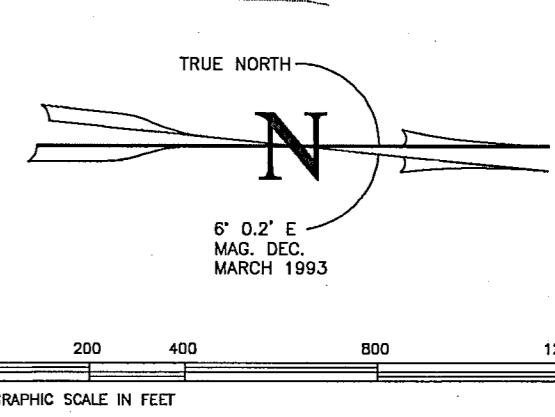

ADDISON AIRPORT
ADDISON, TEXAS

AIRPORT LAYOUT PLAN

WISBOS