



BUILDING LEGEND

#	TENANT OR OWNER	TOP ELEVATION	#	TENANT OR OWNER	TOP ELEVATION	#	TENANT OR OWNER	TOP ELEVATION	#	TENANT OR OWNER	TOP ELEVATION	#	TENANT OR OWNER	TOP ELEVATION

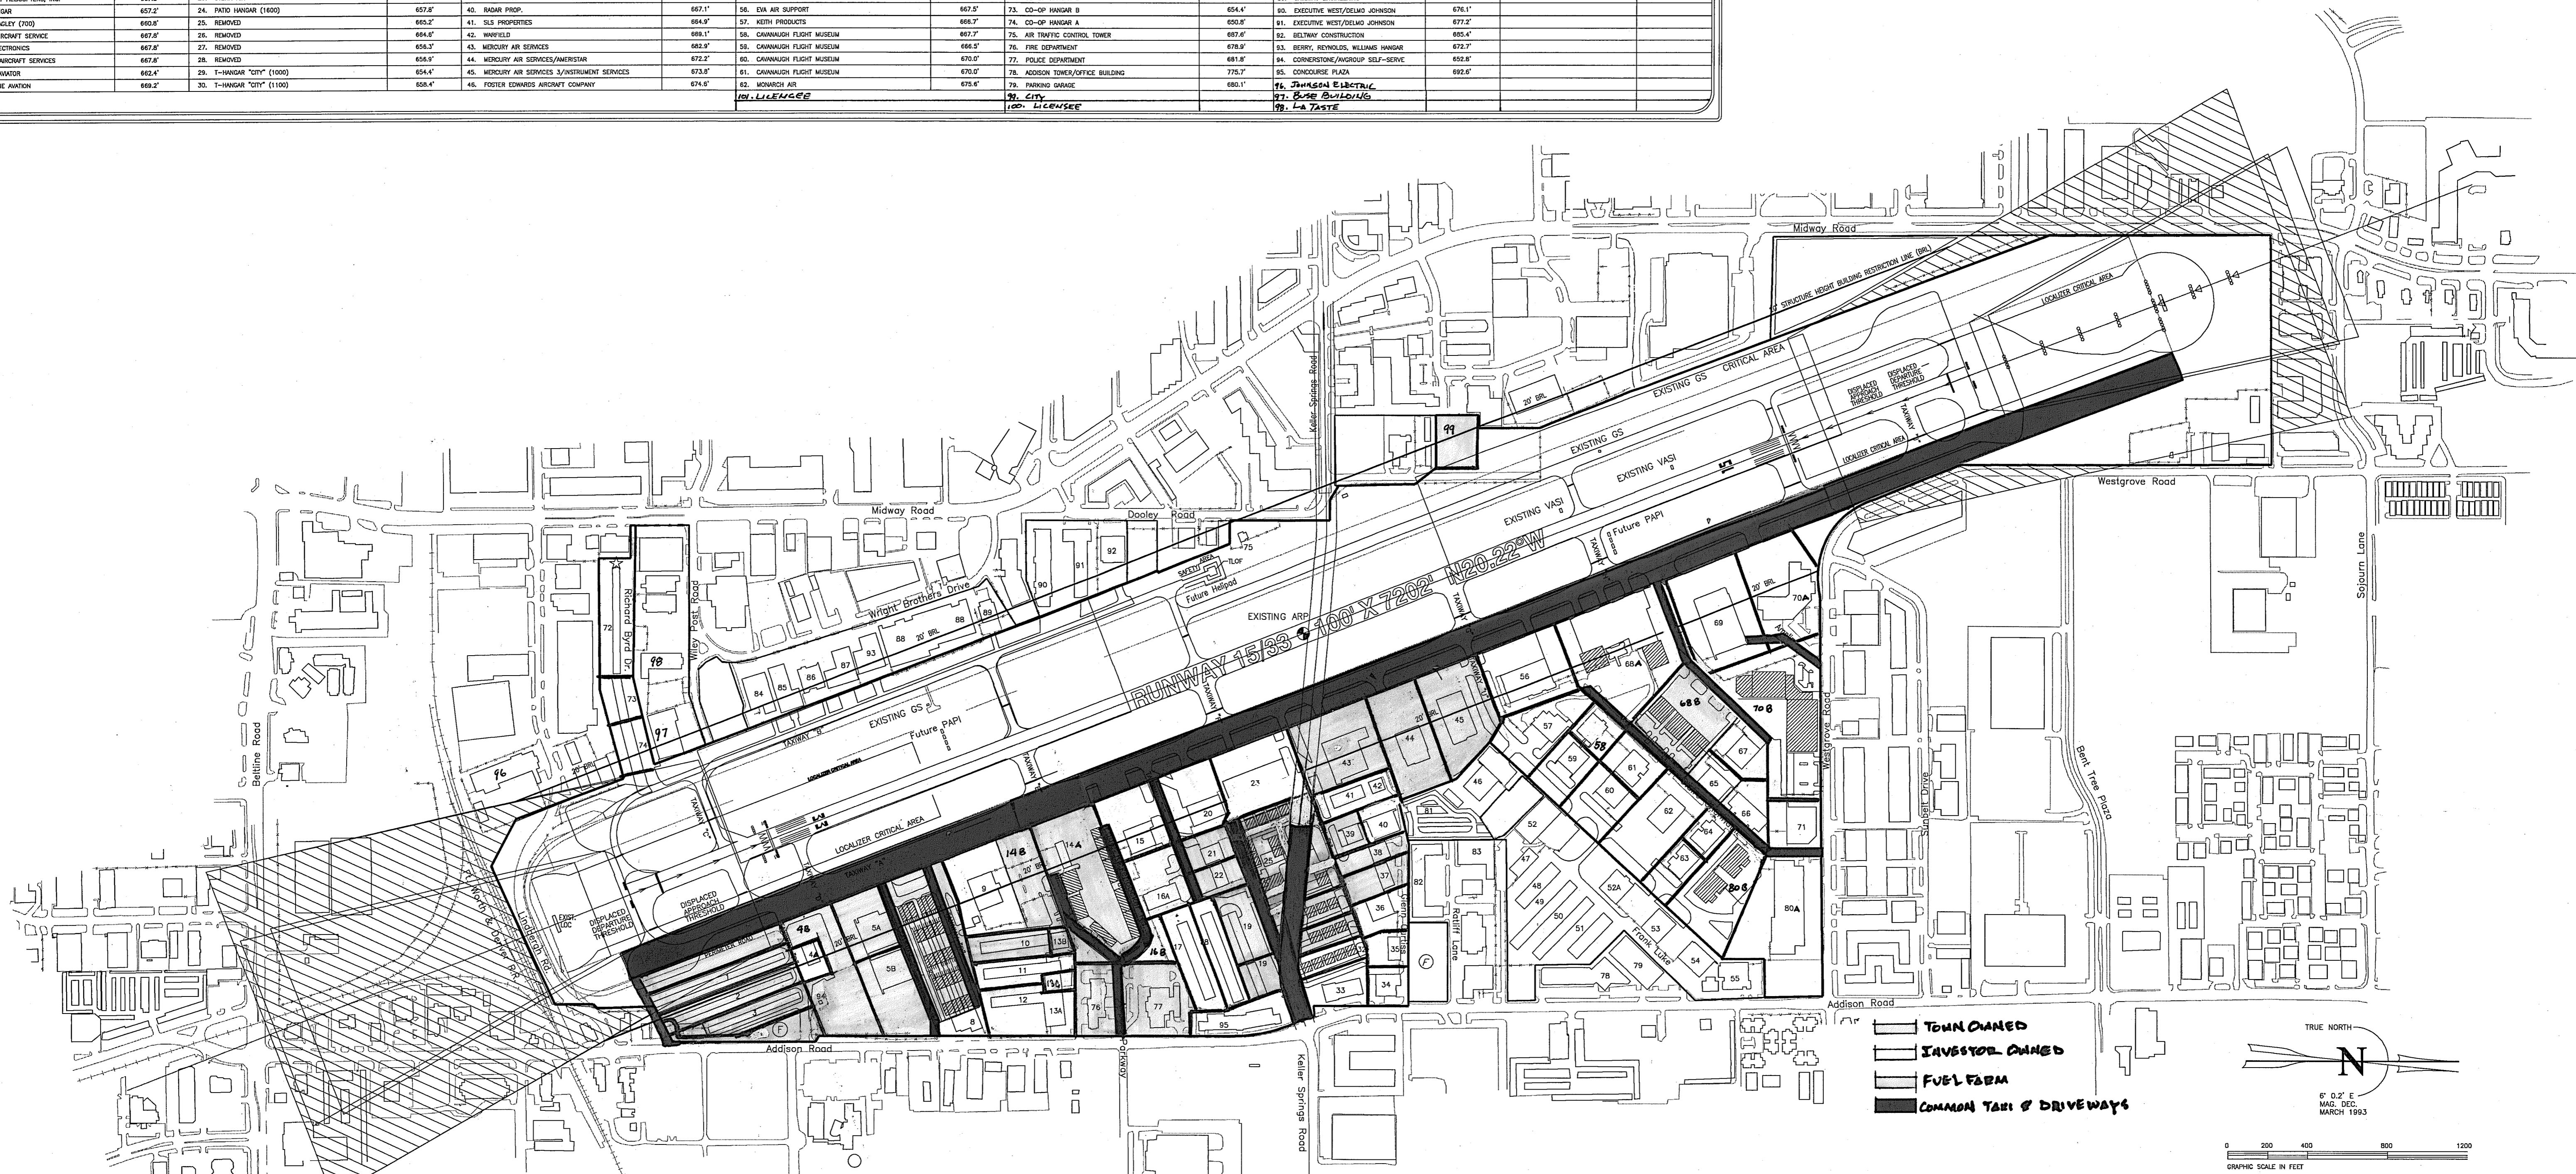

———— TOWN OWNED
 ———— INVESTOR OWNED
 ———— COMMON TAXI & DRIVEWAYS

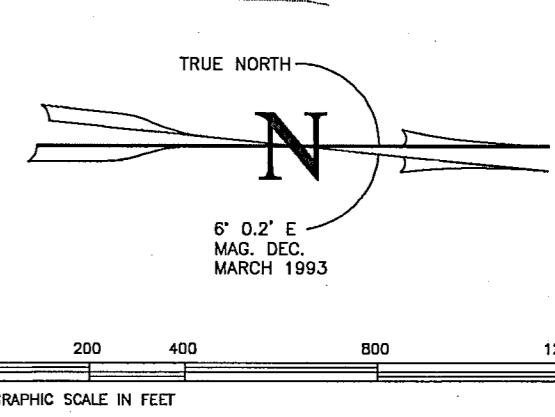

ADDISON AIRPORT
ADDISON, TEXAS

AIRPORT LAYOUT PLAN

WISBOS