REVISIONS	BY
GEN REVISIONS PER CITY 10-31-84	RS

REGISTERED ARCHITECT STATE OF TEXAS
REG. NO. 4416

ROGER SMITH AIA
ARCHITECT
3306 WILEY POST DR.
CARROLLTON, TEXAS, 75006
387-4701

A HANGAR AND OFFICE BUILDING FOR REDMAN INVESTMENTS

CLAIRE CHENNAULT DRIVE ADDISON AIRPORT,
ADDISON, TEXAS

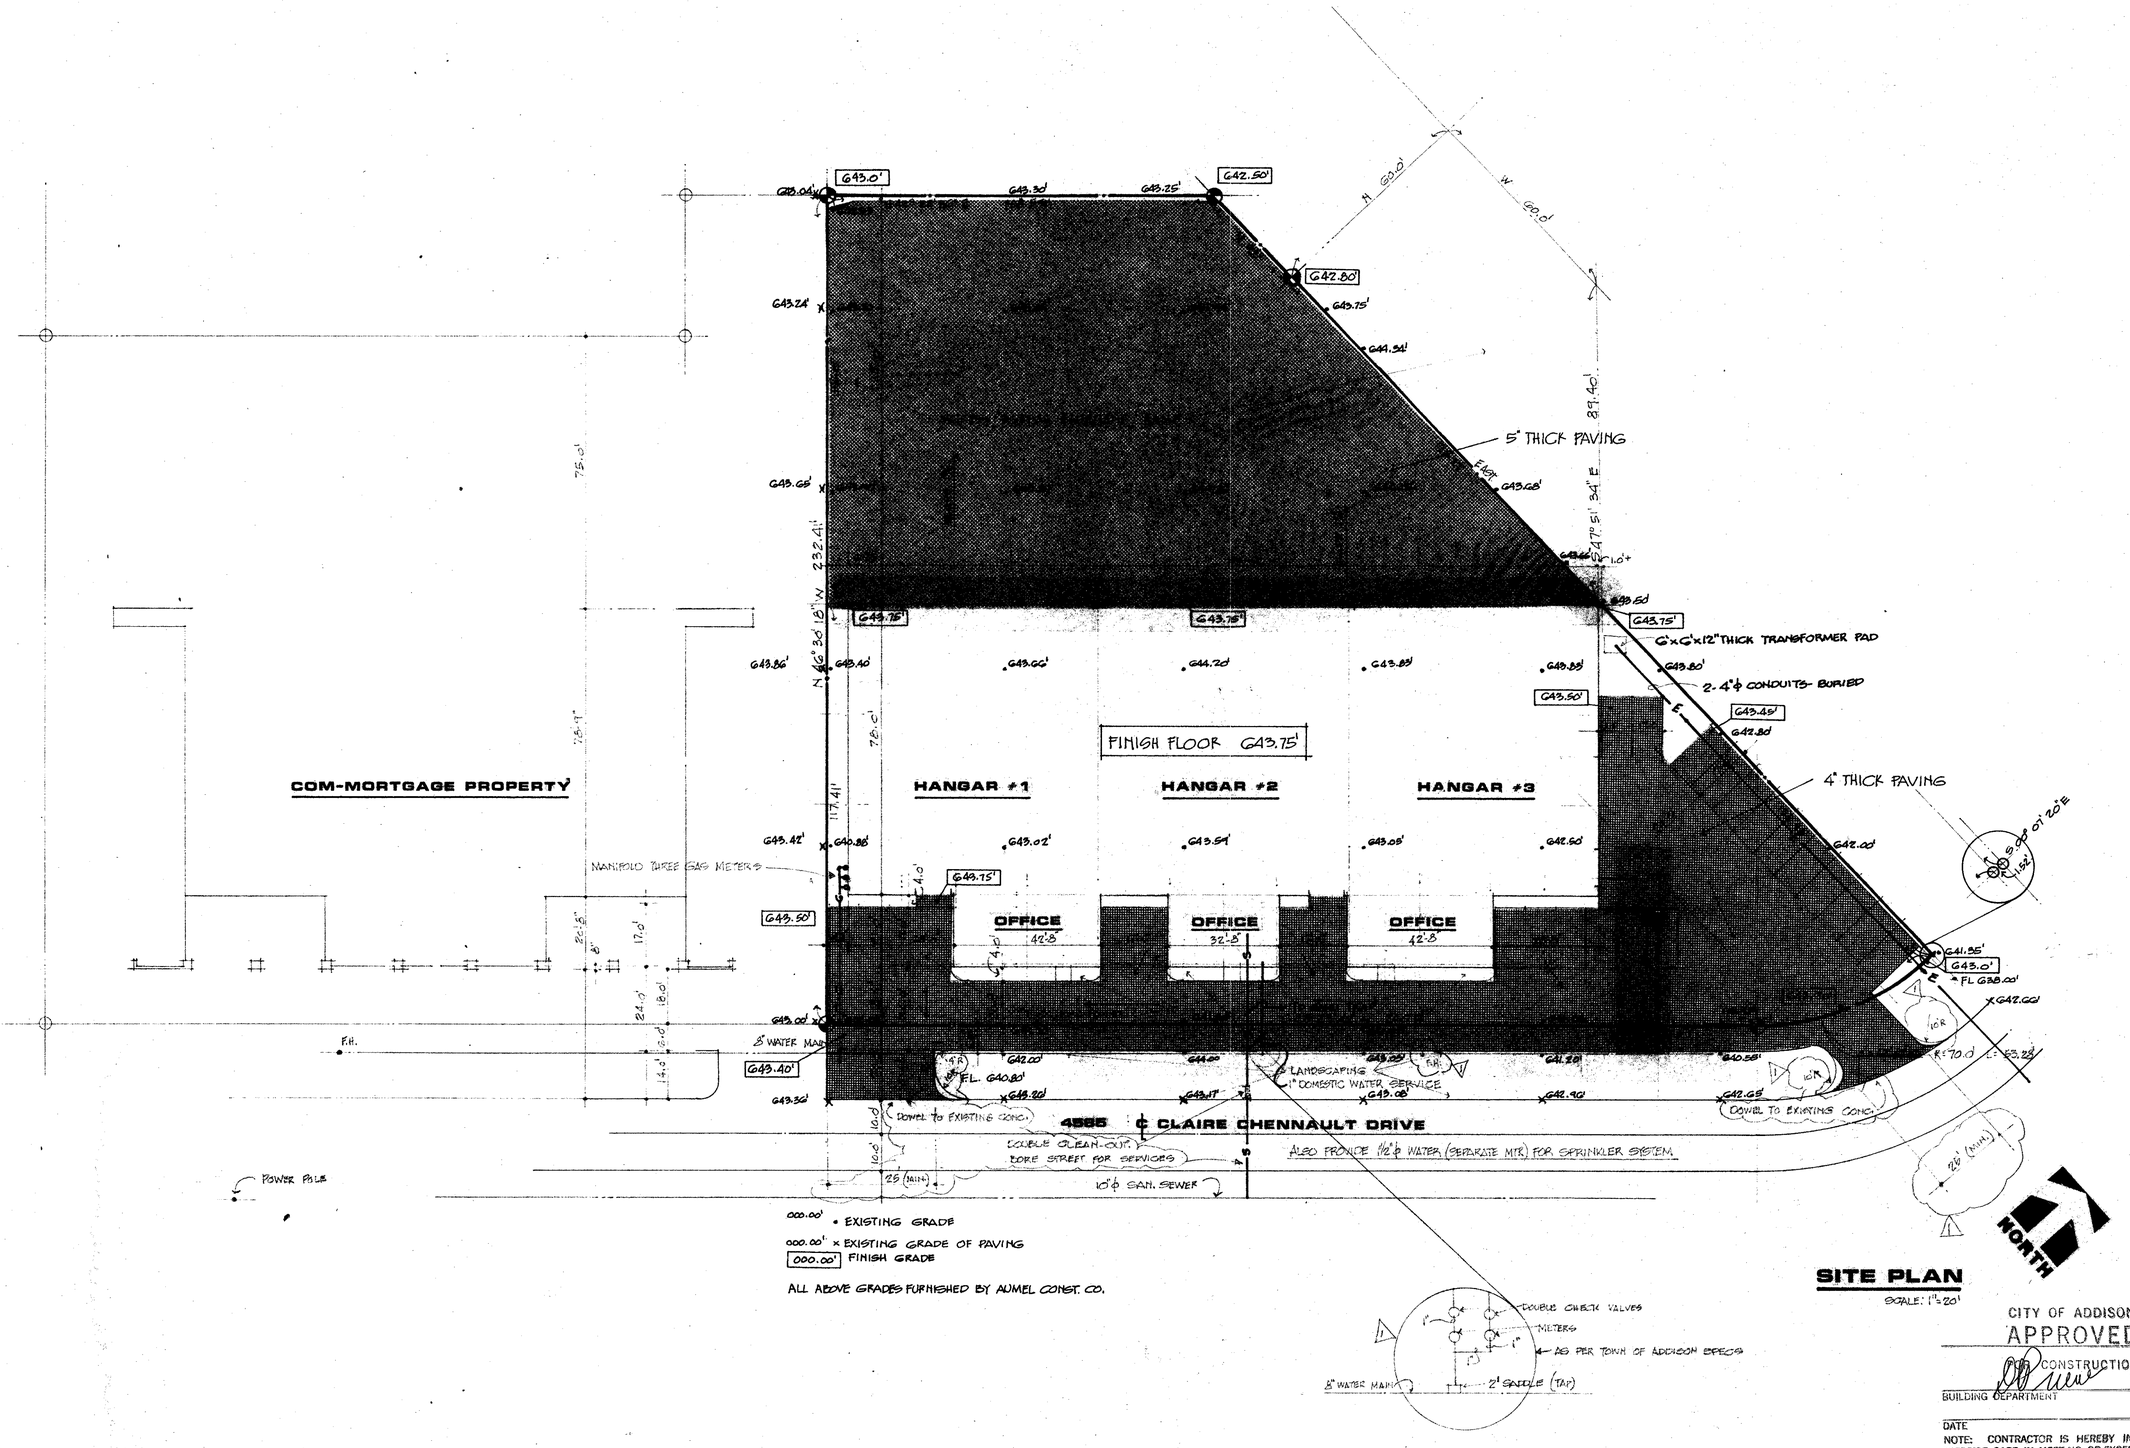

000.00' • EXISTING GRADE

000.00' × EXISTING GRADE OF PAVING

[000.00'] FINISH GRADE

ALL ABOVE GRADES FURNISHED BY ADMEL CONST. CO.

SITE PLAN

SCALE: 1"=20'

CITY OF ADDISON
APPROVED
CONSTRUCTION
BUILDING DEPARTMENT
DATE

NOTE: CONTRACTOR IS HEREBY INSTRUCTED TO EXERCISE CARE IN MEETING OR EXCEEDING ALL REQUIREMENTS OF BOTH NATIONAL AND LOCAL CODES AND/OR ORDINANCES APPLICABLE TO HIS WORK. APPROVAL OF THESE DRAWINGS SHALL NOT BE CONSTRUED TO RELIEVE RESPONSIBILITY OR IMPLY COMPLIANCE TO SUCH CODES.

THIS SHEET SUPERCEDES SHEET DATED 7-31-84

DRAWN	
CHECKED	
DATE	10-20-84
SCALE	
JOB NO.	8407
SHEET	2
OF	SHEETS