

HARDY McCULLAH / MLM ARCHITECTS, INC.
 DALLAS, TEXAS 75201
 FORT WORTH, TEXAS 76102
 972-385-1000
 817-577-1270

NO.	DATE	DESCRIPTION
1	8-12-87	PER CITY REVIEW


© Copyright 1987 by Hardy McCullah/MLM Architects, Inc.
 Any reproduction or transmission of this document without the written consent of Hardy McCullah/MLM Architects, Inc. is prohibited.

REGISTERED ARCHITECT
 STATE OF TEXAS
 CONSULTANT








A PROJECT FOR
MISSION CO.
 AT ADDISON AIRPORT
 CLAIRE CHENNAULT RD.

SHEET TITLE
SITE DETAILS

JOB NUMBER
209706
 SHEET NUMBER
A-1.1
 DATE OF ORIGINAL ISSUE
 JULY 31, 1987

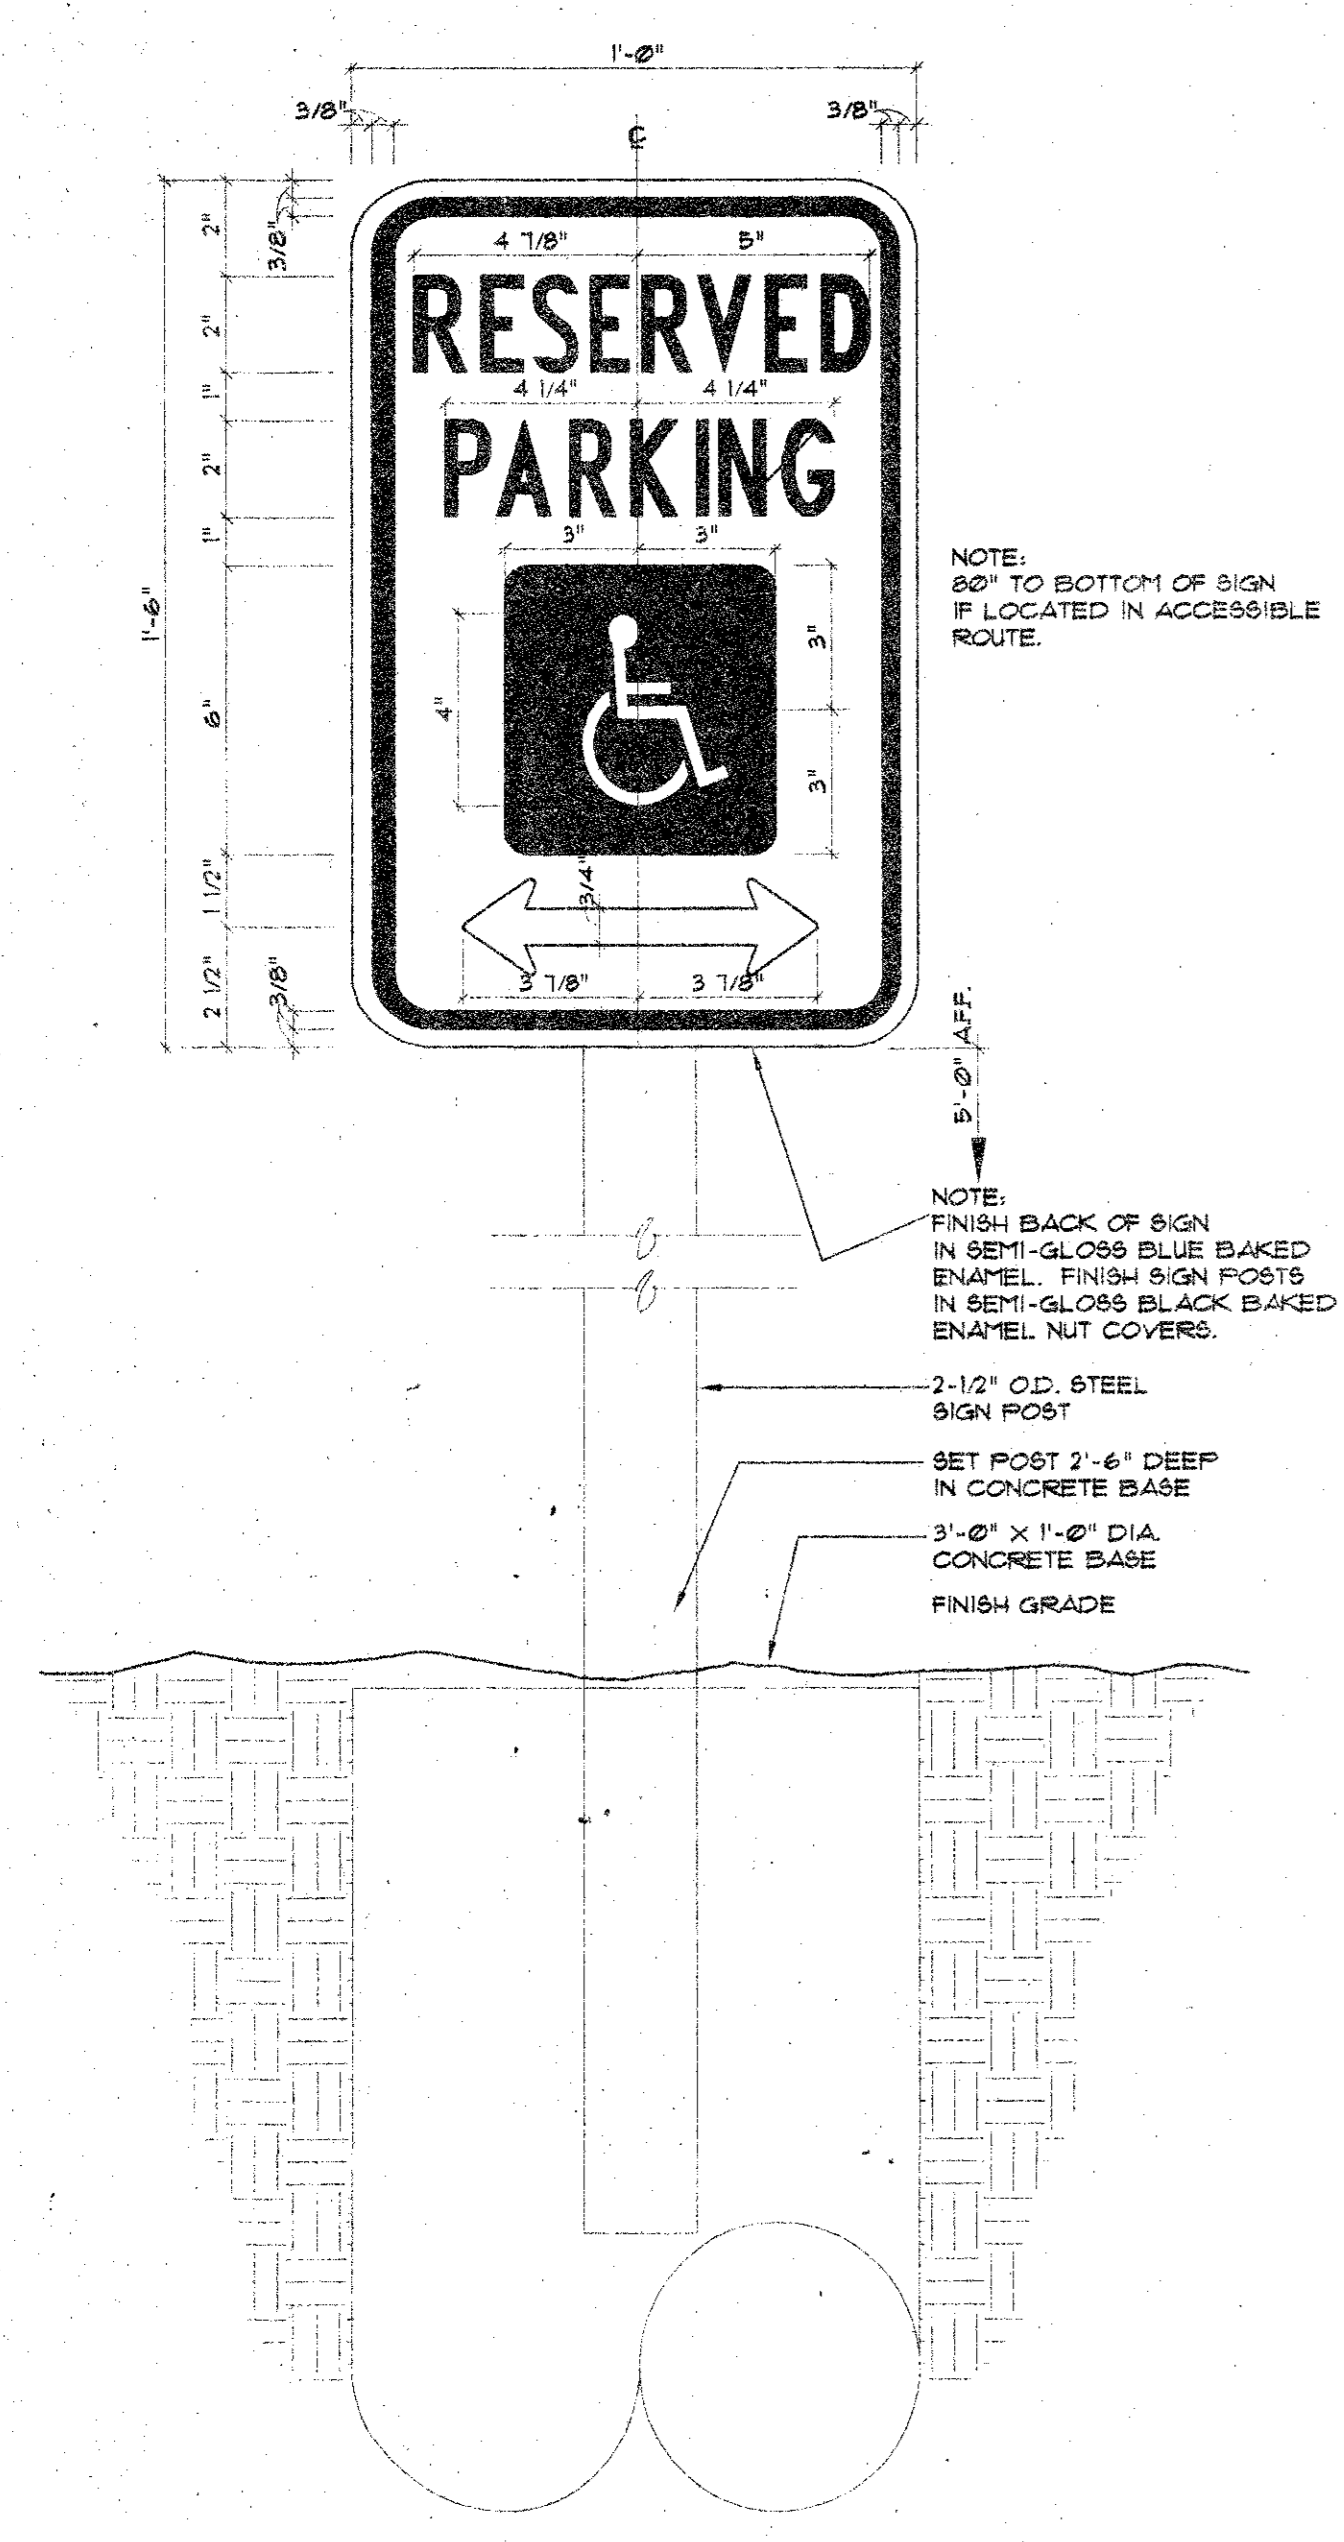

2 H.C. PARKING SIGN
 SCALE: 3" = 1'-0"

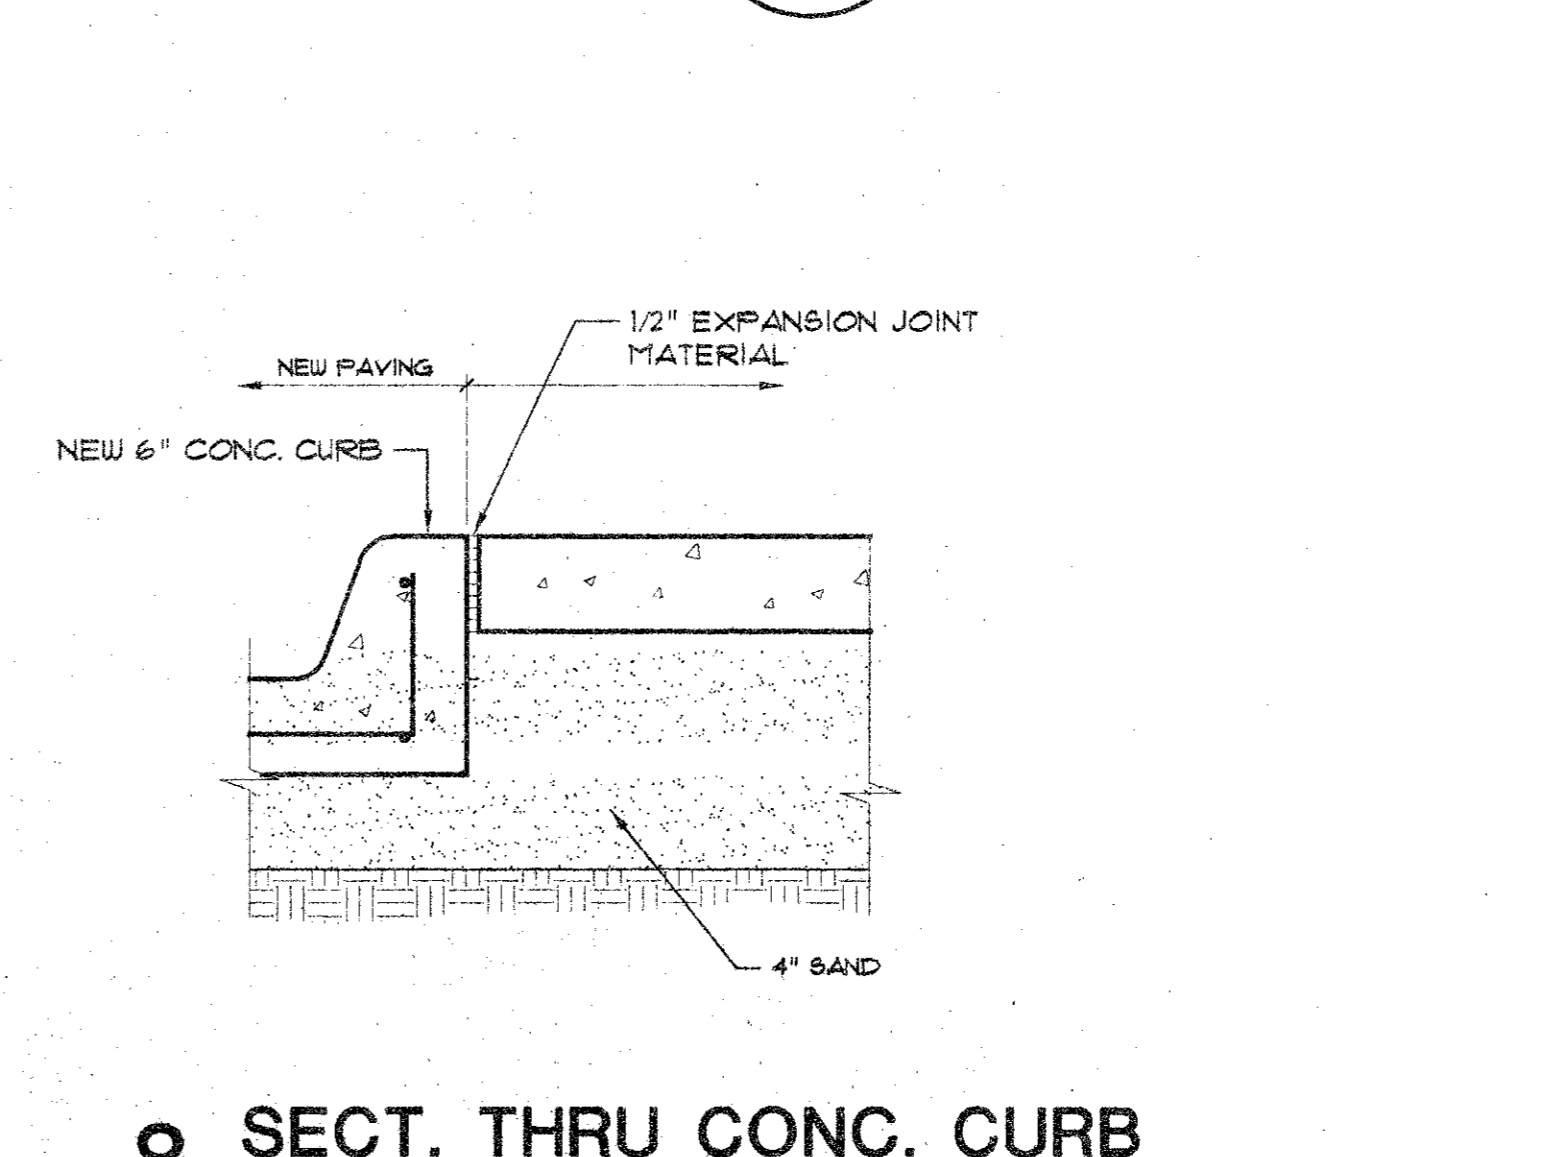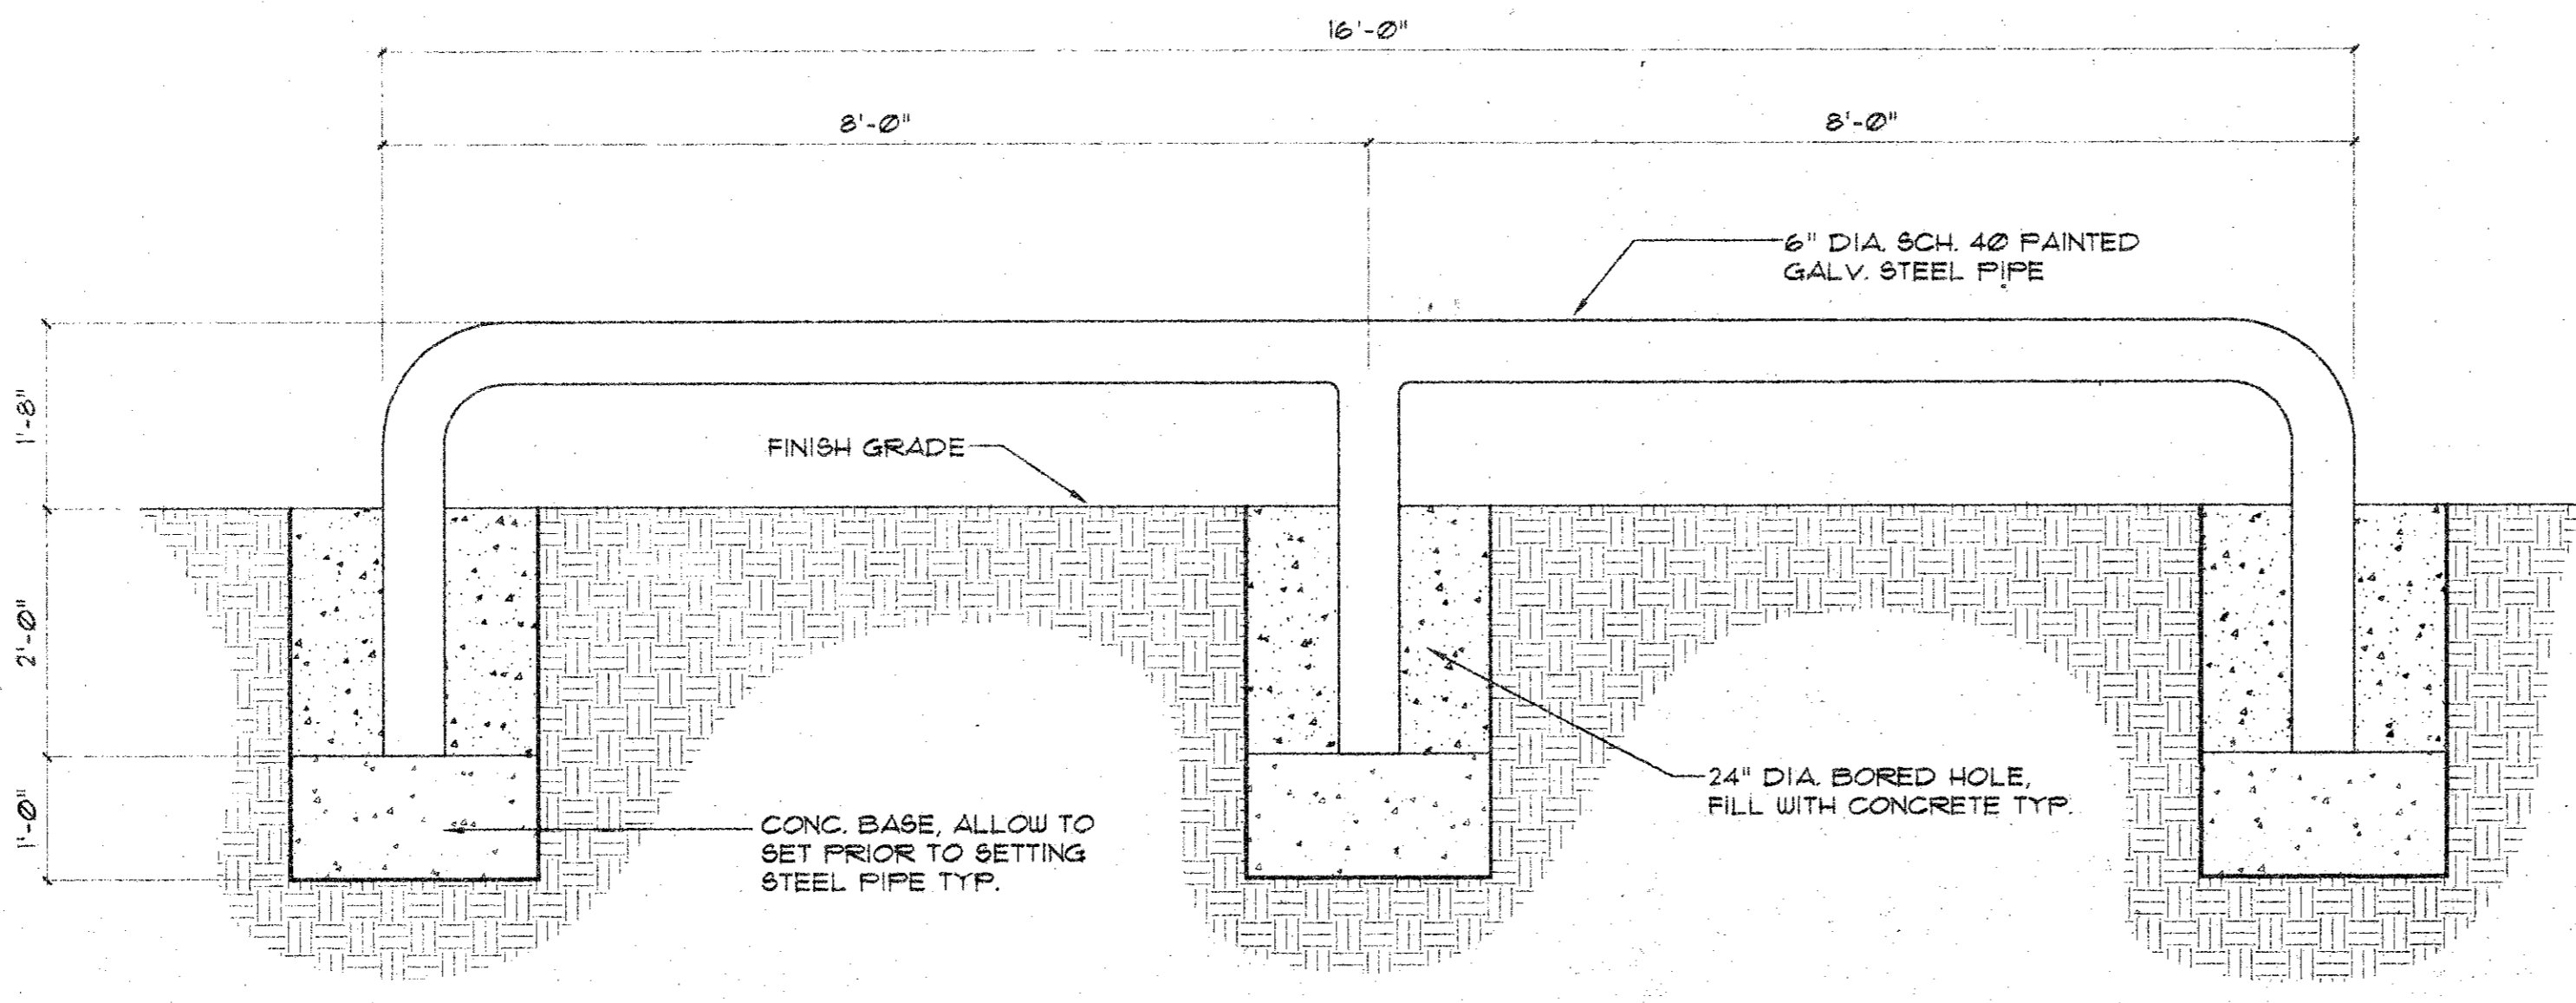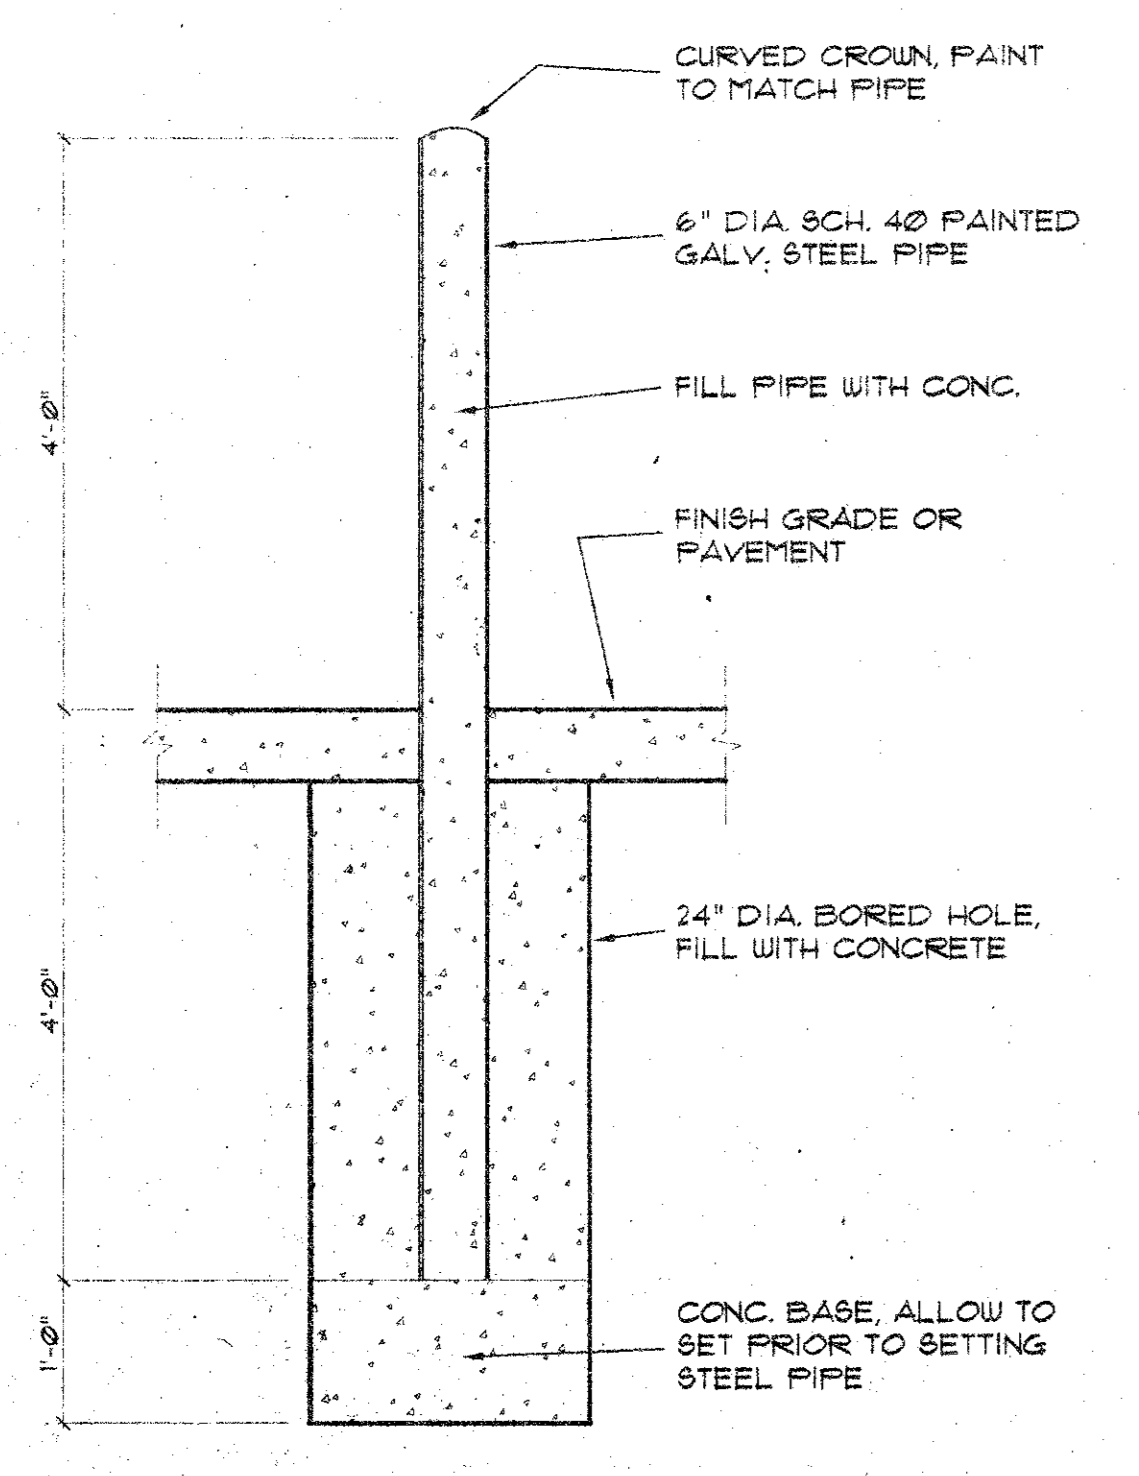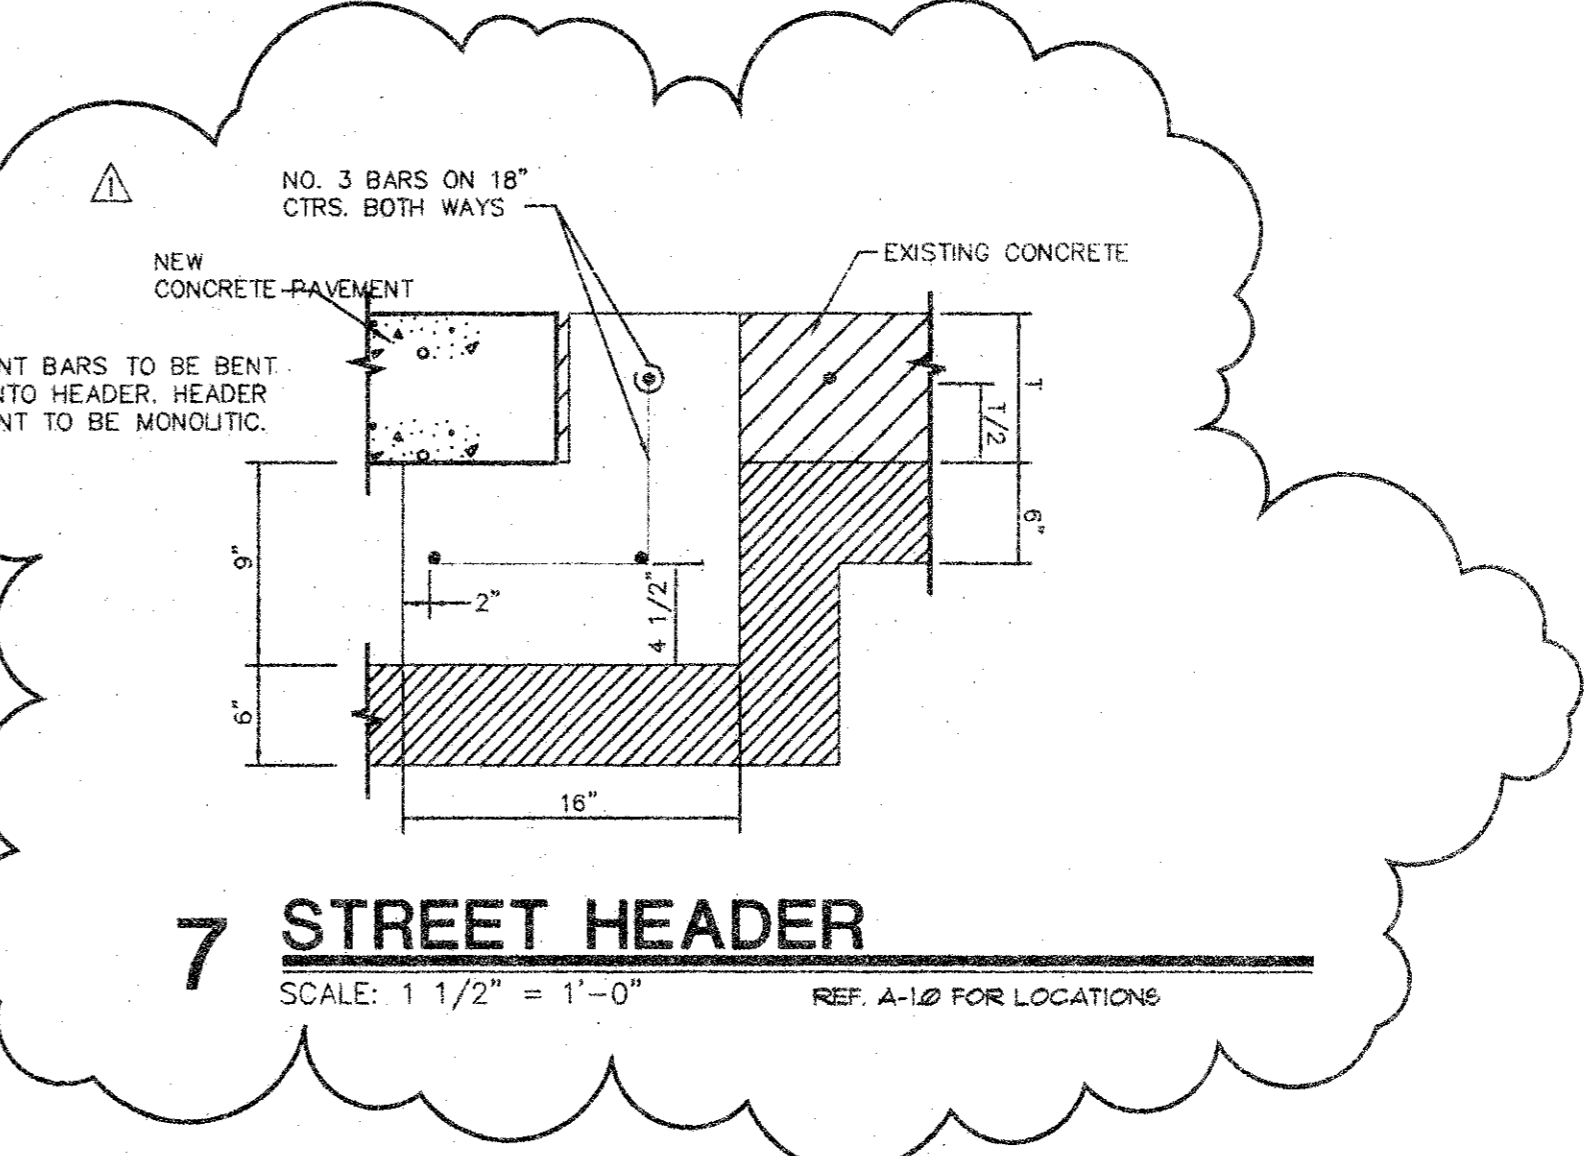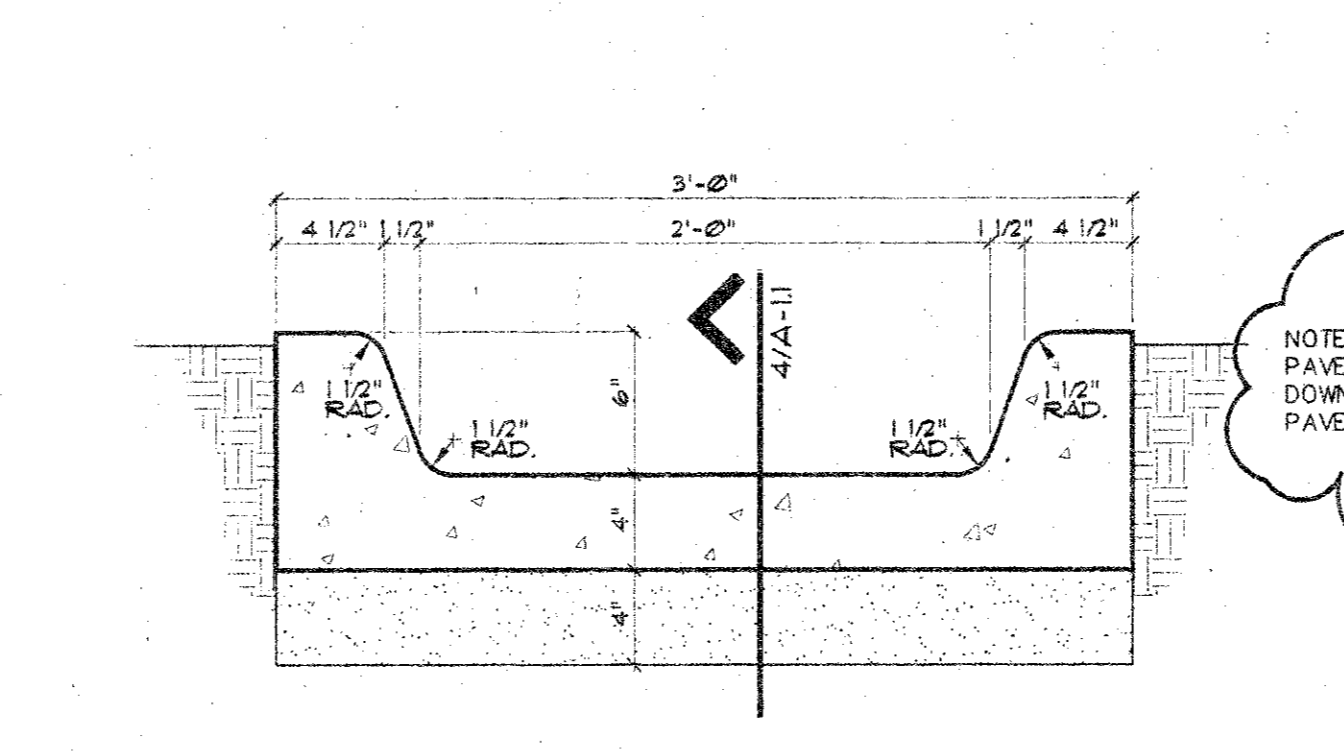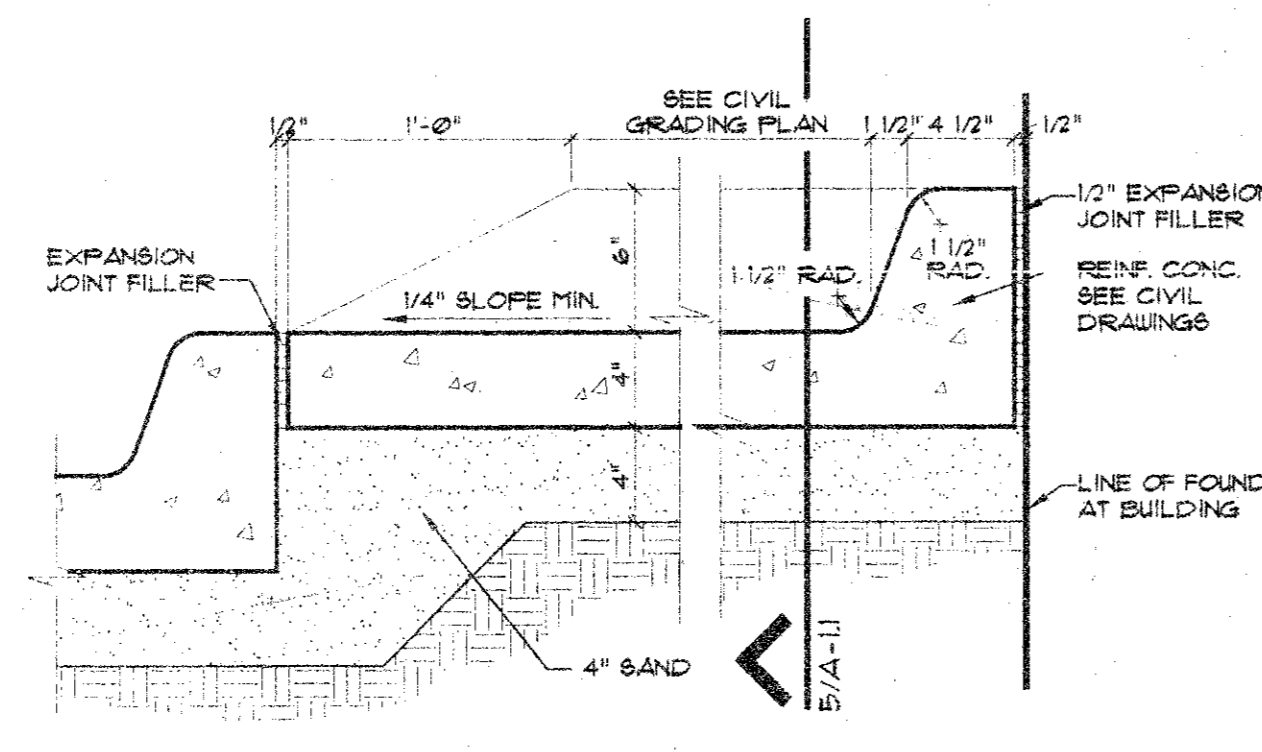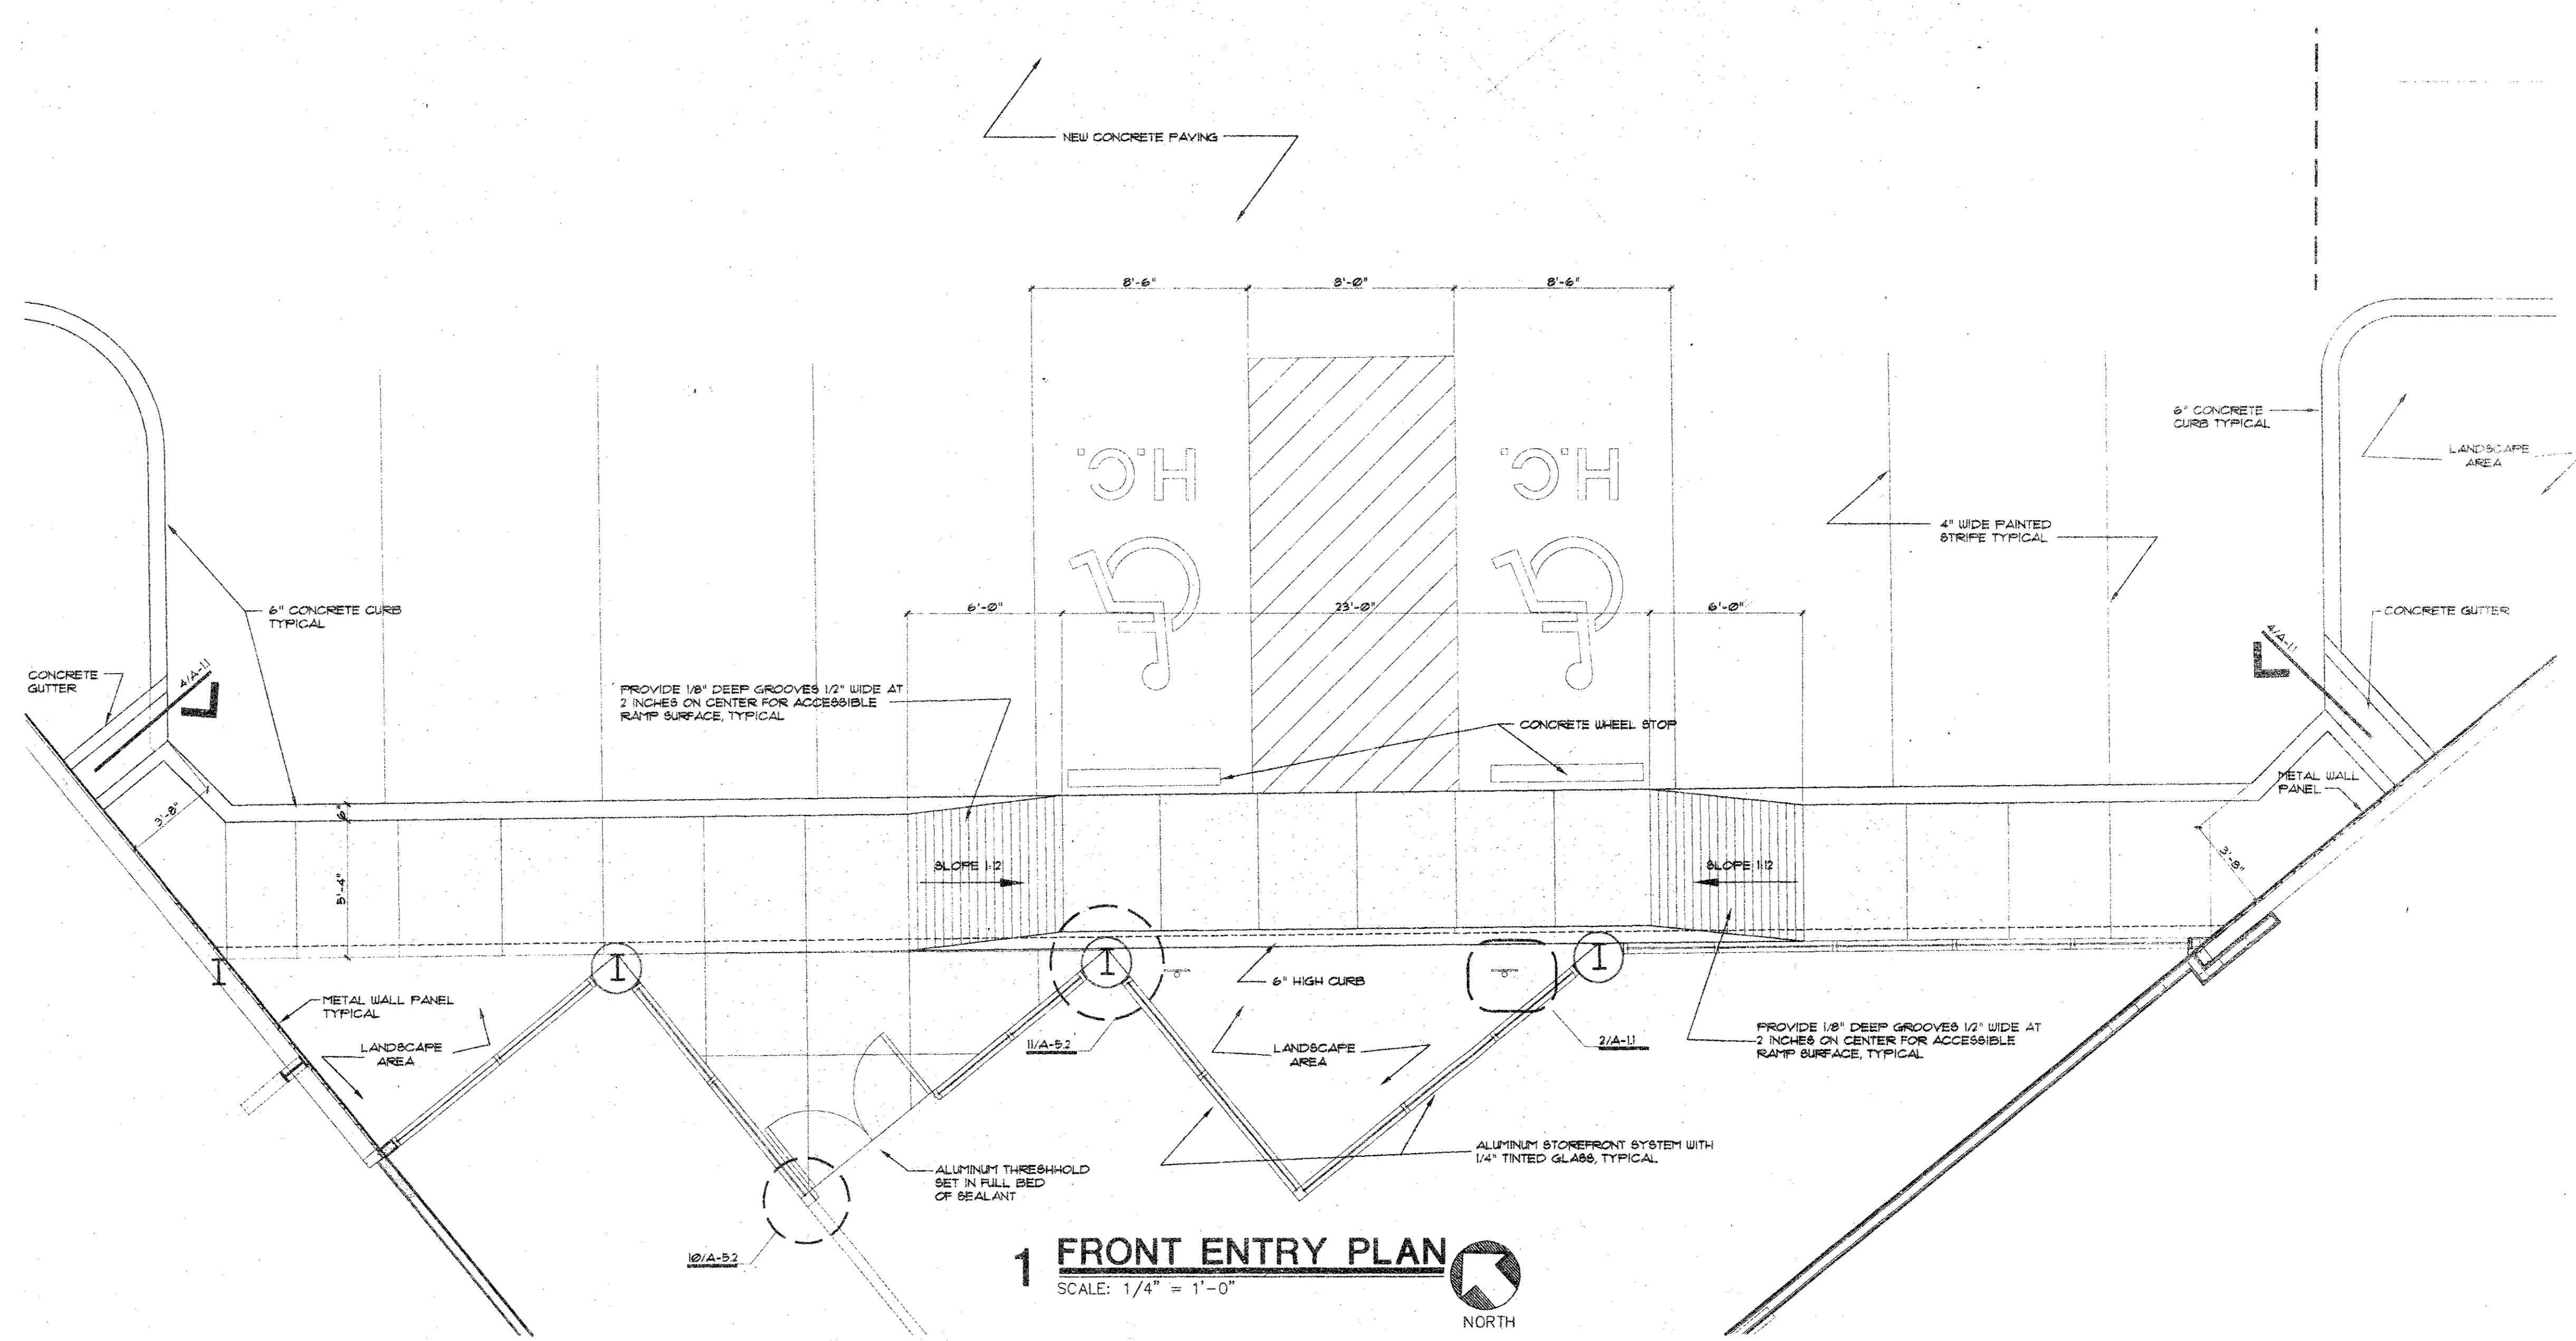

DRAWING REVIEW
 DRAFTSMAN: [Signature]
 PROJECT ARCHITECT:
 DESIGN ARCHITECT:
 PRODUCTION MGR.:
 CHIEF ARCHITECT:
 SCALE: 1=1