


AIRPORT LAYOUT PLANS FOR ADDISON AIRPORT ADDISON, TEXAS

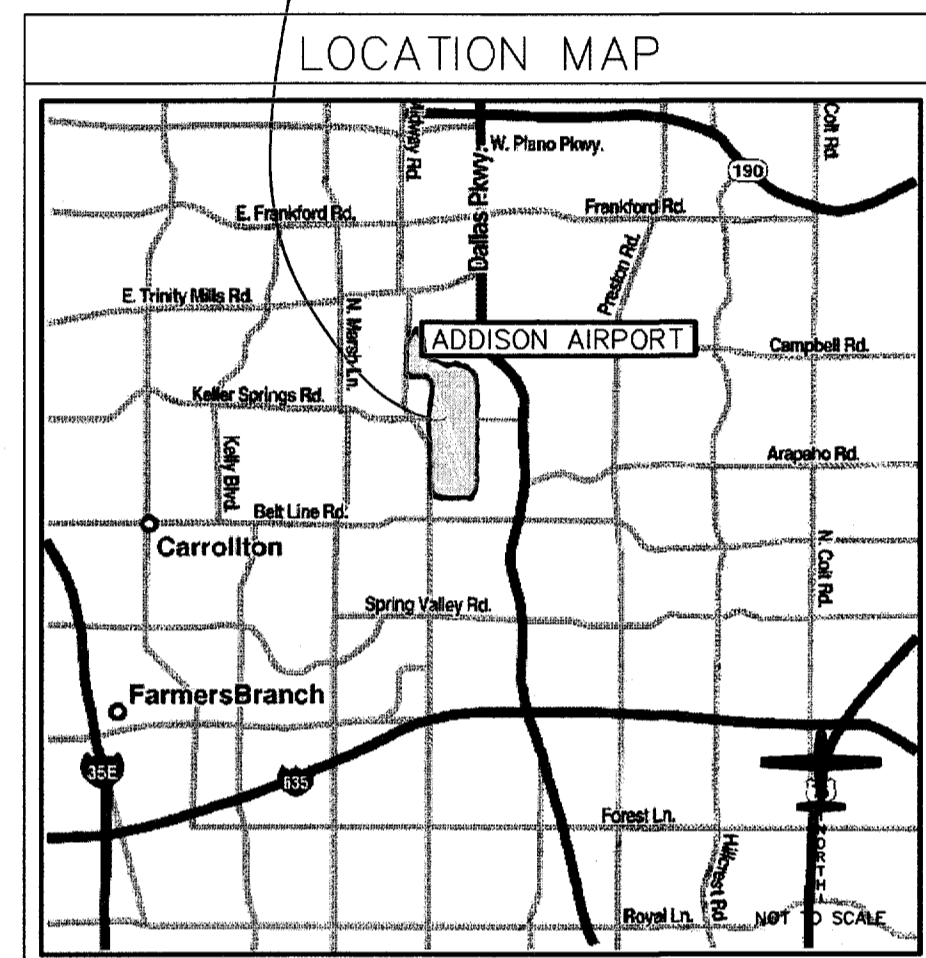


*Heavy up outline
to Airport*

*DRAFT
7/04*

ALL WEATHER WIND COVERAGE			
Runways	10.5 Knots	13 Knots	16 Knots
Runway 15-33	95.60%	98.16%	99.55%


SOURCE:
NOAA National Climatic Center
Asheville, North Carolina
Dallas/Fort Worth International Airport
Dallas, Texas
OBSERVATIONS:
85,043 All Weather Observations
1988-1997

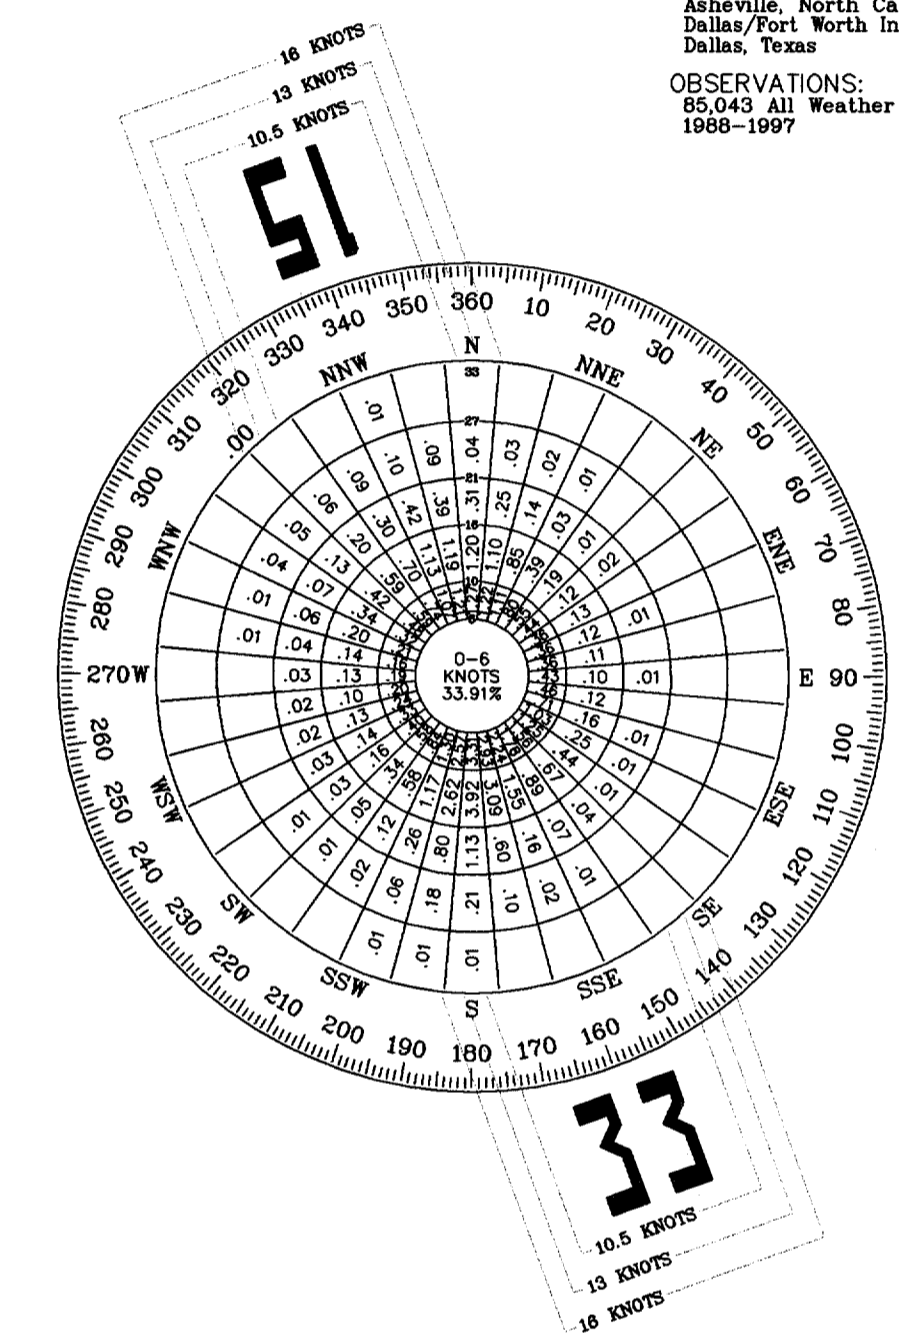

Magnetic Declination
4° 27' East (May 2004)
Annual Rate of Change
6.27' West (May 2004)

Prepared for the Town of Addison, Texas INDEX OF DRAWINGS

1. COVER
2. AIRPORT LAYOUT DRAWING
3. AIRSPACE DRAWING I
4. AIRSPACE DRAWING II
5. AIRSPACE DRAWING III
6. AIRSPACE DRAWING RUNWAY 15 PROFILE I
7. AIRSPACE DRAWING RUNWAY 15 PROFILE II
8. AIRSPACE DRAWING RUNWAY 33 PROFILE I
9. AIRSPACE DRAWING RUNWAY 33 PROFILE II
10. INNER PORTION OF APPROACH SURFACE DRAWING EXISTING RUNWAY 15
11. ULTIMATE INNER PORTION OF RUNWAY 15 APPROACH SURFACE DRAWING
12. INNER PORTION OF APPROACH SURFACE DRAWING EXISTING/ULTIMATE RUNWAY 33
13. TERMINAL AREA DRAWING
14. AIRPORT LAND USE DRAWING
15. AIRPORT PROPERTY MAP

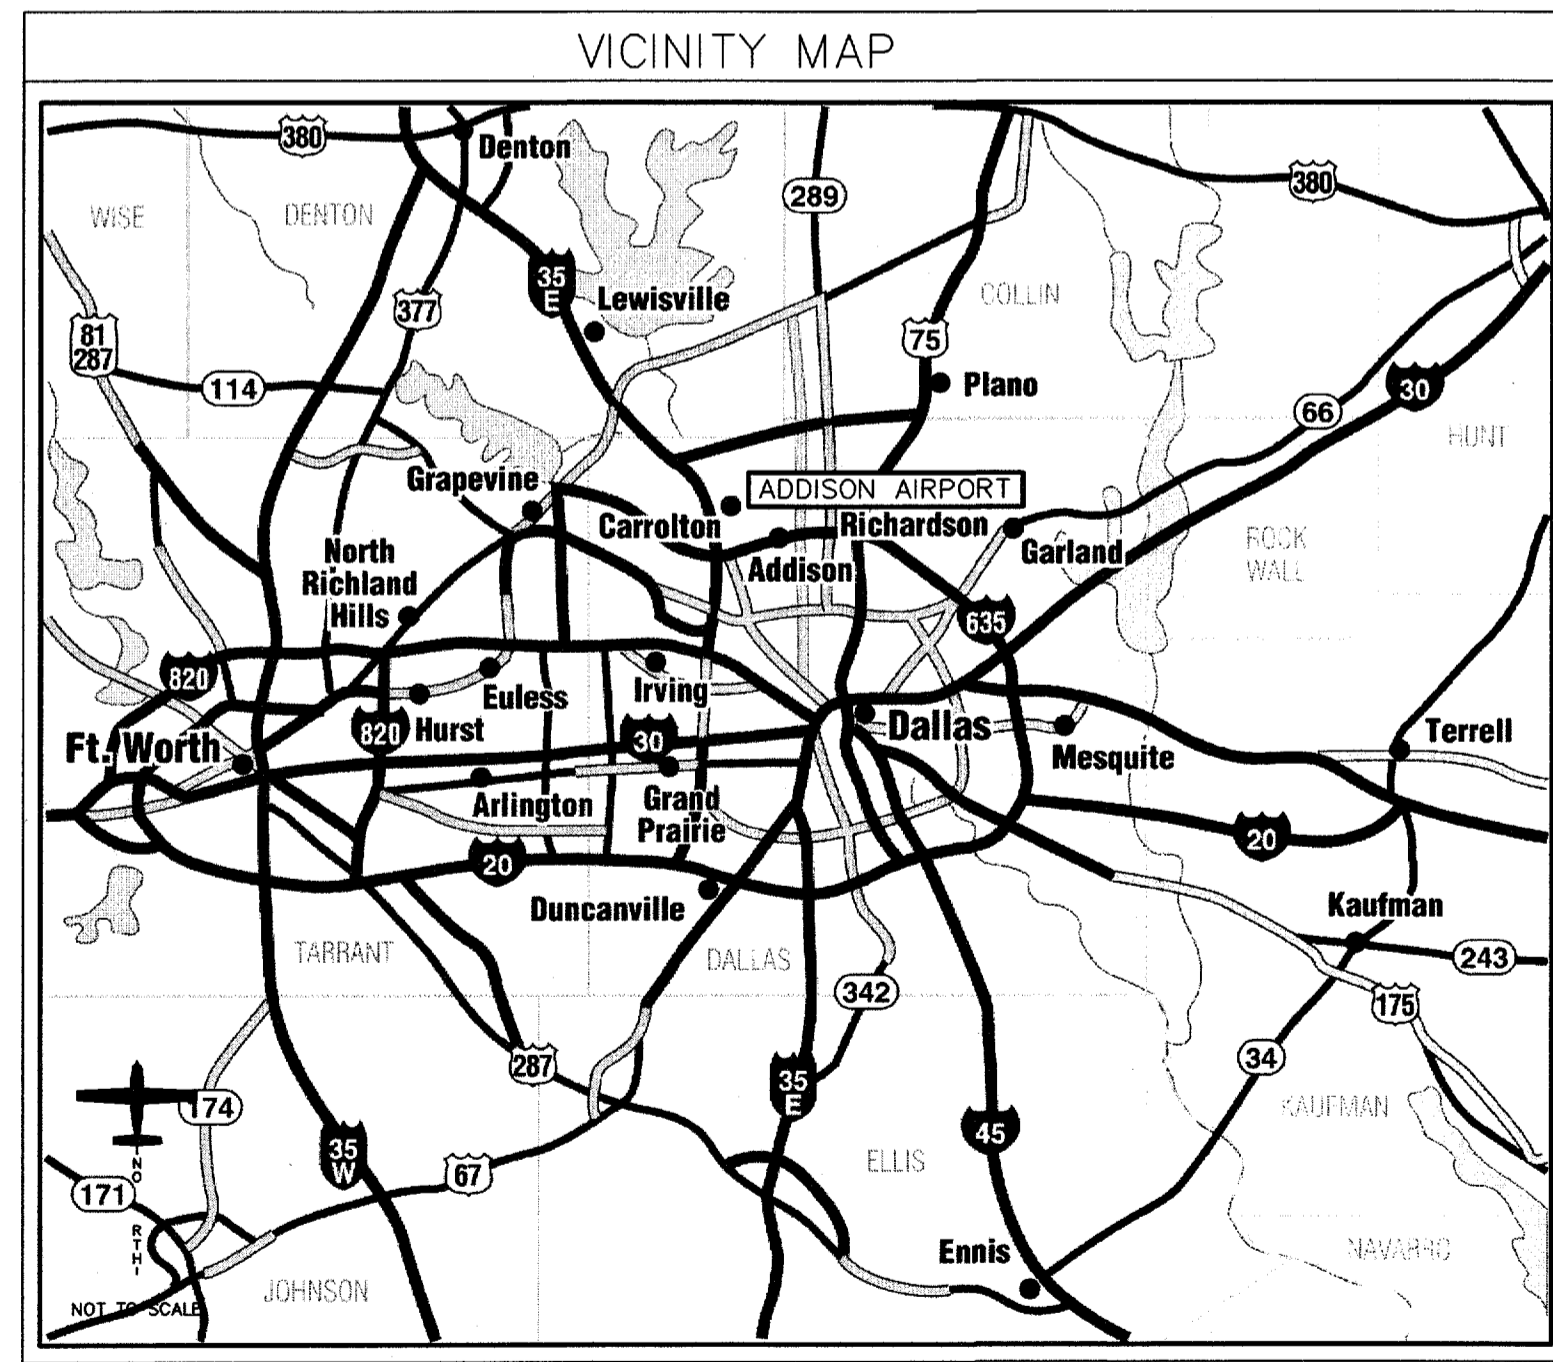

NO.		REVISIONS		BY	CHK'D	DATE
<p>TEXAS DEPARTMENT OF TRANSPORTATION AVIATION DIVISION</p> <p><input type="checkbox"/> ALP APPROVED ACCORDING TO FAA AC 150/5300-13 CH 7 PLUS THE REQUIREMENTS OF A FAVORABLE ENVIRONMENTAL FINDING PRIOR TO THE START OF ANY LAND ACQUISITION OR CONSTRUCTION AND AN FAA FORM 7460-1 SUBMITTED PRIOR TO ANY CONSTRUCTION ON AIRPORT PROPERTY</p> <p><input type="checkbox"/> ALP APPROVED ACCORDING TO FAA AC 150/5300-13 CH 7 PLUS THE CONDITIONS/COMMENTS IN LETTER DATED:</p>						
<p>DIRECTOR, AVIATION DIVISION</p> <p>DATE</p>				<p>AIRPORT SPONSOR</p> <p>CURRENT AND FUTURE DEVELOPMENT DEPICTED ON THIS ALP IS APPROVED AND SUPPORTED BY AIRPORT SPONSOR</p> <p>TITLE, AIRPORT SPONSOR'S REPRESENTATIVE</p> <p>SIGNATURE</p> <p>DATE</p>		
<p>PREPARED BY: 237 N.W. Blue Parkway Suite 100 Lee's Summit, Mo. 64083 816-524 (3500), Fax (2675) Coffman Phoenix Office: 4835 E. Cactus Road Suite 235 Scottsdale, Az. 85254 802-998 (6998), Fax (7198)</p>				<p>Coffman Associates Airport Consultants www.coffmanassociates.com</p>		
<p>DESIGNED BY <i>Mike W. Dmylenko</i> DATE 7/2/2004</p>				<p>DRAWN BY <i>Diana L. Hopkins</i> DATE 7/2/2004</p>		
<p>CHECKED BY <i>James M. Harris</i> DATE 7/2/2004</p>				<p>COVER ADDISON AIRPORT Addison, Texas</p>		

