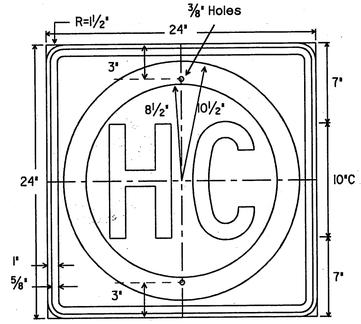

RI4-2
24" X 24"

Letters - Black
Border - Black
Ring - Green Reflective
Background - White Reflective

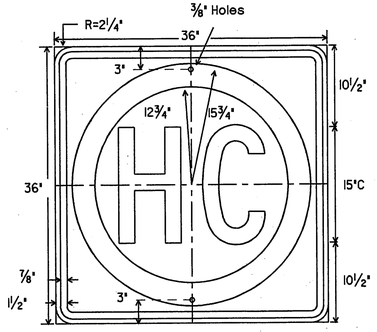

ERI4-2
36" X 36"

Letters - Black
Border - Black
Ring - Green Reflective
Background - White Reflective

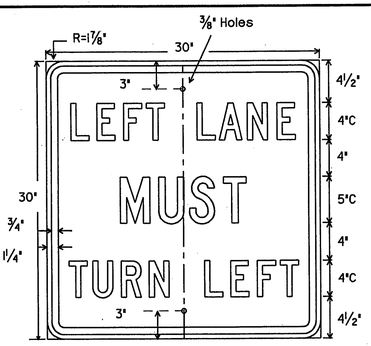

R3-7L
30" X 30"

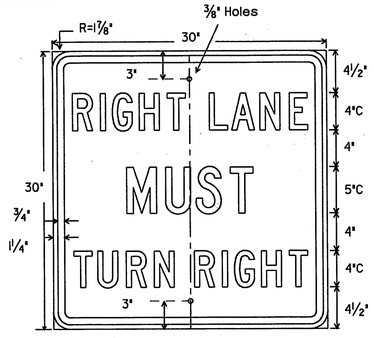

R3-7R
30" X 30"

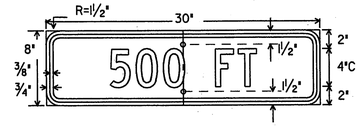

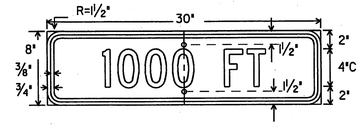

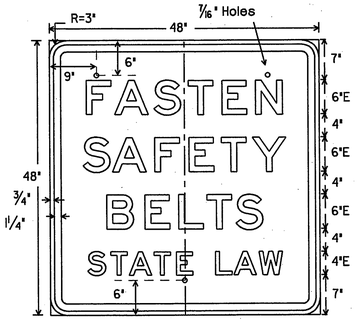

FRI9-8
48" X 48"

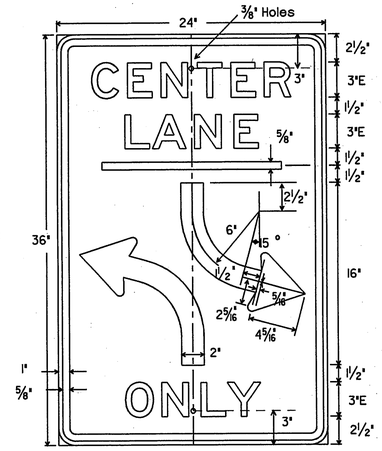

R3-9b
24" X 36"

SR3-4
48" X 48"

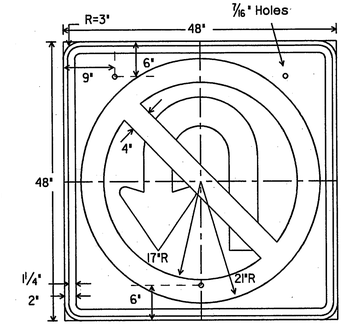

Letters - Black
Arrow - Black
Border - Black
Circle & Diagonal - Red Reflective
Background - White Reflective

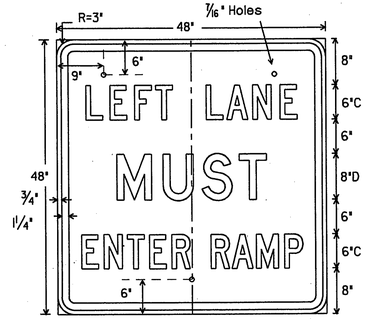

R3-20
48" X 48"

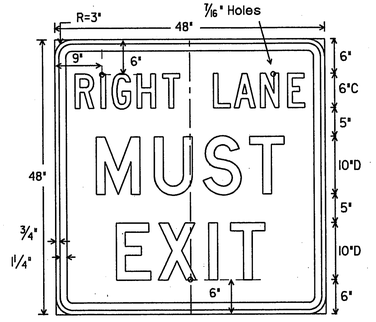

R3-2IR
48" X 48"

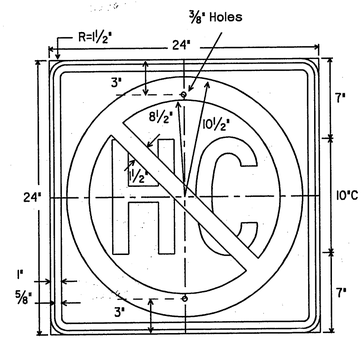

RI4-3
24" X 24"

Letters - Black
Border - Black
Ring/Slash - Red Reflective
Background - White Reflective

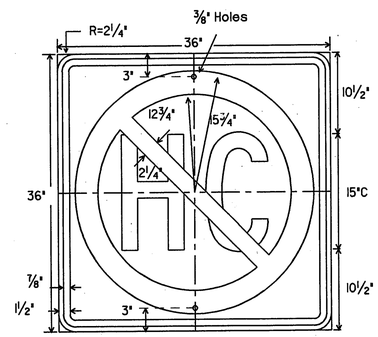

ERI4-3
36" X 36"

Letters - Black
Border - Black
Ring/Slash - Red Reflective
Background - White Reflective

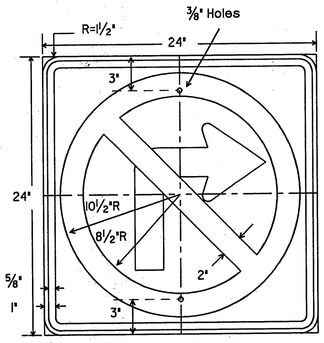

R3-1
24" X 24"

Letters - Black
Arrow - Black
Border - Black
Circle & Diagonal - Red Reflective
Background - White Reflective

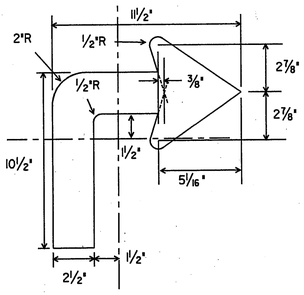

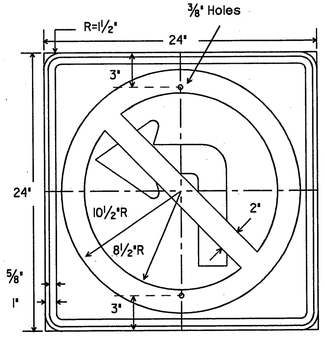

R3-2
24" X 24"

Letters - Black
Arrow - Black
Border - Black
Circle & Diagonal - Red Reflective
Background - White Reflective

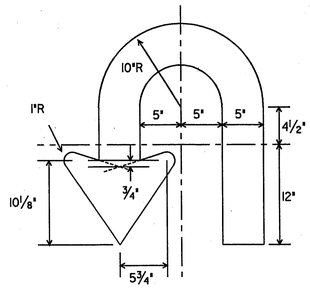

SPECIFICATION REFERENCE TABLE

MATERIALS AND TESTS DIVISION SPECIFICATIONS	
ALUMINUM SIGN BLANKS	D-9-7110 △
REFLECTIVE SHEETING,	
TYPE A (ENGINEER GRADE)	D-9-8300
TYPE C (HIGH SPECIFIC INTENSITY)	D-9-8300
VINYL NON-REFLECTIVE DECAL SHEETING	D-9-8320

GENERAL NOTES:

The alphabets and lateral spacing between letters and numerals shall conform with the Texas 'Manual on Uniform Traffic Control Devices for Streets and Highways', latest edition, and any approved changes thereto. Lateral spacing of text shall provide a balanced appearance. All materials shall conform to Department Specifications.

Legend (except where noted), shall be applied by screening process of black and/or transparent colored ink, cut-out black vinyl non-reflective decal sheeting and/or reflective sheeting or combination thereof. Background shall be white reflective sheeting (Type A). RI4-2, ERI4-2, RI4-3, ERI4-3, R3-1, R3-2 and SR3-4 signs shall use reflective sheeting (Type C).

Sign blanks shall be one piece 0.080 inch thick sheet aluminum alloy △ (Type A), unless otherwise noted elsewhere in the plans.

FINAL RECORD DRAWING
Date: 12/25/99

ISSUE DATE: 11-26-96

STATE OF TEXAS
GLENN D. HOUSER
24236
REGISTERED PROFESSIONAL ENGINEER
Glenn D. Houser
4-14-97

STANDARD PLANS
TEXAS DEPARTMENT OF TRANSPORTATION
Traffic Operations Division

REGULATORY SIGNS

R(3)-95 (MOD.)

ORIG DRAW DATE:	DN:	CK:	DW:	CK:	NEG NO.:
JULY 1990	LR		DN		

REVISIONS	STATE DISTRICT	FEDERAL REGION	FEDERAL AID PROJECT	SHEET
8-95		6		39
11-96 △	COUNTY	CONTROL	SECTION	JOB	HIGHWAY

7C

LEVELS DISPLAYED

1	2	3	4	5	6	7	8	9	10	11	12	13	14	15	16
17	18	19	20	21	22	23	24	25	26	27	28	29	30	31	32
33	34	35	36	37	38	39	40	41	42	43	44	45	46	47	48
49	50	51	52	53	54	55	56	57	58	59	60	61	62	63	

DATE:
ACC: d58hplc/usr/d580504
FILE:
DN:LR
CK:CW
DW:DN
CK:MT