

BASE BID (RICHARD BYRD NORTH, TAXIWAY "P", TAXIWAY "Q")			
ITEM NO.	DESCRIPTION	UNIT	QTY.
1	MOBILIZATION	LS	1
2	MAINTENANCE OF TRAFFIC	LS	1
3	UNCLASSIFIED EXCAVATION	SY	8,593
4	SOLID YELLOW TAXIWAY CENTERLINE MARKING	LF	7,670
5	NON-MOVEMENT AREA MARKING	LF	110
6	DASHED TAXIWAY EDGE LINE	LF	567
7	CONTINUOUS TAXIWAY EDGE LINE MARKING	LF	613
8	PAVEMENT MILLING VARIABLE DEPTH	SY	2,382
9	2" TYPE "D" HMAC (PG 76-22)	SY	19,565
10	3" TYPE "D" HMAC (PG 76-22)	SY	1,350
11	3" TYPE "B" HMAC	SY	8,593
12	4" TYPE "D" HMAC (PG 76-22)	SY	828
13	FLEXIBLE BASE MATERIAL	CY	2,149
14	FULL DEPTH 10" TYPE "B" HMAC PAVEMENT REPAIR	SY	100
15	FABRIC UNDERSEAL	SY	4,636
16	10" CEMENT TREATED BASE MATERIAL (ROAD MIXED)	SY	8,374
17	TACK COAT	GAL	860
18	PRIME COAT	GAL	2,545
19	PREPARATION AND IMPLEMENTATION OF SWPPP PER SPECIFICATIONS AND TCEQ REQUIREMENTS	LS	1
20	SW3P - INLET PROTECTION	EA	4
21	SILT FENCE	LF	204
22	COMPOST MULCH SOCK	LF	194

← BARRICADES

SHEET NO.	INDEX OF SHEETS
2	COVER SHEET / LOCATION MAP
3	SHEET INDEX / QUANTITIES
4-6	PROJECT LAYOUT / SURVEY CONTROL
GENERAL NOTES	
RICHARD BYRD DRIVE NORTH	
7-9	PHASING PLAN
10-12	REMOVAL PLANS
13-15	PAVING PLANS
16-18	GRADING PLANS
19	STORM WATER POLLUTION PREVENTION PLAN
TAXIWAY "Q"	
20-21	PAVING PLANS
TAXIWAY "R"	
22	PHASING PLAN
23	PAVING PLAN
24	STORM WATER POLLUTION PREVENTION PLAN
TAXIWAY "P"	
25-28	PHASING PLAN
29-32	PAVING PLANS
33	STORM WATER POLLUTION PREVENTION PLAN
34-35	MISCELLANEOUS DETAILS
36	STORMWATER POLLUTION PREVENTION NOTES


ALTERNATE BID (TAXIWAY "R")			
ITEM NO.	DESCRIPTION	UNIT	QTY.
ALT 1	SOLID YELLOW TAXIWAY CENTERLINE MARKING	LF	861
ALT 2	PAVEMENT MILLING VARIABLE DEPTH	SY	725
ALT 3	2" TYPE "D" HMAC (PG 76-22)	SY	7,264
ALT 4	FULL DEPTH 10" TYPE "B" HMAC PAVEMENT REPAIR	SY	1,090
ALT 5	FABRIC UNDERSEAL	SY	7,624
ALT 6	PREPARATION AND IMPLEMENTATION OF SWPPP PER SPECIFICATIONS AND TCEQ REQUIREMENTS	LS	1
ALT 7	SW3P - INLET PROTECTION	EA	2
ALT 8	SILT FENCE	LF	353

MC/10
890 + o/sa mes NOT full depth

- NONE AS OF 4/19

27-DEC-2005 15:43 G:\11308\Code\Sheets\rbnqt-ASHPAL.T.dgn

NO.	DATE	REVISION	APPROV.	NO.	DATE	REVISION	APPROV.

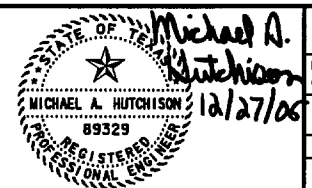

HNTB
HNTB Corporation
The HNTB Companies
Engineers Architects Planners

DESIGN CHECK: DEC MAH
DRAWN CHECK: CCH DEC
DATE: DEC. 2005
SCALE:

PROJECT NO. 41308



TOWN OF ADDISON		SHEET
ADDISON AIRPORT ASPHALT PAVEMENT IMPROVEMENTS		2 OF 36
SHEET INDEX / QUANTITIES		
TOWN OF ADDISON, TEXAS		2