


File: L:\2011\11081100 - ADS Taxiway Alpha Improvements\Drawings\ADS\_SAHB\_C406\_WL.dwg Last Saved: 11/26/2012 2:07 PM Last saved by: Mirmcconally  
 Plot Date: 11/26/2012 2:07 PM Plotter used: \\gtyvaca02\Canon IR C4080 PS  
 Plot Style: Garver\_Standard Hair.ctb Plot Scale: 1:2 Plot Date: 11/26/2012 2:07 PM



REGISTRATION NO. F-5713

THIS DOCUMENT IS RELEASED FOR THE PURPOSE OF INTERIM REVIEW UNDER THE AUTHORITY OF FRANK O. McILLWAIN, P.E. 93229 ON 11/26/2012. IT IS NOT TO BE USED FOR CONSTRUCTION, BIDDING, OR PERMIT PURPOSES.

REV.	DATE	DESCRIPTION	BY
1	8/6/12	ADDENDUM NO. 1	FOM
2	11/6/12	CHANGE ORDER NO. 1	FOM
3	11/20/12	WALL PLAN REVISION	FOM
4	11/29/12	CHANGE ORDER NO. 2	FOM

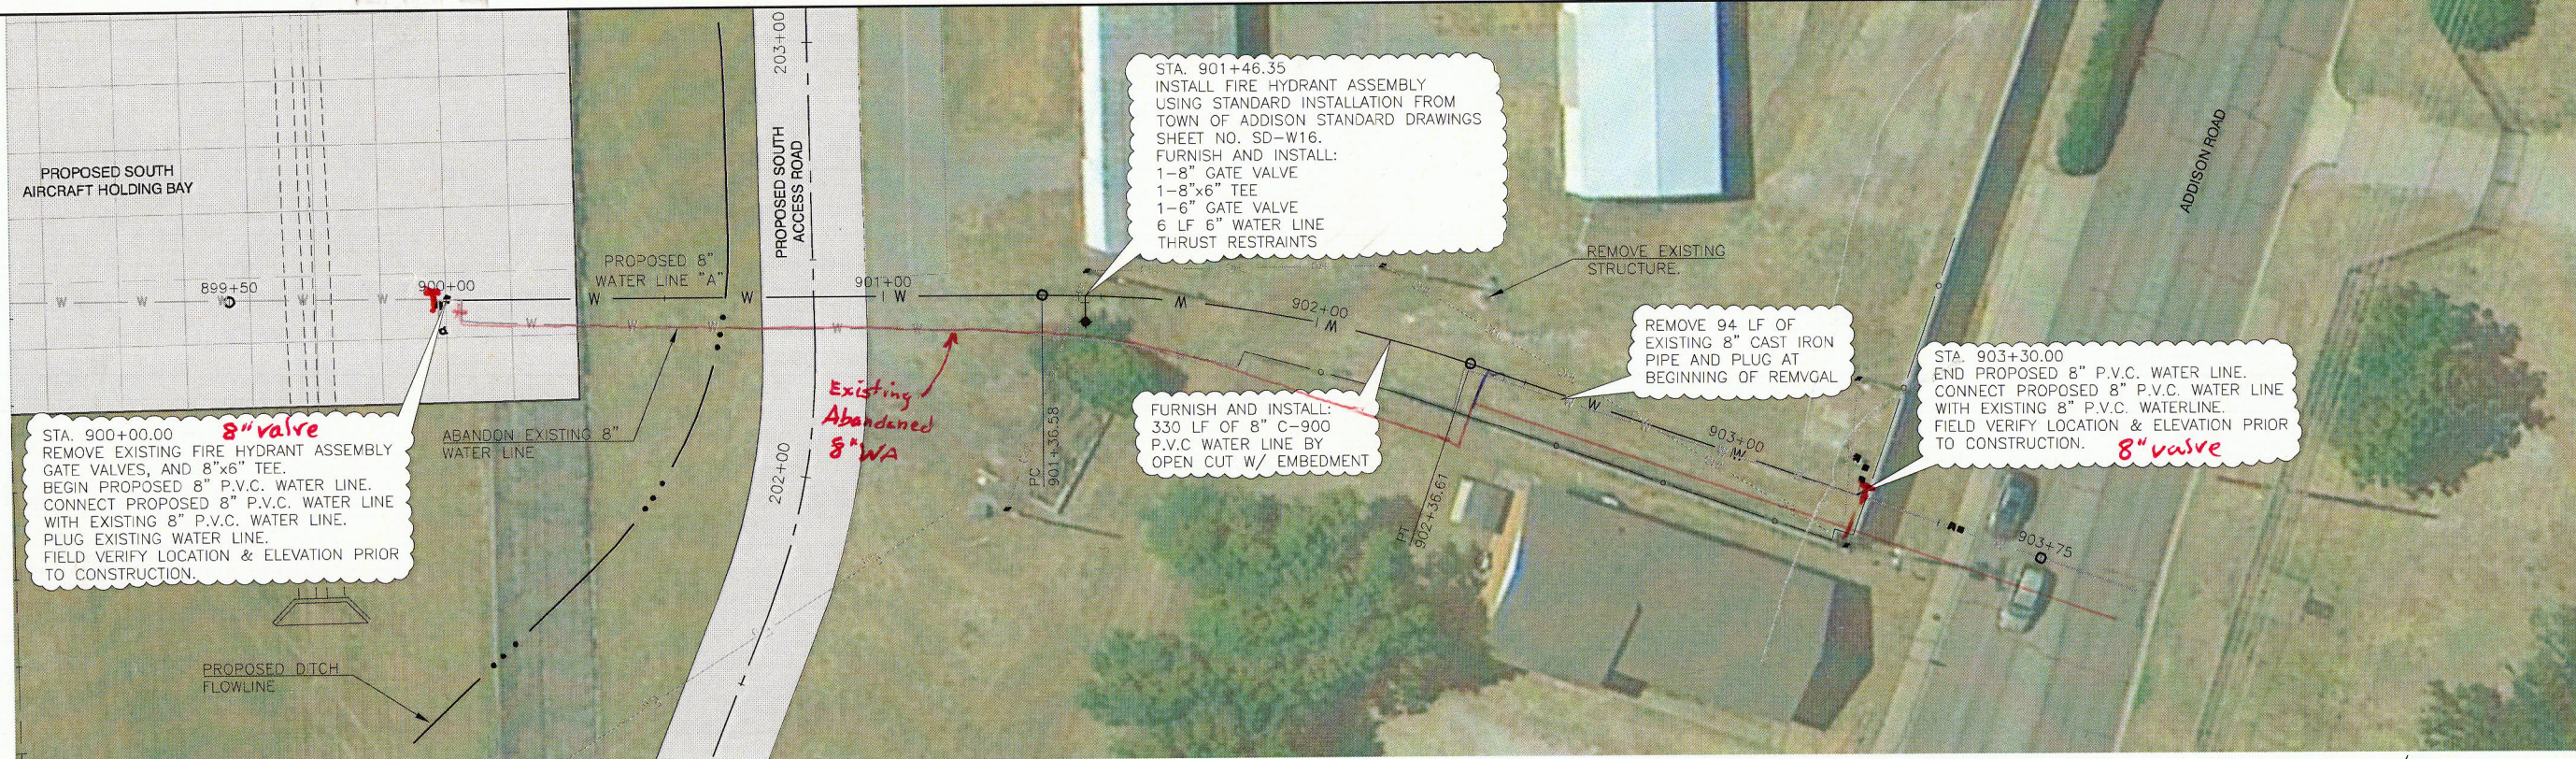


**WATER LINE CURVE DATA**

DESCRIPTION	STA.	NORTHING	EASTING	RADIUS	LENGTH	DELTA
WATER LINE "A"						
POB	899+50.00	7036984.05	2480644.62			
PC	901+36.58	7037048.30	2480819.79			
PI	901+87.06	7037065.68	2480867.18	300.00	100.03	19°06'17" R
PT	902+36.61	7037065.59	2480917.66			
POE	903+75.00	7037069.10	2481056.03			

GENERAL NOTES:  
 SEE TOWN OF ADDISON WATER SYSTEM REQUIREMENTS FOR MATERIAL AND CONSTRUCTION REQUIREMENTS.  
 SEE NCTCOG SPECIFICATIONS FOR METHOD OF MEASUREMENT AND PAYMENT.

CAUTION: UNDERGROUND UTILITIES EXIST WITHIN AND ADJACENT TO THE LIMITS OF CONSTRUCTION. AN ATTEMPT HAS BEEN MADE TO LOCATE THESE UTILITIES ON THE PLANS. HOWEVER, ALL EXISTING UTILITIES MAY NOT BE SHOWN AND THE ACTUAL LOCATIONS OF THE UTILITIES MAY VARY FROM THE LOCATIONS SHOWN. PRIOR TO BEGINNING ANY TYPE OF EXCAVATION, THE CONTRACTOR SHALL CONTACT THE UTILITIES INVOLVED AND MAKE ARRANGEMENTS FOR THE LOCATION OF THE UTILITIES ON THE GROUND. THE CONTRACTOR SHALL MAINTAIN THE UTILITY LOCATION MARKINGS UNTIL THEY ARE NO LONGER NECESSARY.

TEXAS STATE LAW, THE UNDERGROUND FACILITIES DAMAGE PREVENTION ACT, REQUIRES TWO WORKING DAYS ADVANCE NOTIFICATION THROUGH THE TEXAS ONE-CALL SYSTEM CENTER BEFORE EXCAVATING USING MECHANIZED EQUIPMENT OR EXPLOSIVES (EXCEPT IN THE CASE OF AN EMERGENCY). THE ONE-CALL SYSTEM PHONE NUMBER IS 1-800-245-4545. THE CONTRACTOR IS ADVISED THAT THERE IS A SEVERE PENALTY FOR NOT MAKING THIS CALL. NOT ALL UTILITY COMPANIES ARE MEMBERS OF THE TEXAS ONE-CALL SYSTEM; THEREFORE, THE CONTRACTOR IS ADVISED TO CONTACT ALL NON-MEMBER UTILITIES AS WELL AS THE ONE-CALL SYSTEM.

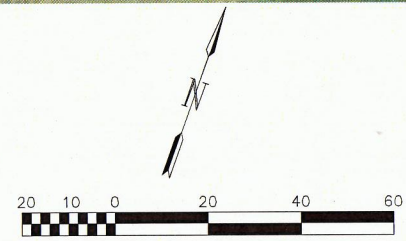

ADDISON AIRPORT  
ADDISON, TX

TAXIWAY ALPHA IMPROVEMENTS

SOUTH AIRCRAFT HOLDING BAY - SOUTH WATER LINE PLAN & PROFILE

JOB NO.: 11081100  
DATE: FEB., 2012  
DESIGNED BY: MRM  
DRAWN BY: BMN

BAR IS ONE INCH ON ORIGINAL DRAWING  
IF NOT ONE INCH ON THIS SHEET, ADJUST SCALES ACCORDINGLY.

SHEET NUMBER

**C-406**

.pdf 11/19/13