
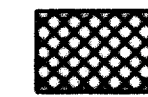
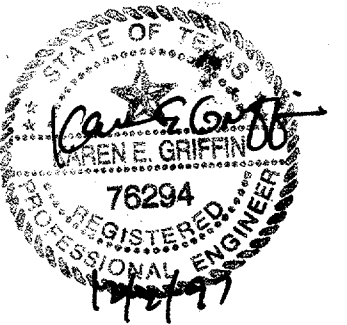
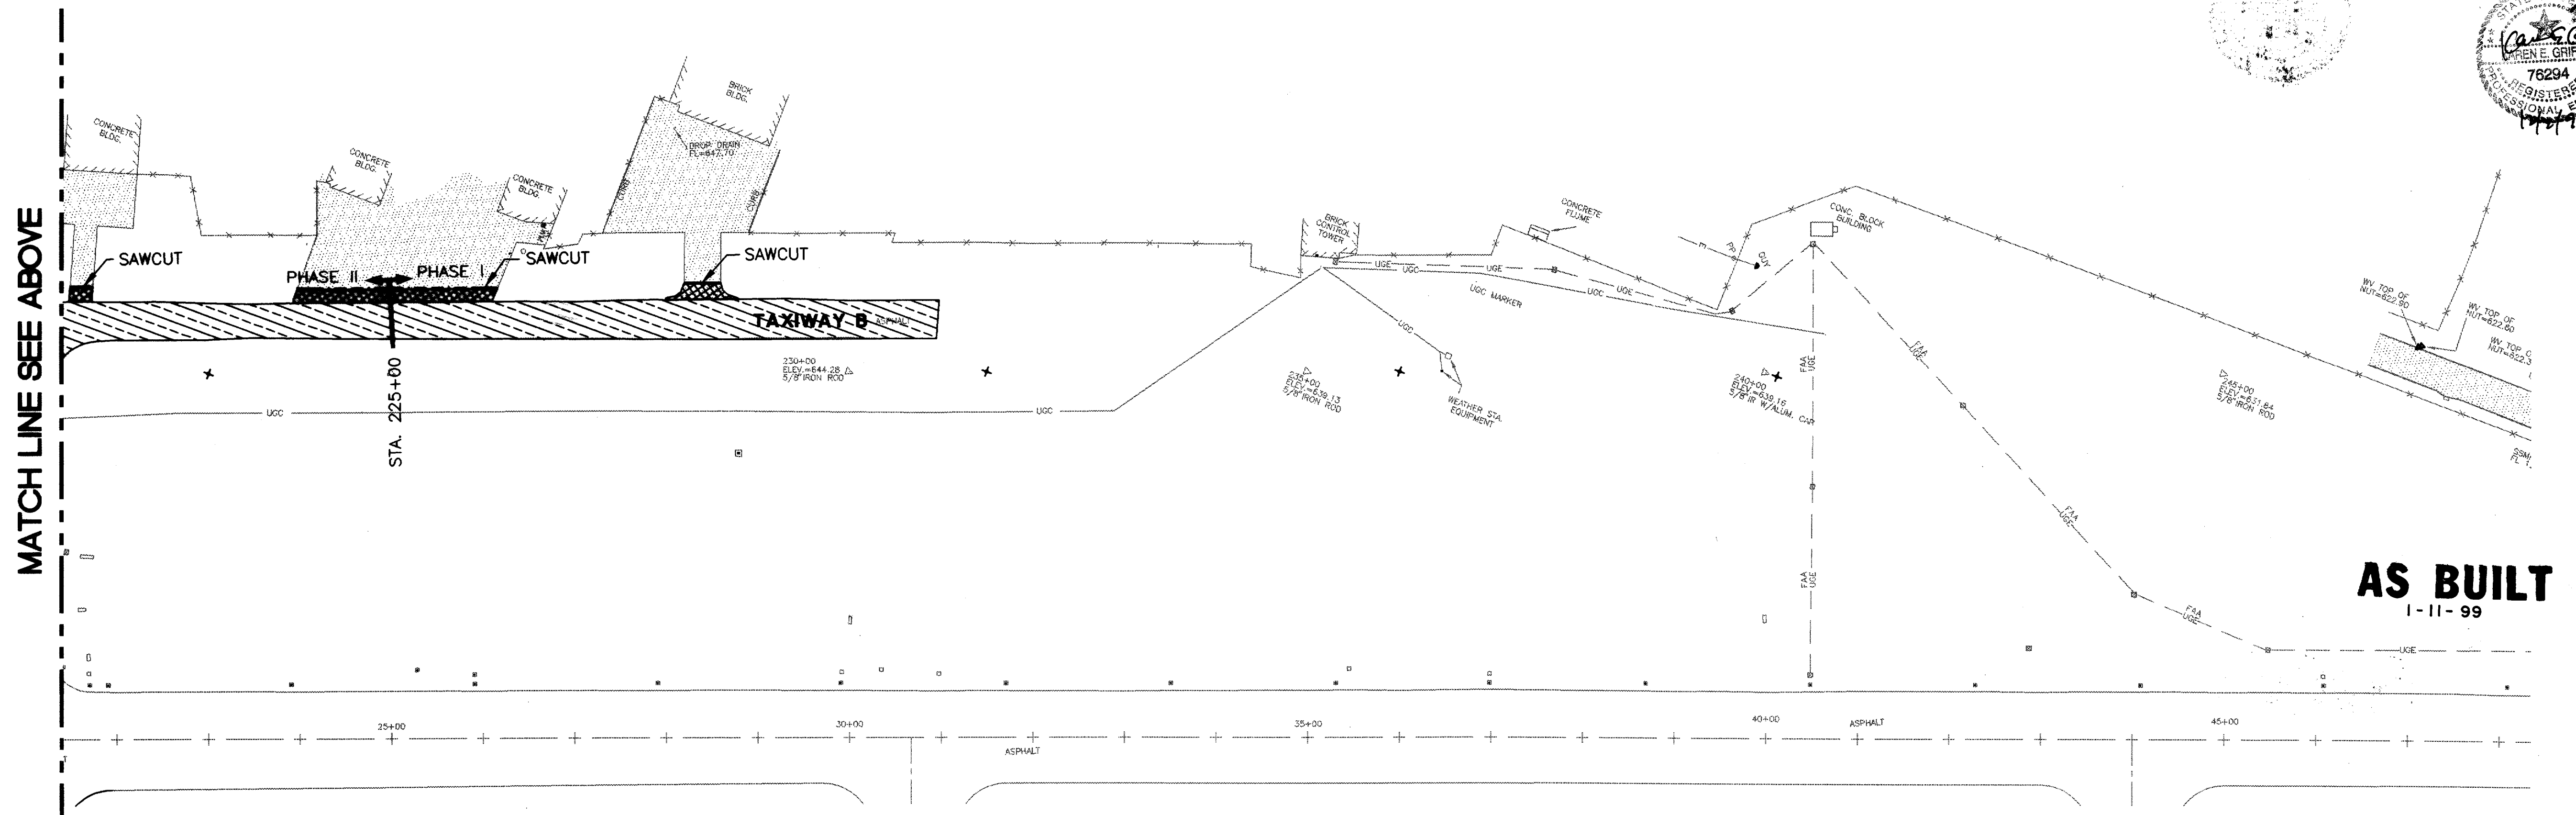
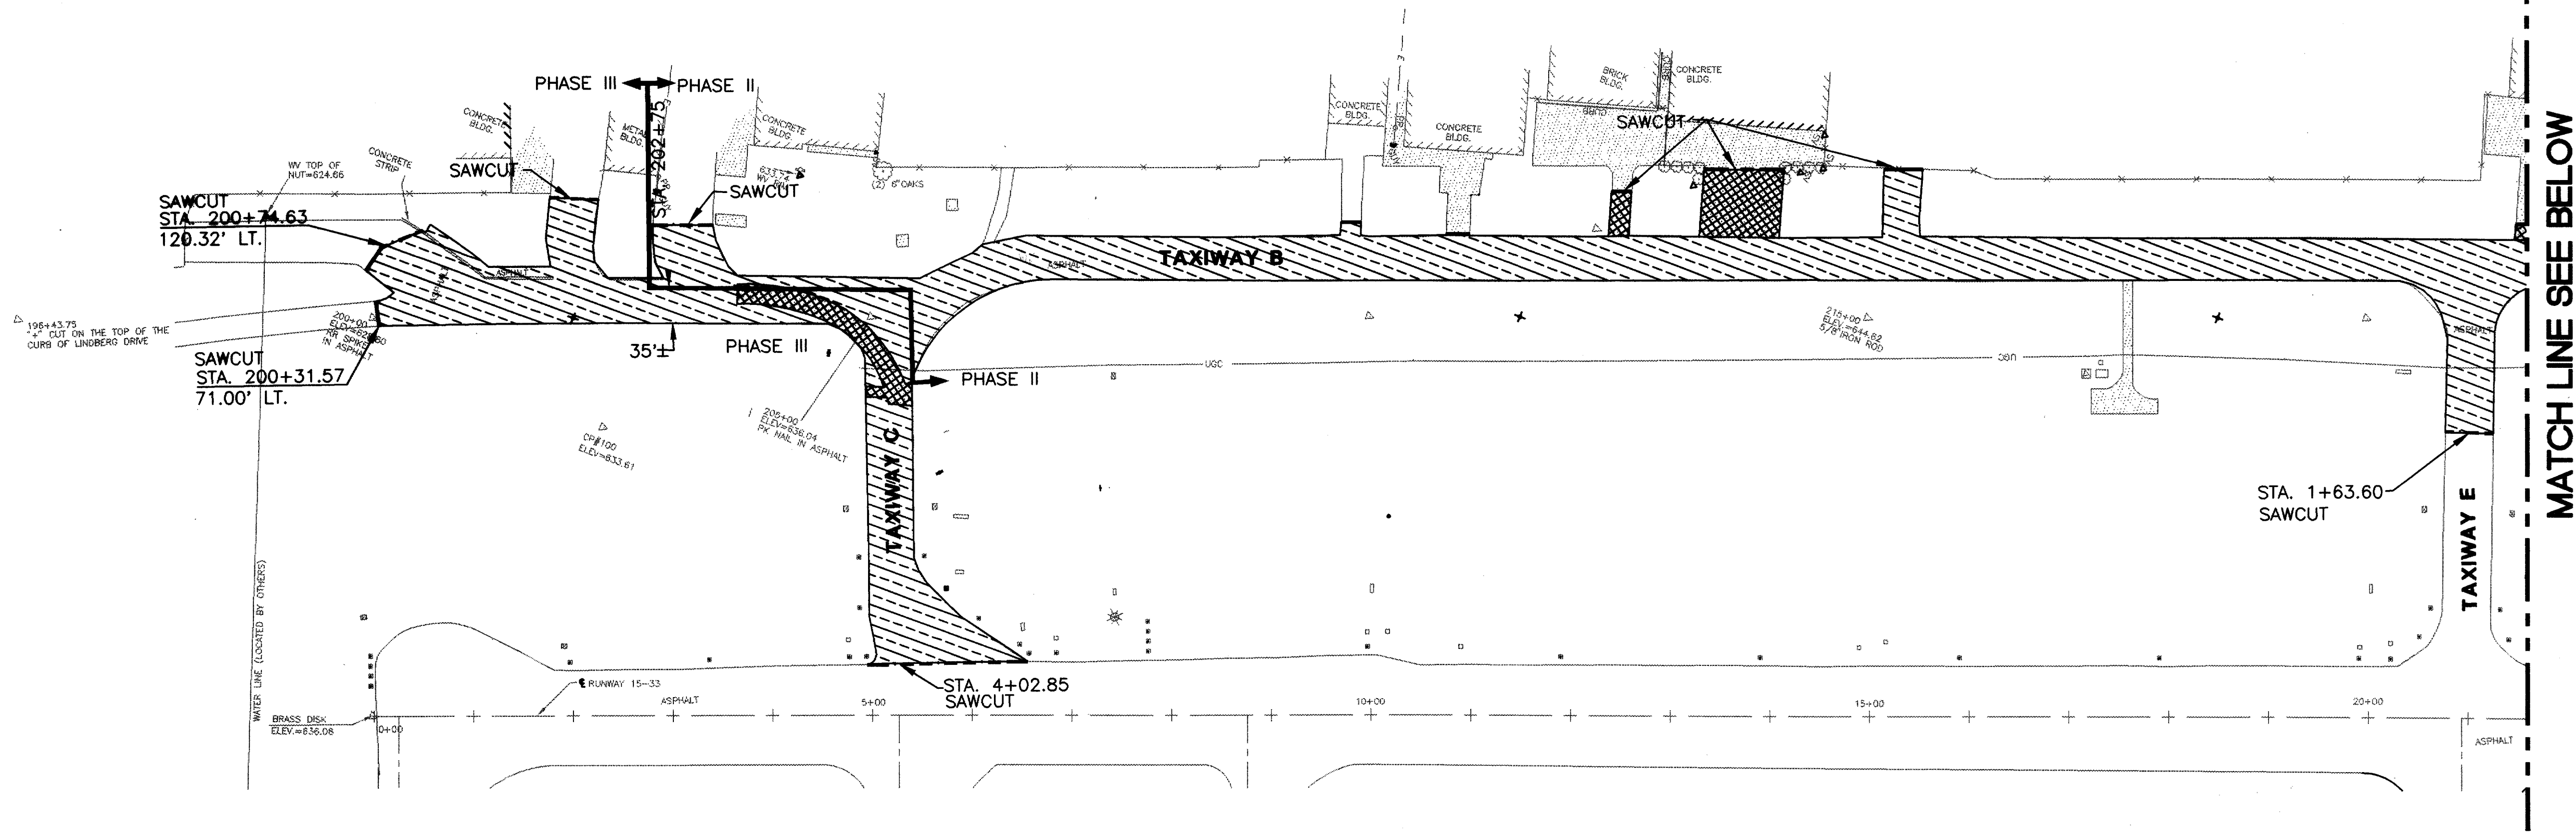
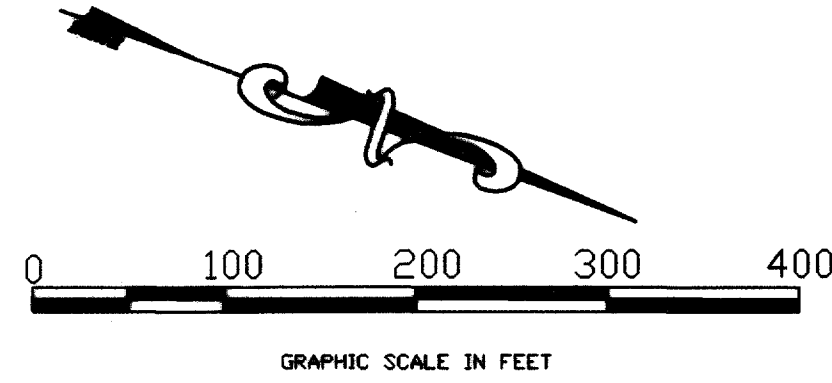


NOTES

SEE DRAWINGS 11-13 FOR DRIVEWAY DEMOLITION LIMITS

LEGEND

-  REMOVE EXIST. ASPHALT PAVEMENT
-  REMOVE EXIST. PCC PAVEMENT



DESIGN: T.L.T.	TXDOT NO: 9842 ADDSN
DRAWN: M.J.G.	BID NO: 98-04
CHECKED: R.B.	JOB NO: E708024.80
SCALE: HORIZ. 1"=50'	
VERT. 1"=5'	

Date	Revisions	By

URS Greiner
 4100 Aron Carter Blvd., Suite 108
 Fort Worth, TX 76155
 (817) 545-0891

Engineers, Architects
 and Planners



ADDISON AIRPORT

**WEST TAXIWAY "B" PLAN AND PROFILE
 PAVEMENT DEMOLITION PLAN**