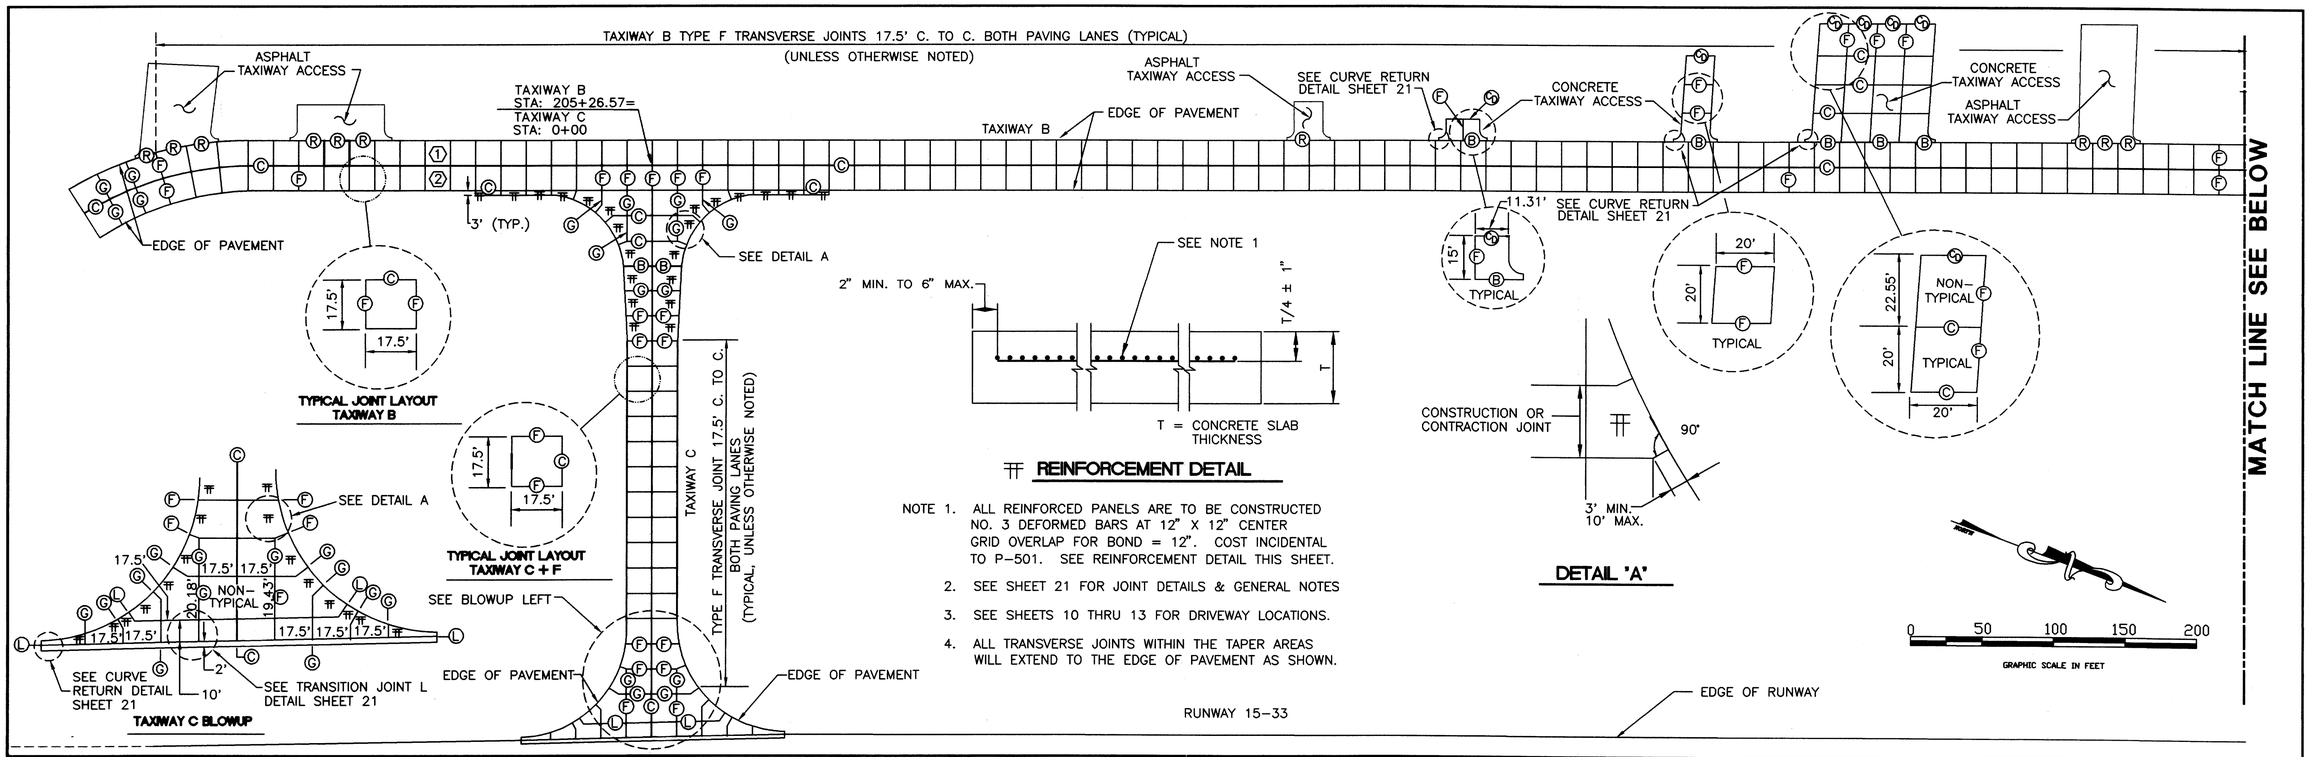

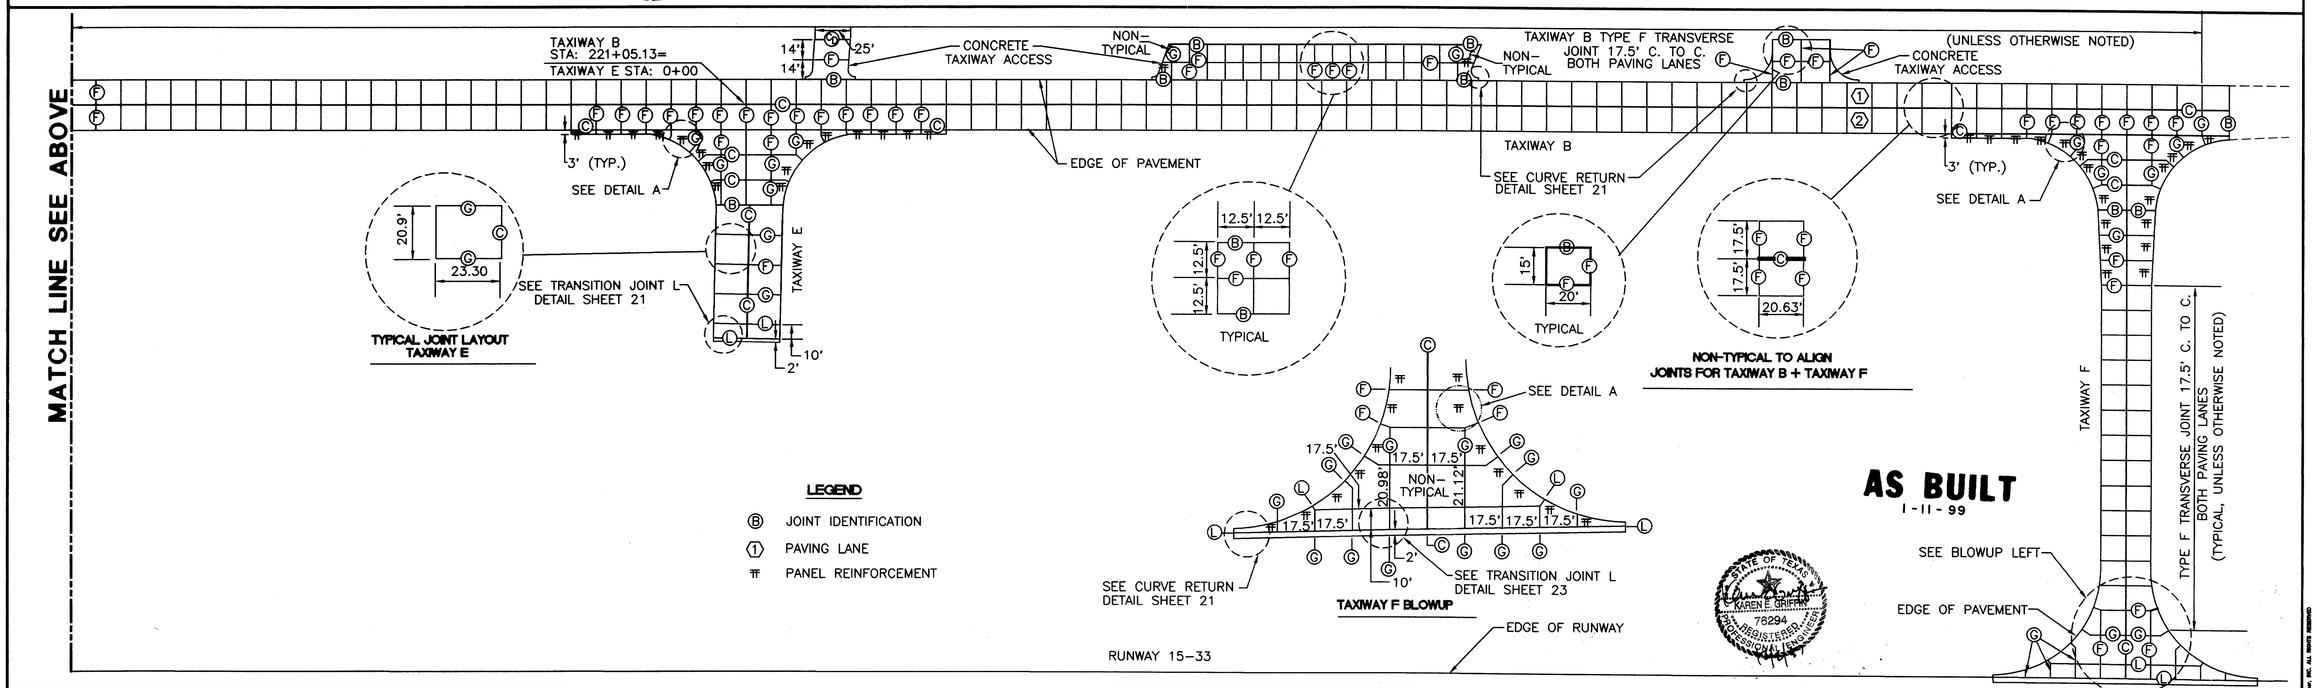

DESIGN: T.L.T. DRAWN: J.R.H. CHECKED: R.I.B. SCALE: 1"=50'	TXDOT NO. 9842 ADDSN BID NO. 98-04 JOB NO. E708024.80	Date / Revisions / By	URS Greiner 4100 Amon Carter Blvd., Suite 108 Fort Worth, TX 76155 (817) 545-0891	Engineers, Architects and Planners	ADDISON AIRPORT — JOINT LAYOUT PLAN

SHEET 20
DATE: DEC. 1997

COPYRIGHT © 1997 URS Greiner, INC. ALL RIGHTS RESERVED