
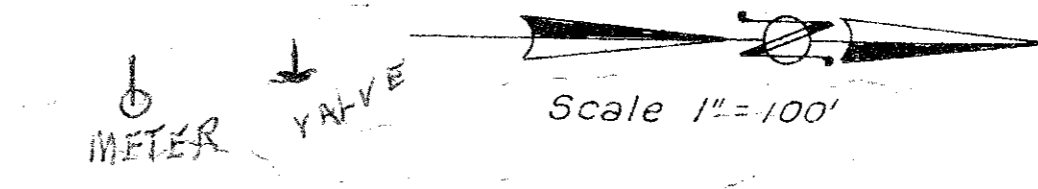


ROAD

DOOLEY

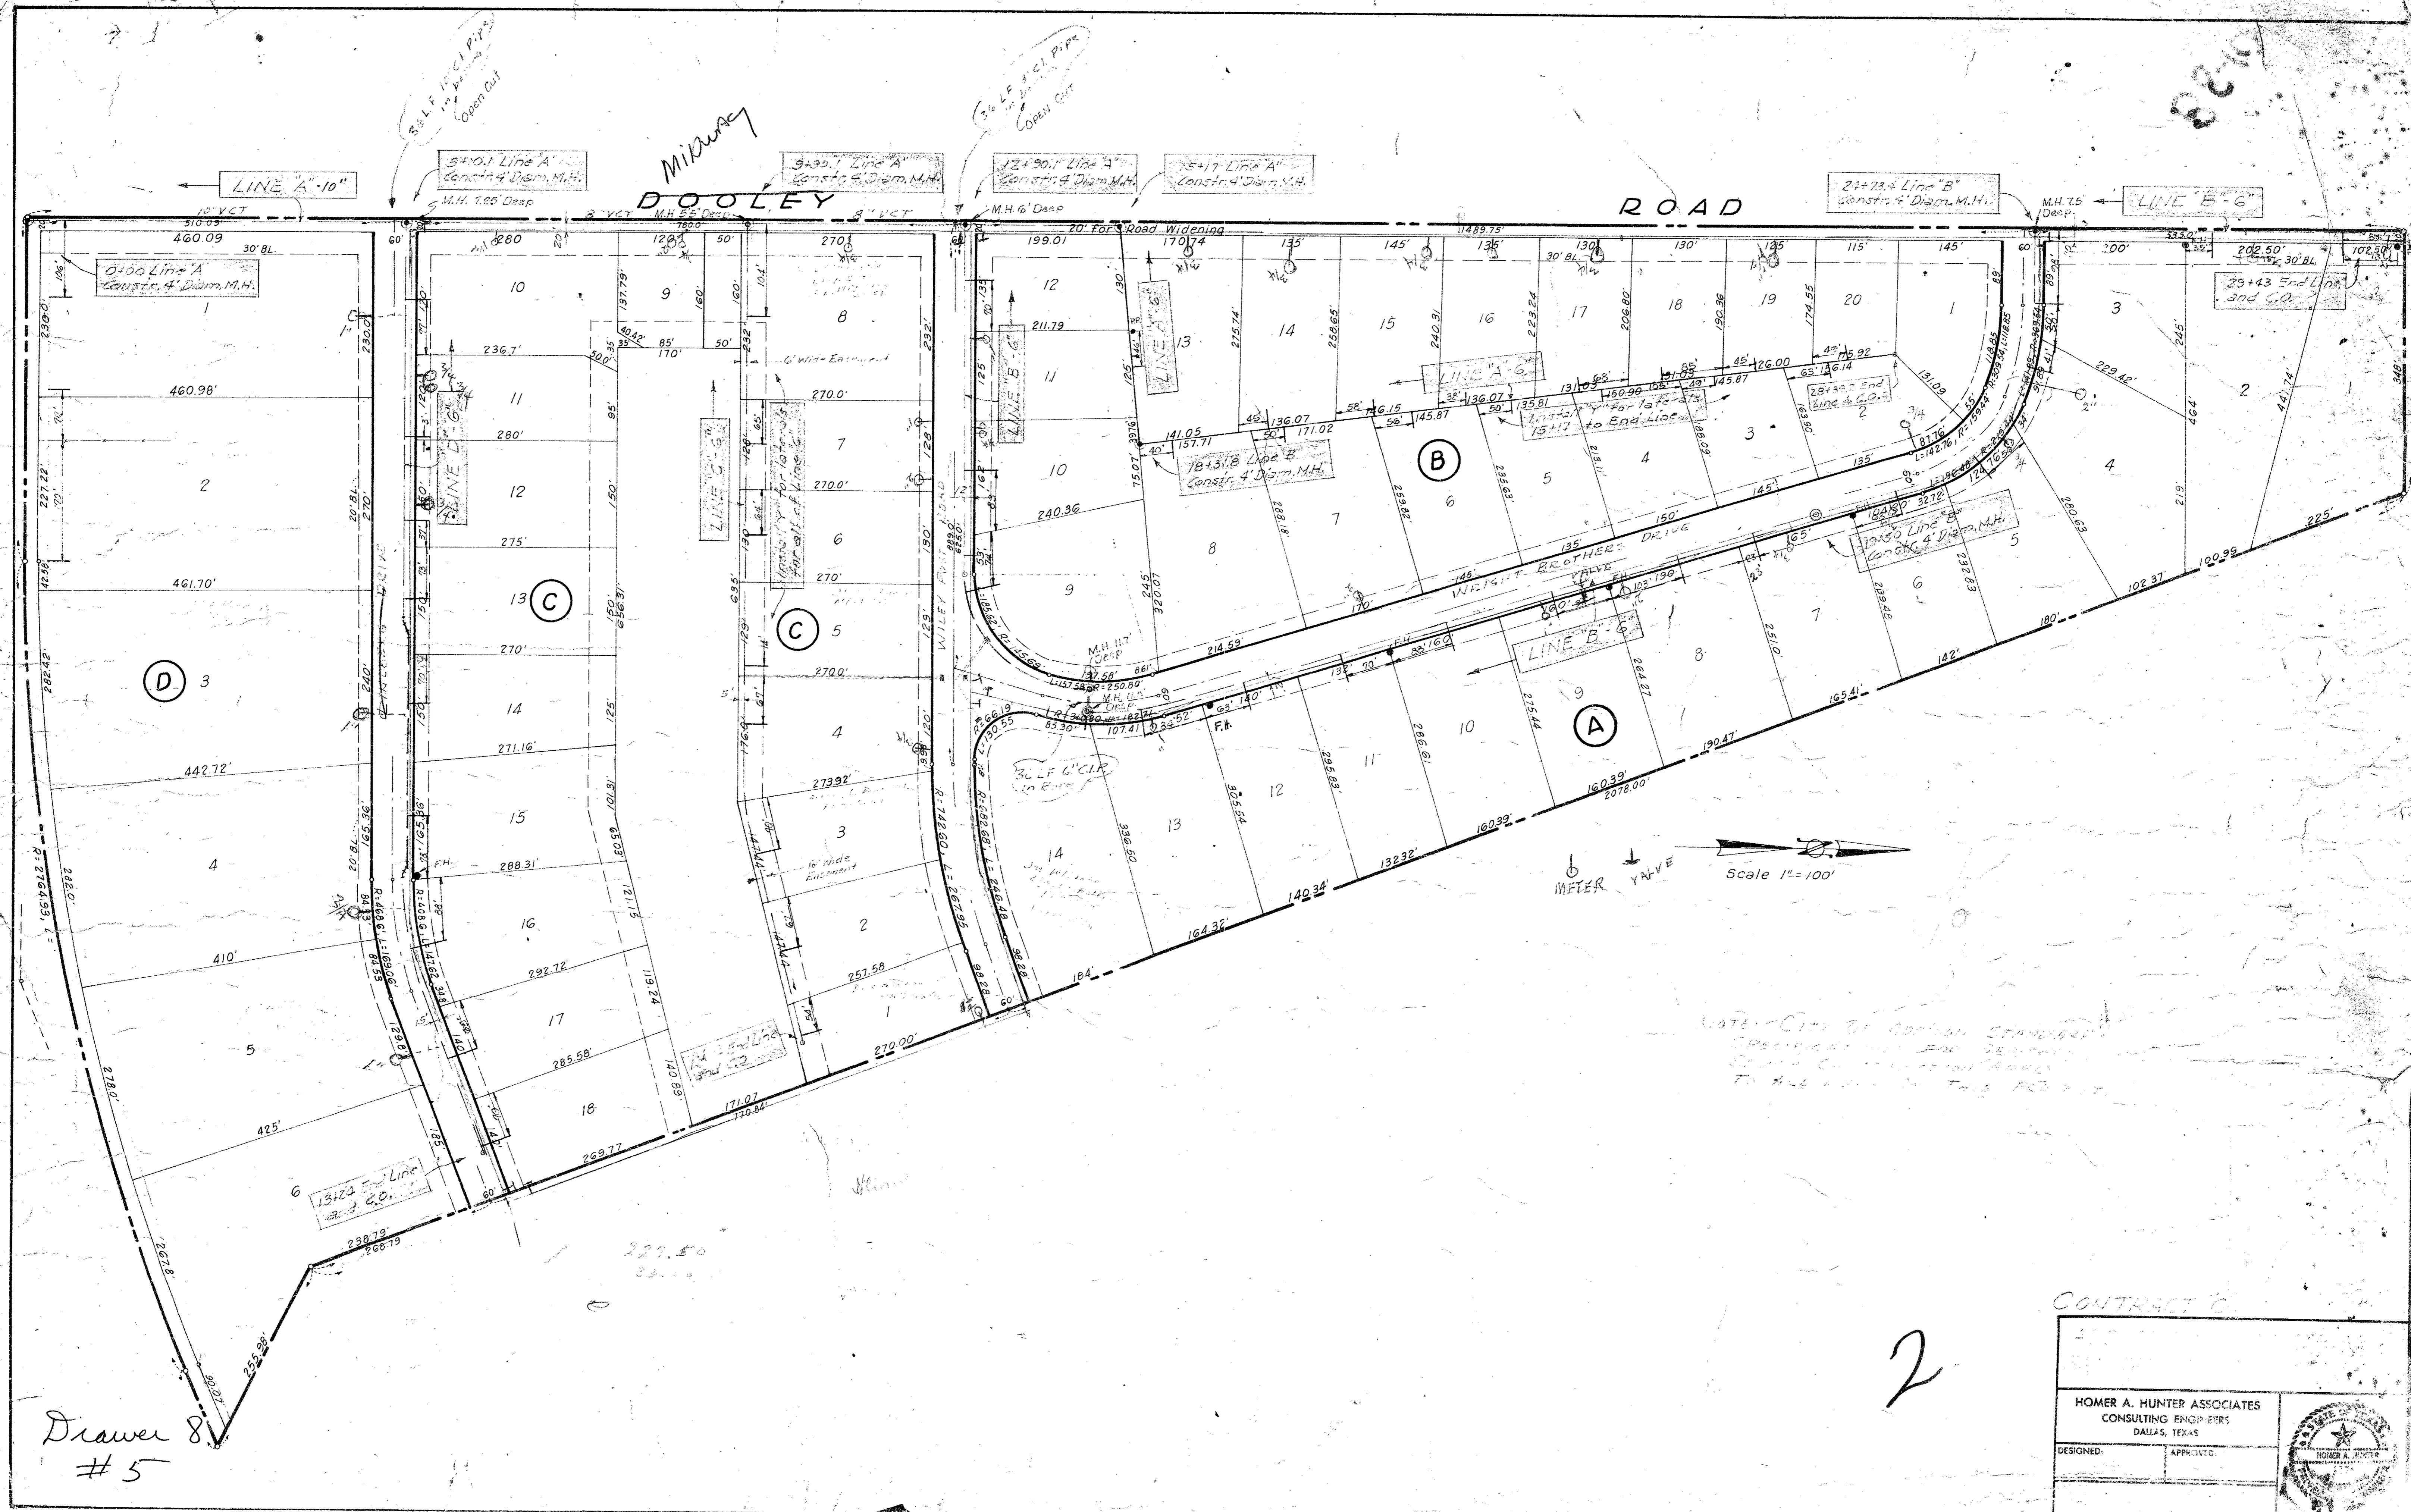


Drawer 8  
#5

CONTRACT NO.

2

|   |           |  |
|---|-----------|--|
| HOMER A. HUNTER ASSOCIATES<br>CONSULTING ENGINEERS<br>DALLAS, TEXAS |           |  |
| DESIGNED:   | APPROVED: |  |